


105

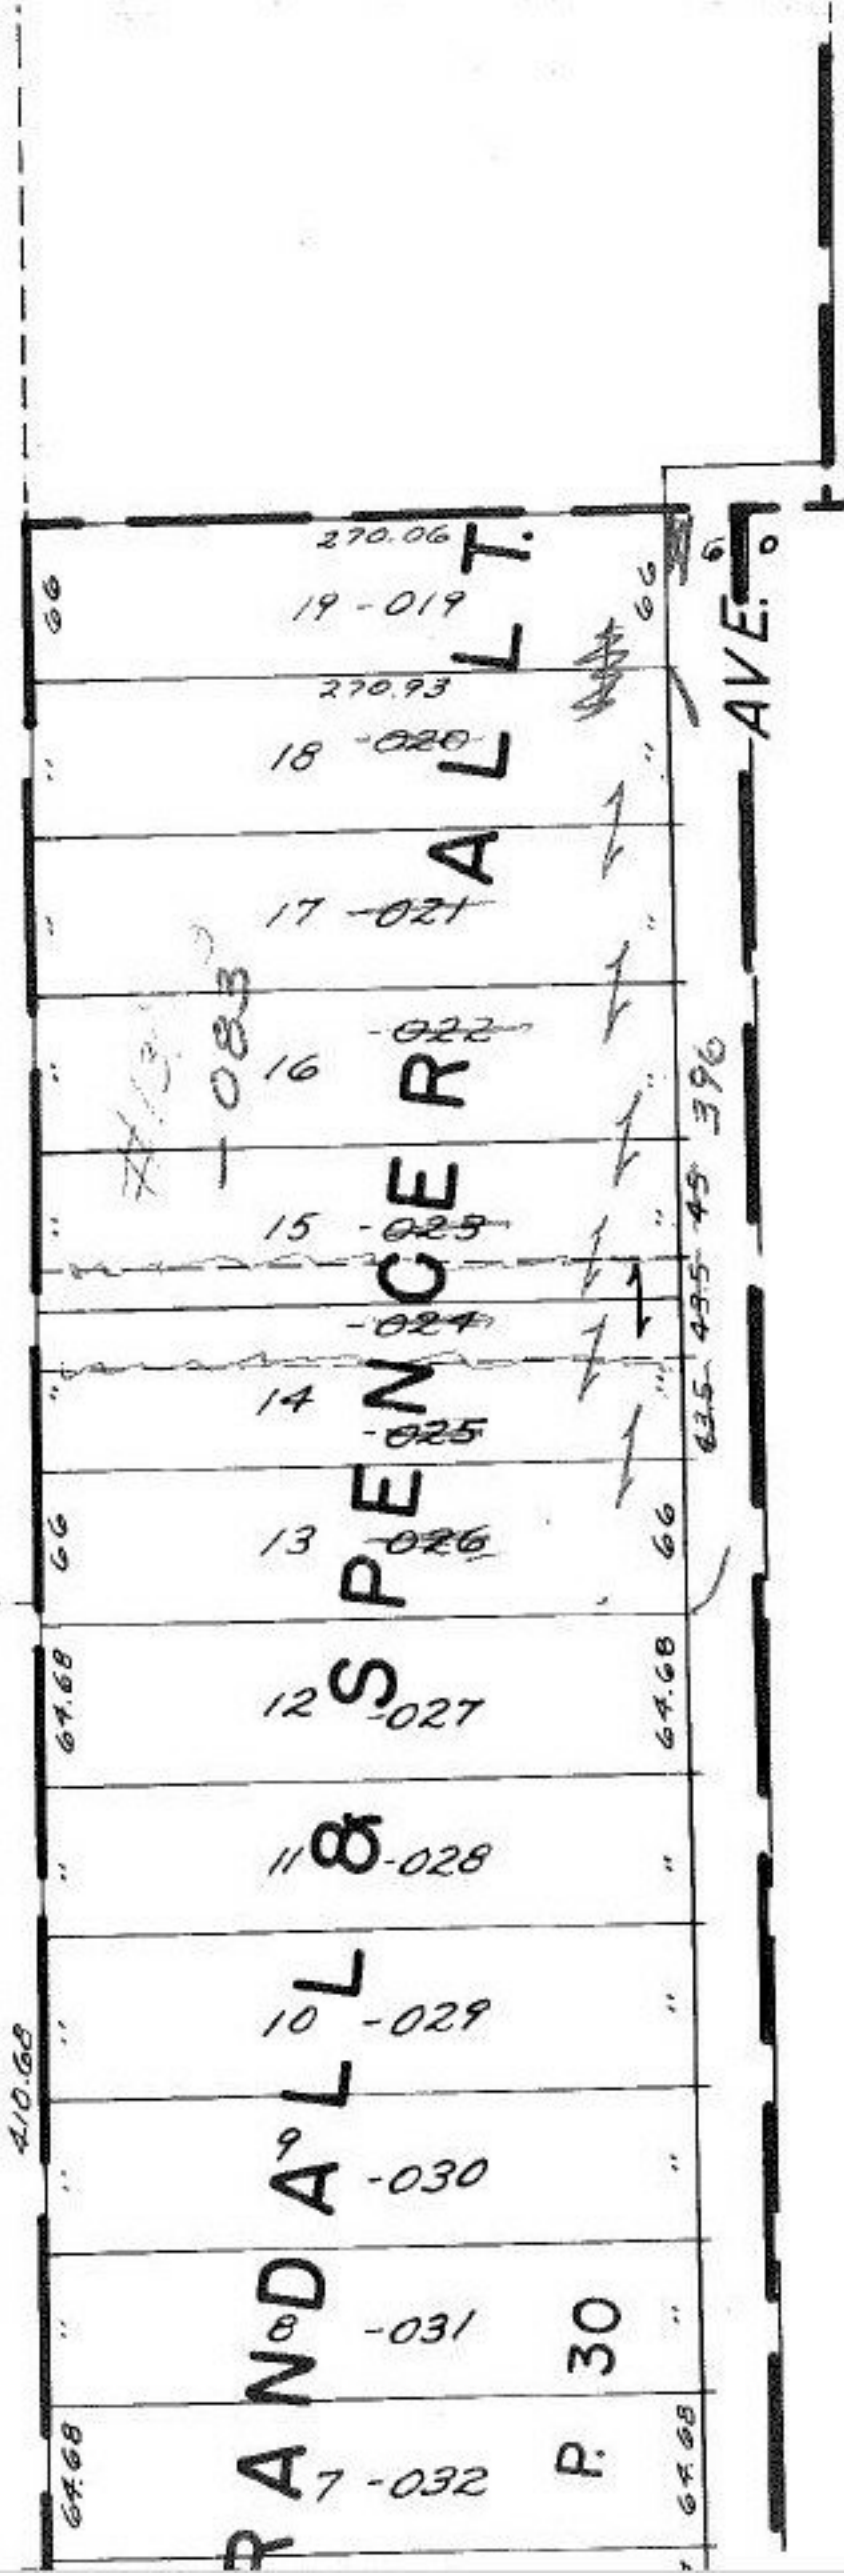

SEE 9-00-075-B

[Handwritten scribble]

T.M.
7-21-80

#137 00

APPROVED
LORAIN CO.
MAP DEPT.
DATE 7-14-80
PAGE 9-00-075A
BY <i>[Signature]</i>
VOID