


#13709

SEE ALSO  
SPLIT #  
13708 FOR  
OTHER DETAILS  
2 SURVEYS  
ALSO  
AVAILABLE.

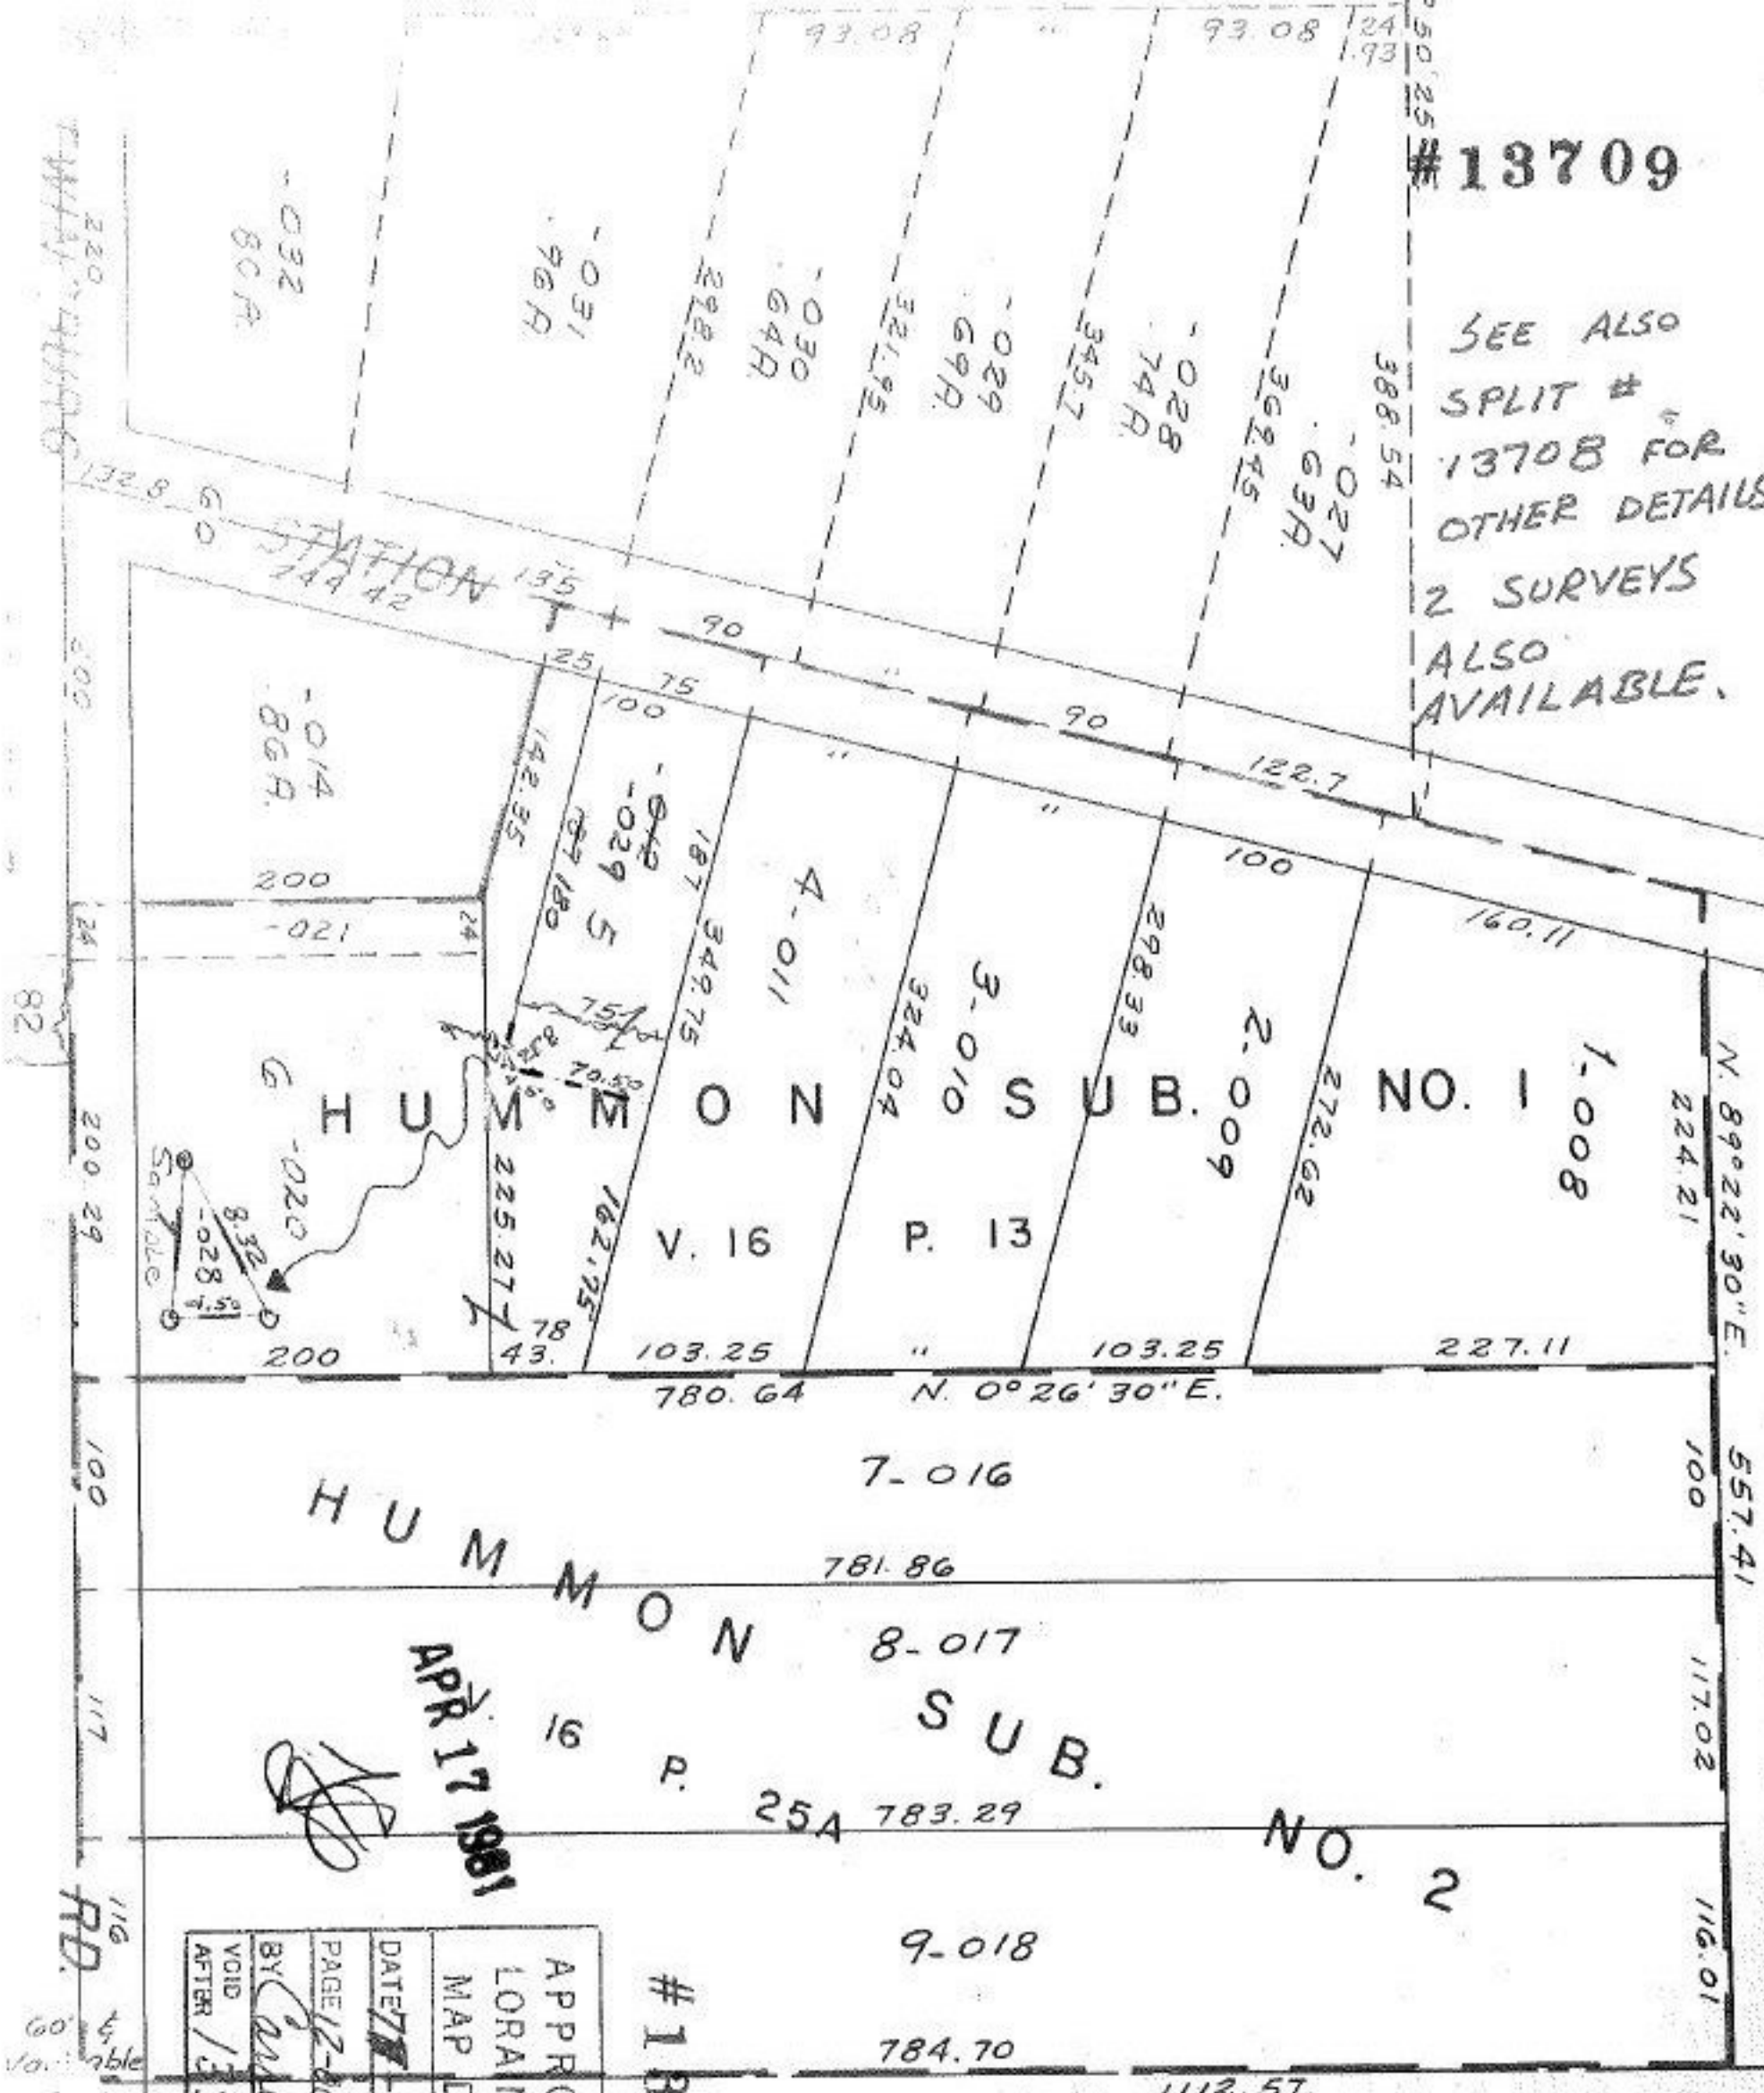

APPROVED	DATE	BY	PAGE
LORAIN CO.	7-16-80	Canby	12-80-076-B
MAP DEPT.			
VOID AFTER			
			13709

#13709

APR 17 1981

*[Signature]*

60' variable