


- 022  
23.22X10.51  
- 023  
23.22X138.38

SEE 3-00-034-A

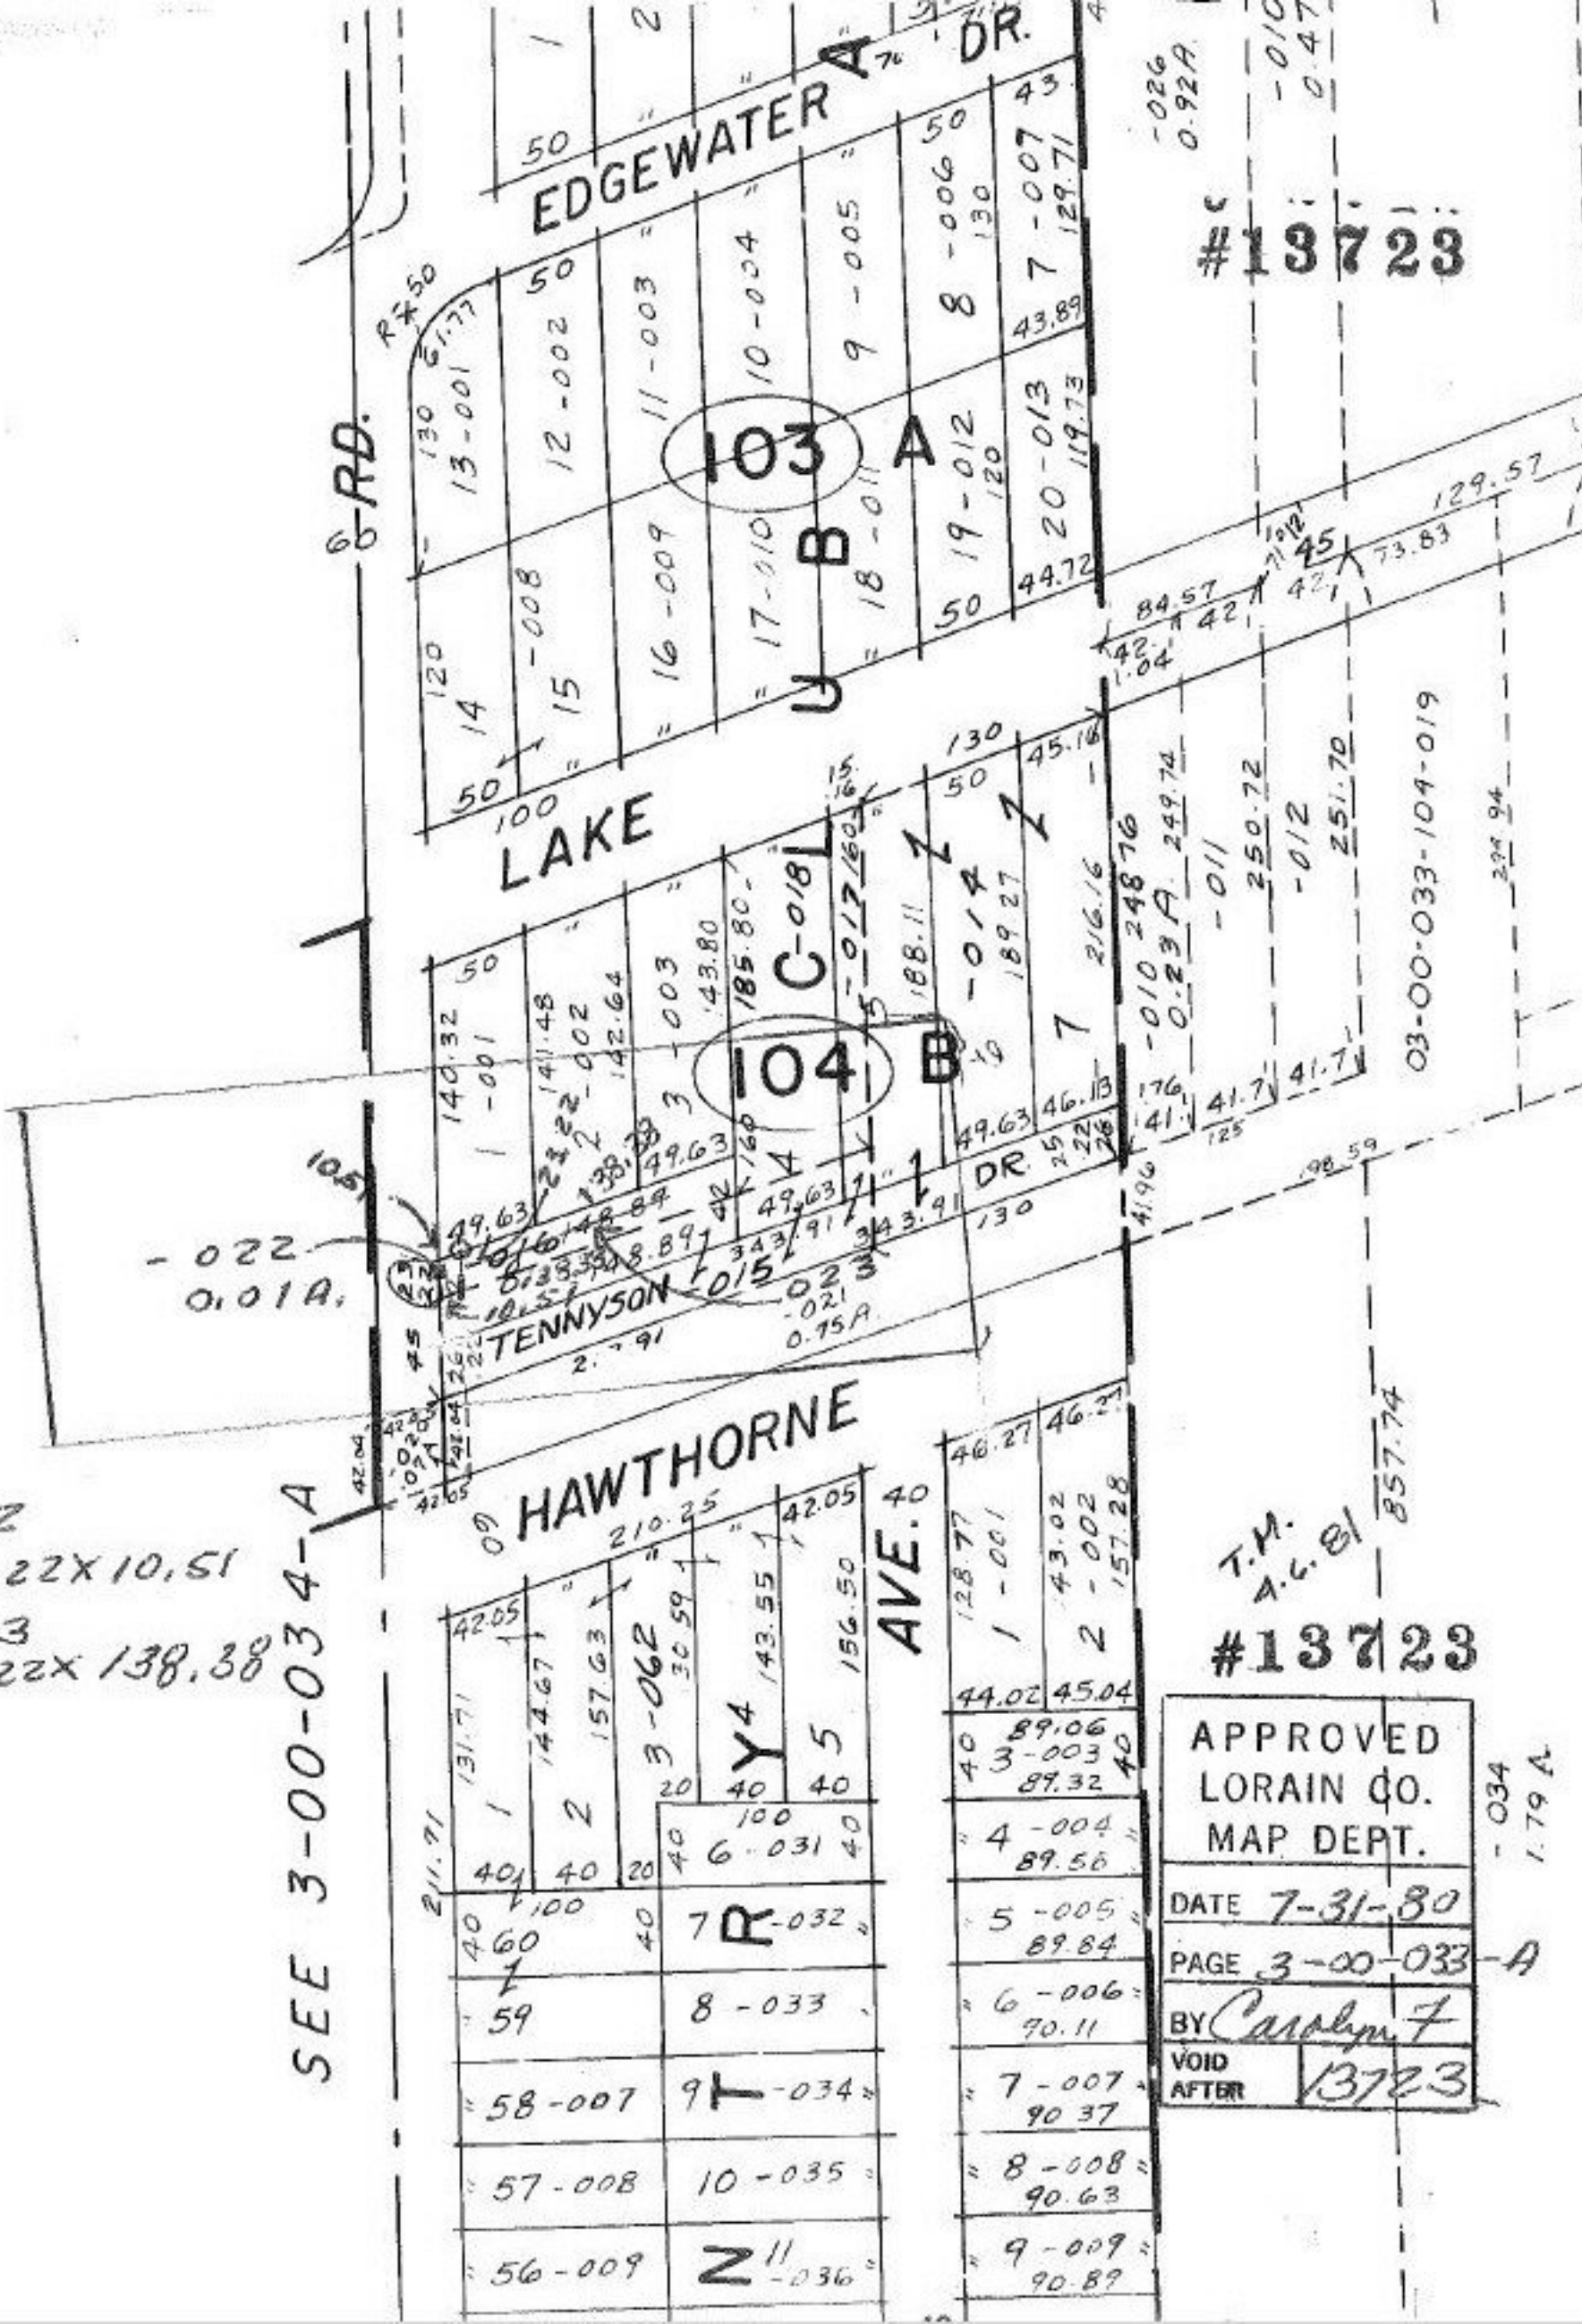

#13723

#13723

APPROVED LORAIN CO. MAP DEPT.	
DATE	7-31-80
PAGE	3-00-033-A
BY	Carolyn F
VOID AFTER	13723

- 034  
1.79 A