


SEE 3-00-035

MADISON

#13737

-018 32.59x140
-019 7.41x140

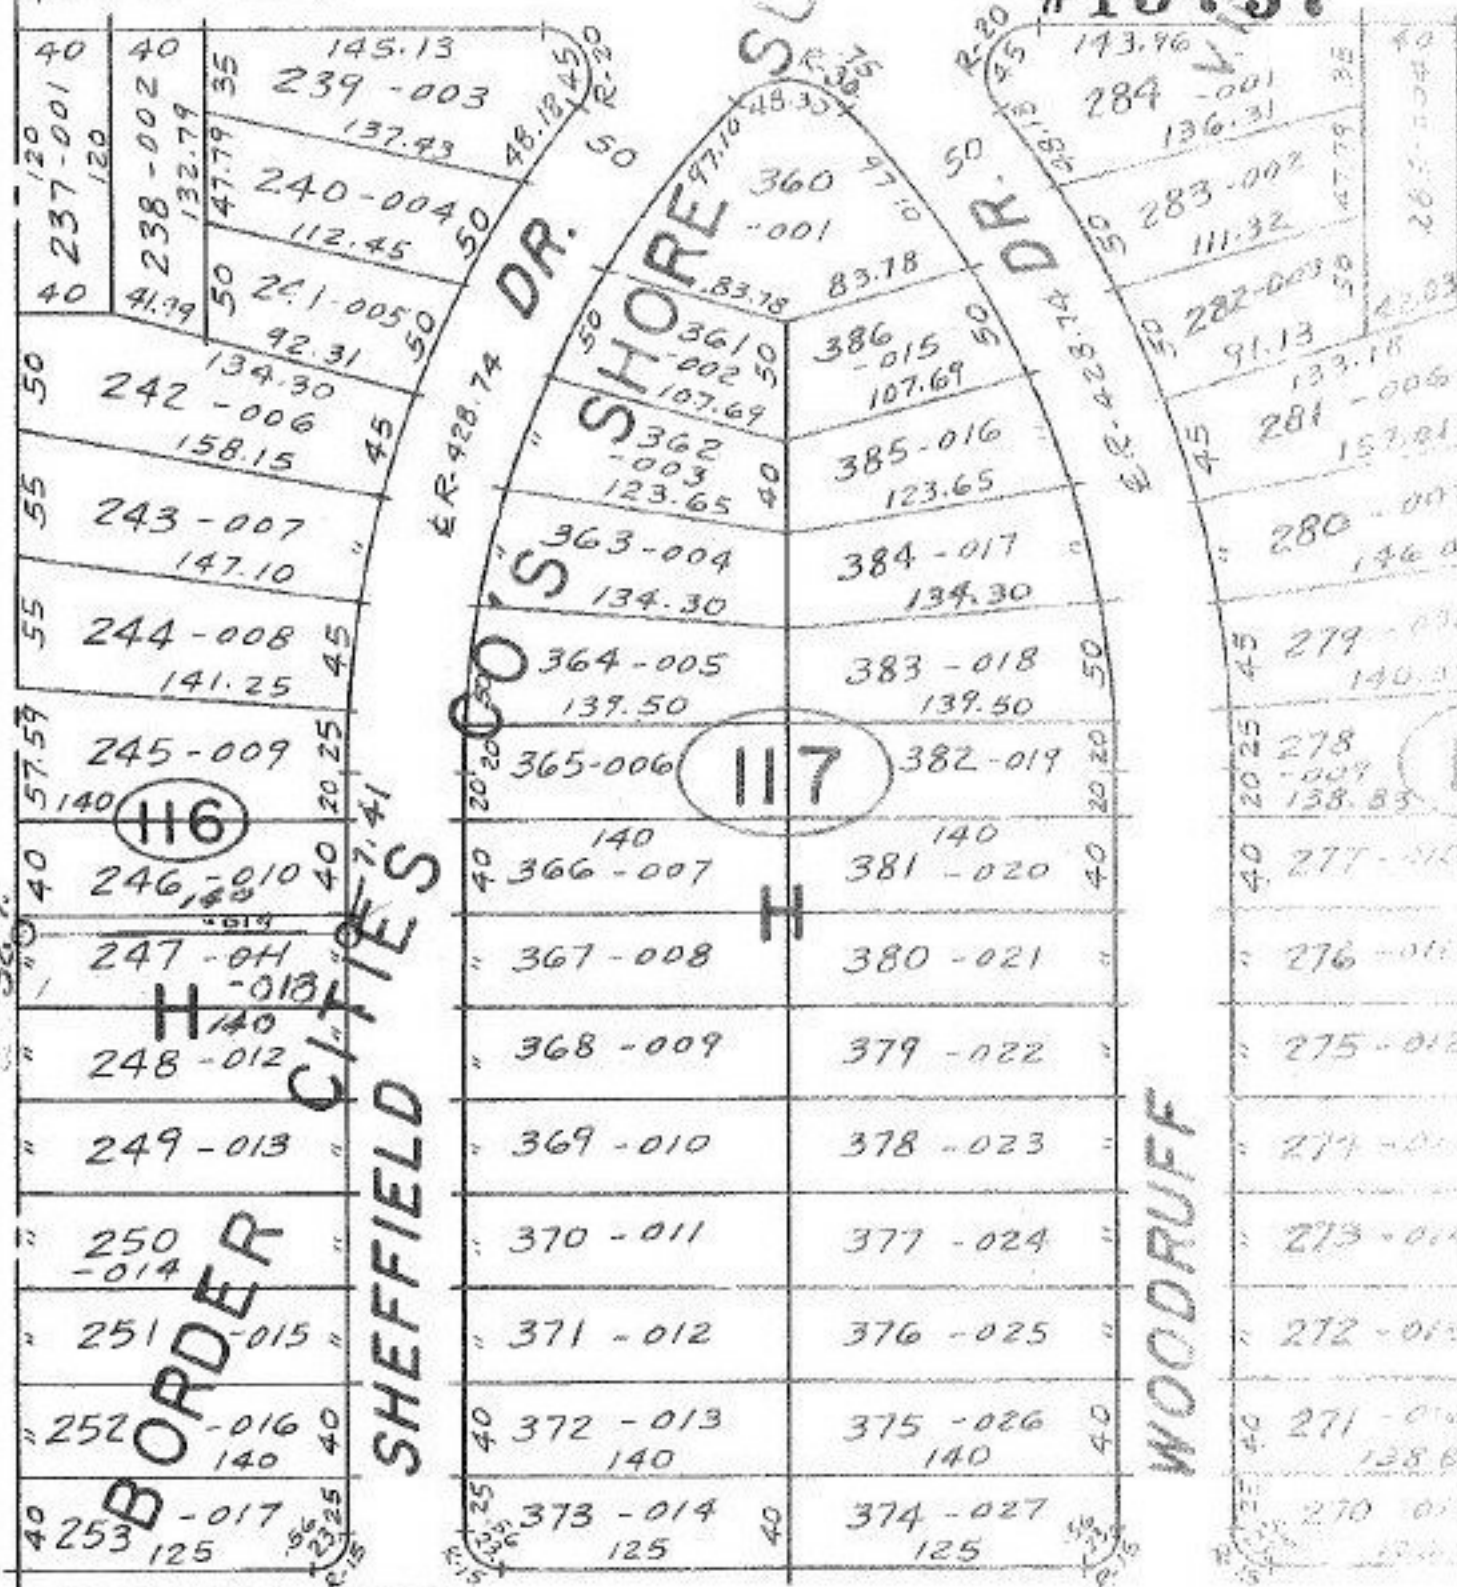

RICHELIEU



APPROVED
LORAIN CO.
MAP DEPT.

DATE 8-7-80
PAGE 3-00-034-B
BY Carolin
VOID AFTER 13737

T.M.
A.G.B.