


#13742

SEE 10-00-015-F

RD.

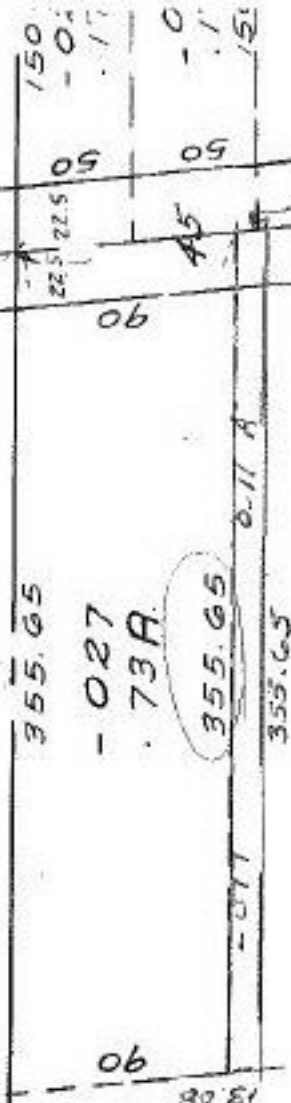

ROBSON 13.08 301.63 150 -02 150 -02 50 50 45 45

NORTH

-078
47.53 A

-060
47.53

47.64
0.11
47.53

#13742

459 A

APR 17 1981

APPROVED
LORAIN CO.
MAP DEPT.
DATE 10-00-016-8
PAGE 8-11-80
BY T. [Signature]
VOID AFTER

[Handwritten mark]

River

292.65

933.59

255.92

250.13

470.68

90

13.08

100