

SEE 6-24

PER MAP DEPT.

Ac.

CORRECTION

Pt. -004
Pt. 1.25A

Pt. -005
Pt. 1.25A

Pt. -006
Pt 2.50A

Pt. -007 Pt. 0.86A

Pt. 1.64A

101

Pt. -009
Pt. 2.50A


Pt. -010
Pt. 2.50A

Pt. -008

#13759

APPROVED
LORAIN CO.
MAP DEPT.
DATE 8-15-80
PAGE 6-41
BY T. McNamee
VOID AFTER

T.M.
7-17-81

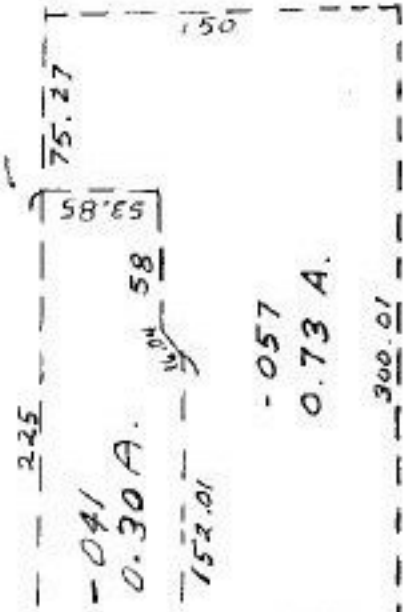

-058

~~2.07A~~
3.97A

935.74

58 23 58 116.285 232.57 40 76.29 116.345 80 116.345 60 92 90 82.80 TRIP 166.7

1845.83 from
W. Line Lake Ave

200
-039
0.37A
200

41
00A
532.70

004
1.25A
447
035
03A
447
036
1.03A
447
-051
.77A
447