


#13765

OHIO TURNPIKE  
PEACH BLOSSOM LANE

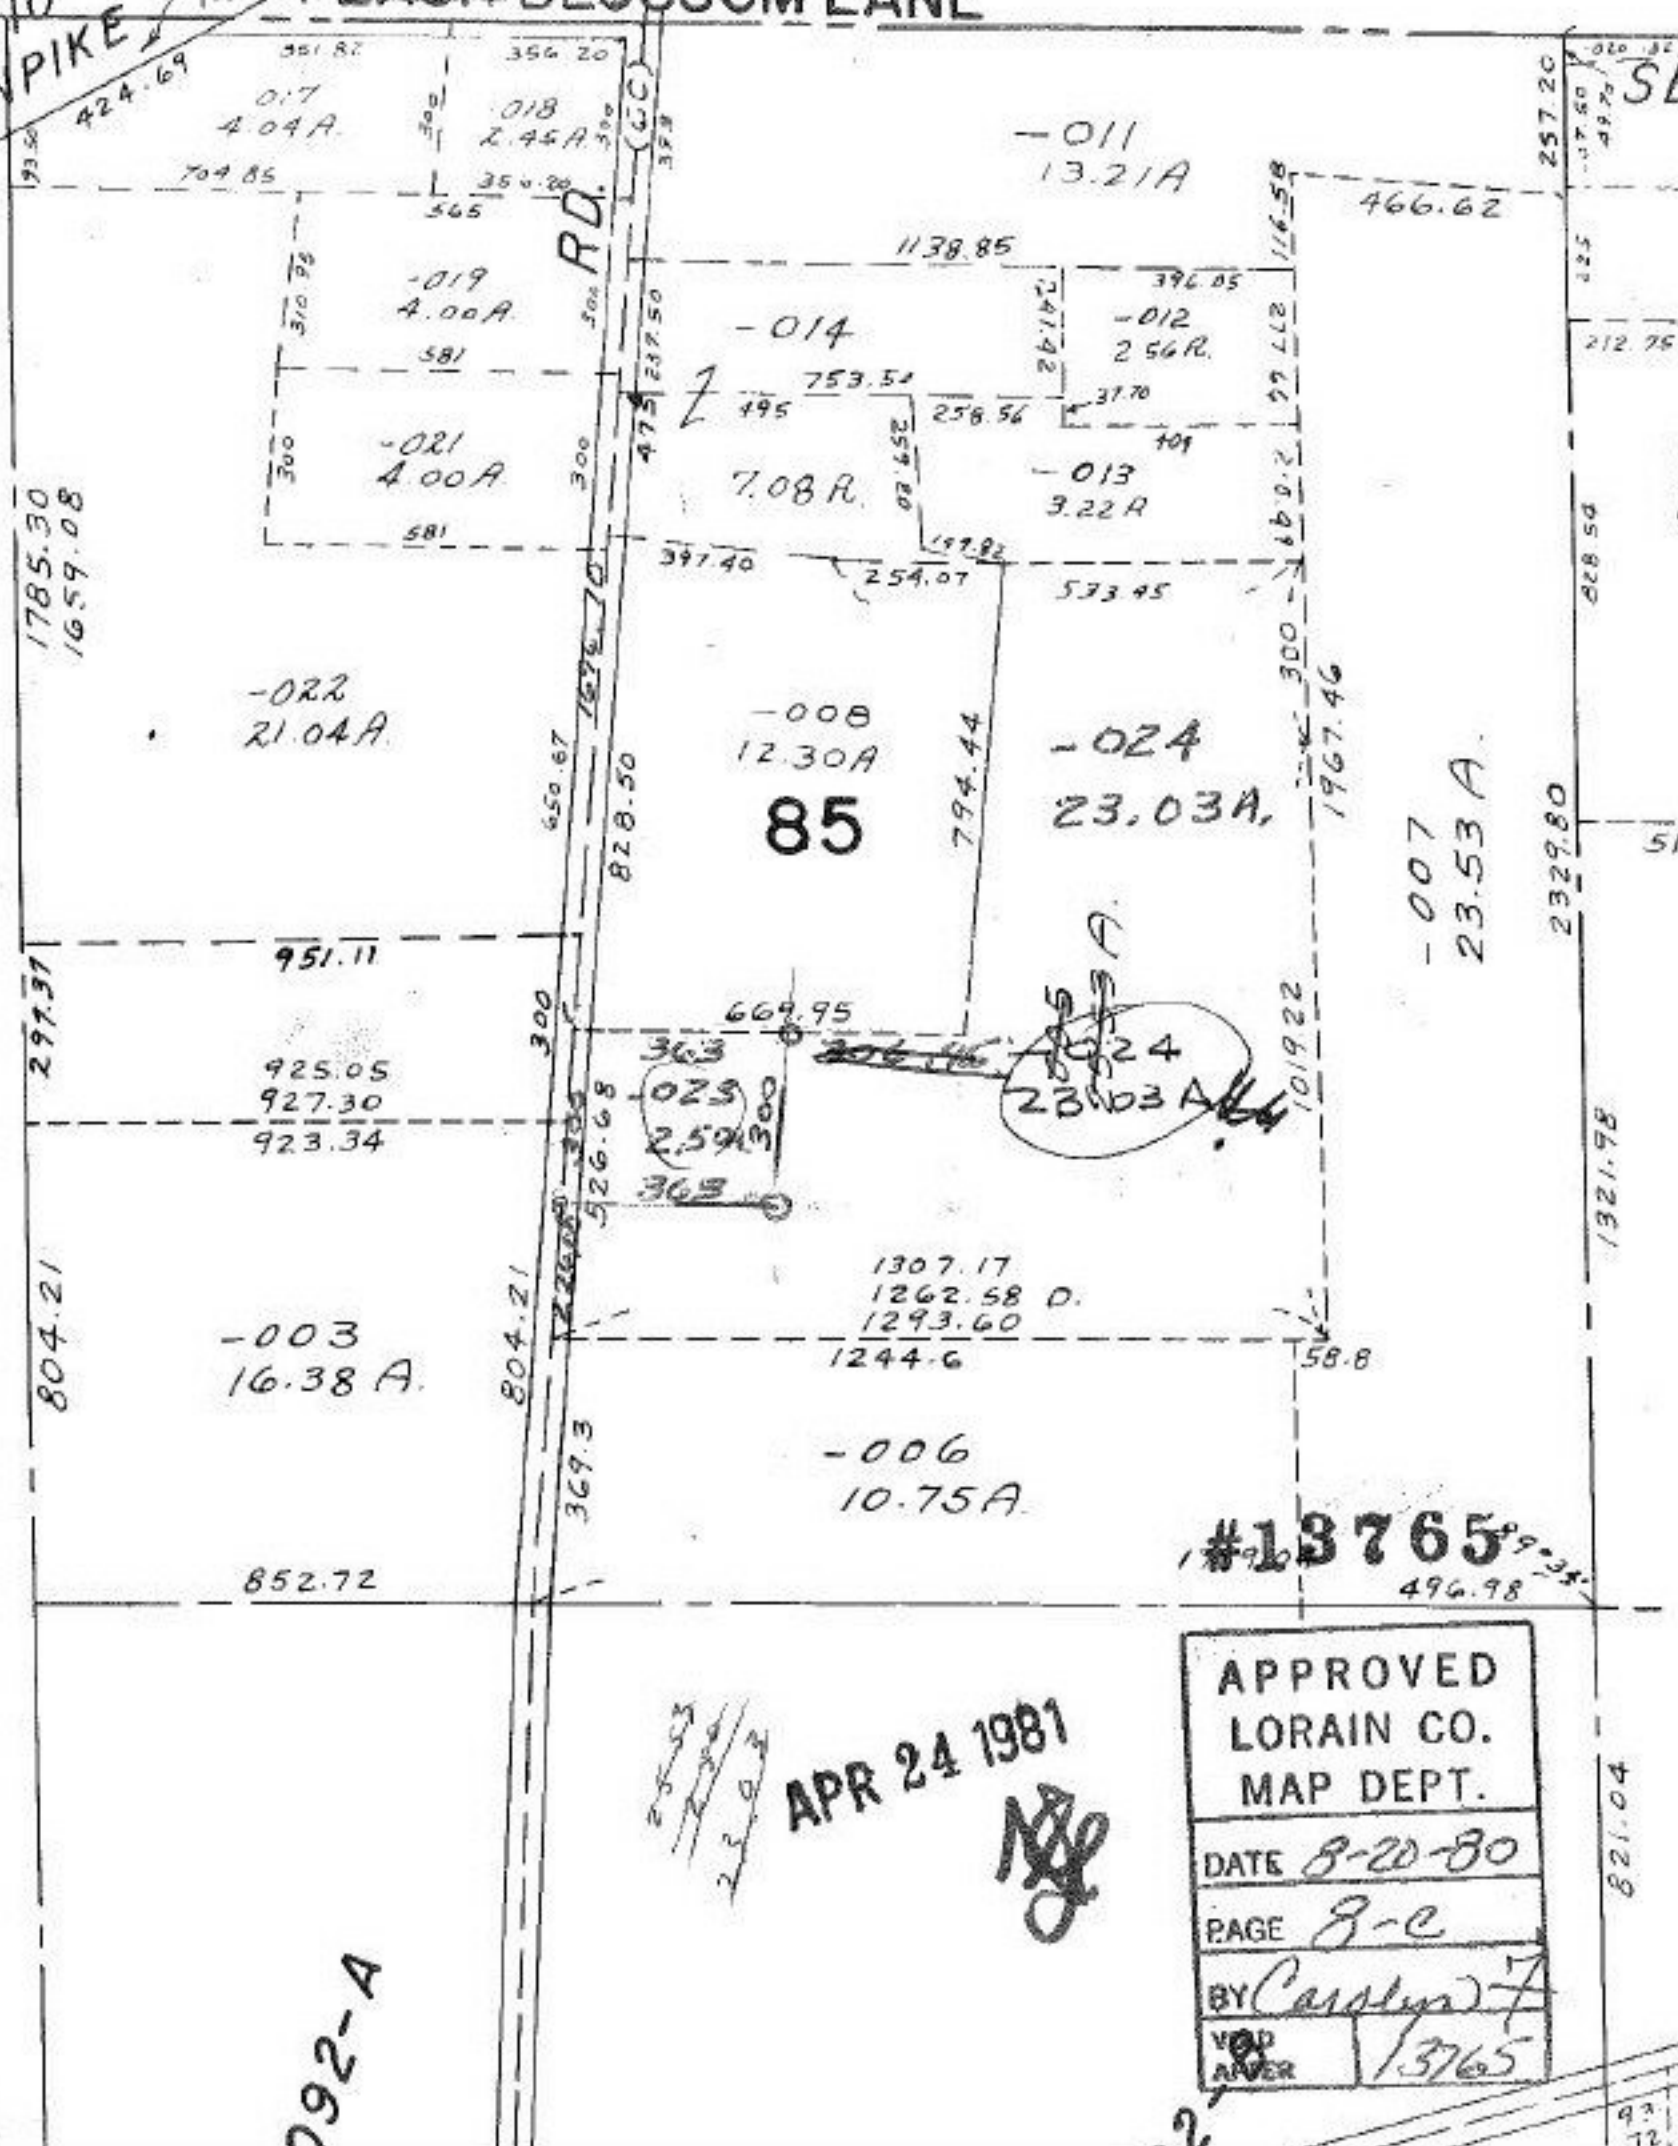

#0  
#00

292-A

APR 24 1981

#13765  
496.98

APPROVED	
LORAIN CO.	
MAP DEPT.	
DATE	8-20-80
PAGE	8-c
BY	Carolyn J. F.
VOD	
AMVER	13765

SL

51

1321.98

821.04

93  
12