


#13774

APPROVED
LORAIN CO. 3363
MAP DEPT.
DATE 69-27-80
PAGE 10-00-004
BY [Signature]
VOID AFTER 13774

APR 17 1981

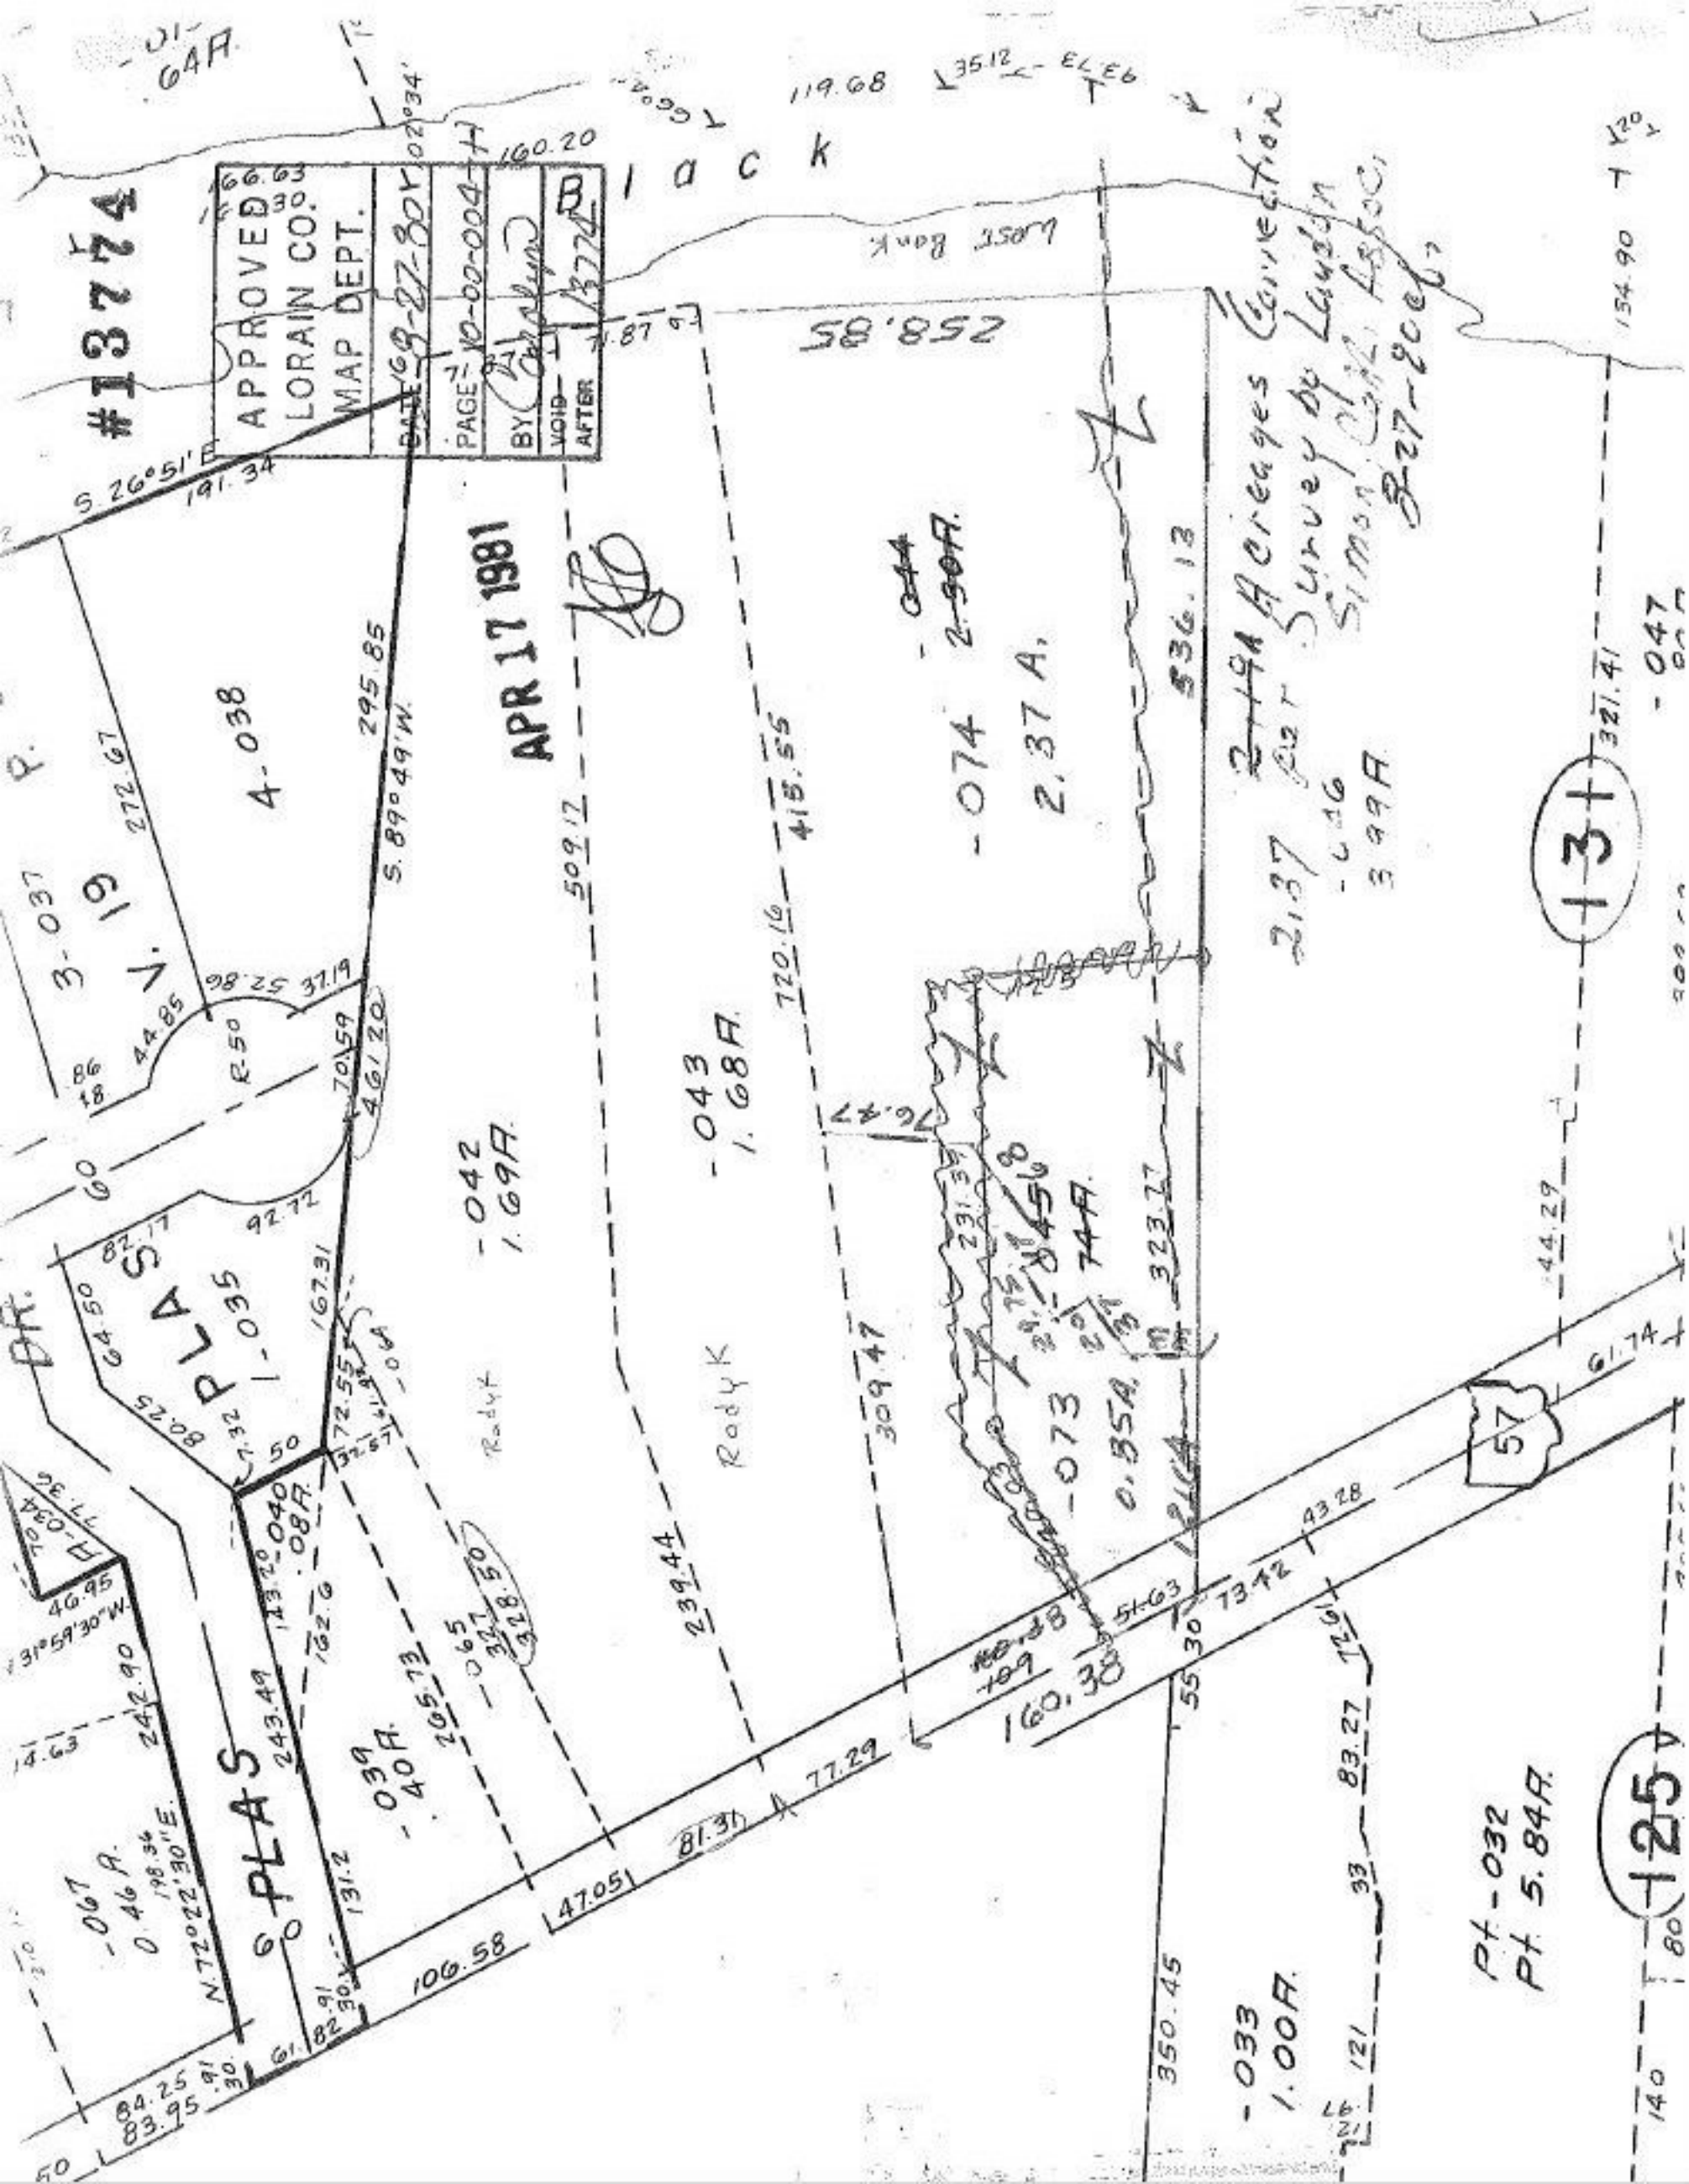

4-038

-042
1.69A

-043
1.68A

-074
2.37 A

-073
0.55A
74A

2137
-046
3.99A
219A Creages Convection
Survey by Laurdan
Simon, Carl Assoc.
8-27-80

Pt -032
Pt 5.84A

131

125

57

64A

119.68 35.12 ELEG

S 26°51'E
191.34

S. 89°49'W.
295.85

509.17

120.16
415.55

536.13

154.90
120

-047

M.06, 65, 15
46.94
77.36
H.034
704

-067
0.46A
198.54
242.90
N. 72°22'30"E

6 PLAS

-039
-40A

106.58

47.05

81.31

77.29

160.38

350.45

-033
1.00A

55.30

73.12

93.28

83.27

93

44.29

6.74

321.41

-047