


#13776

2881.90

3181.70

RD.

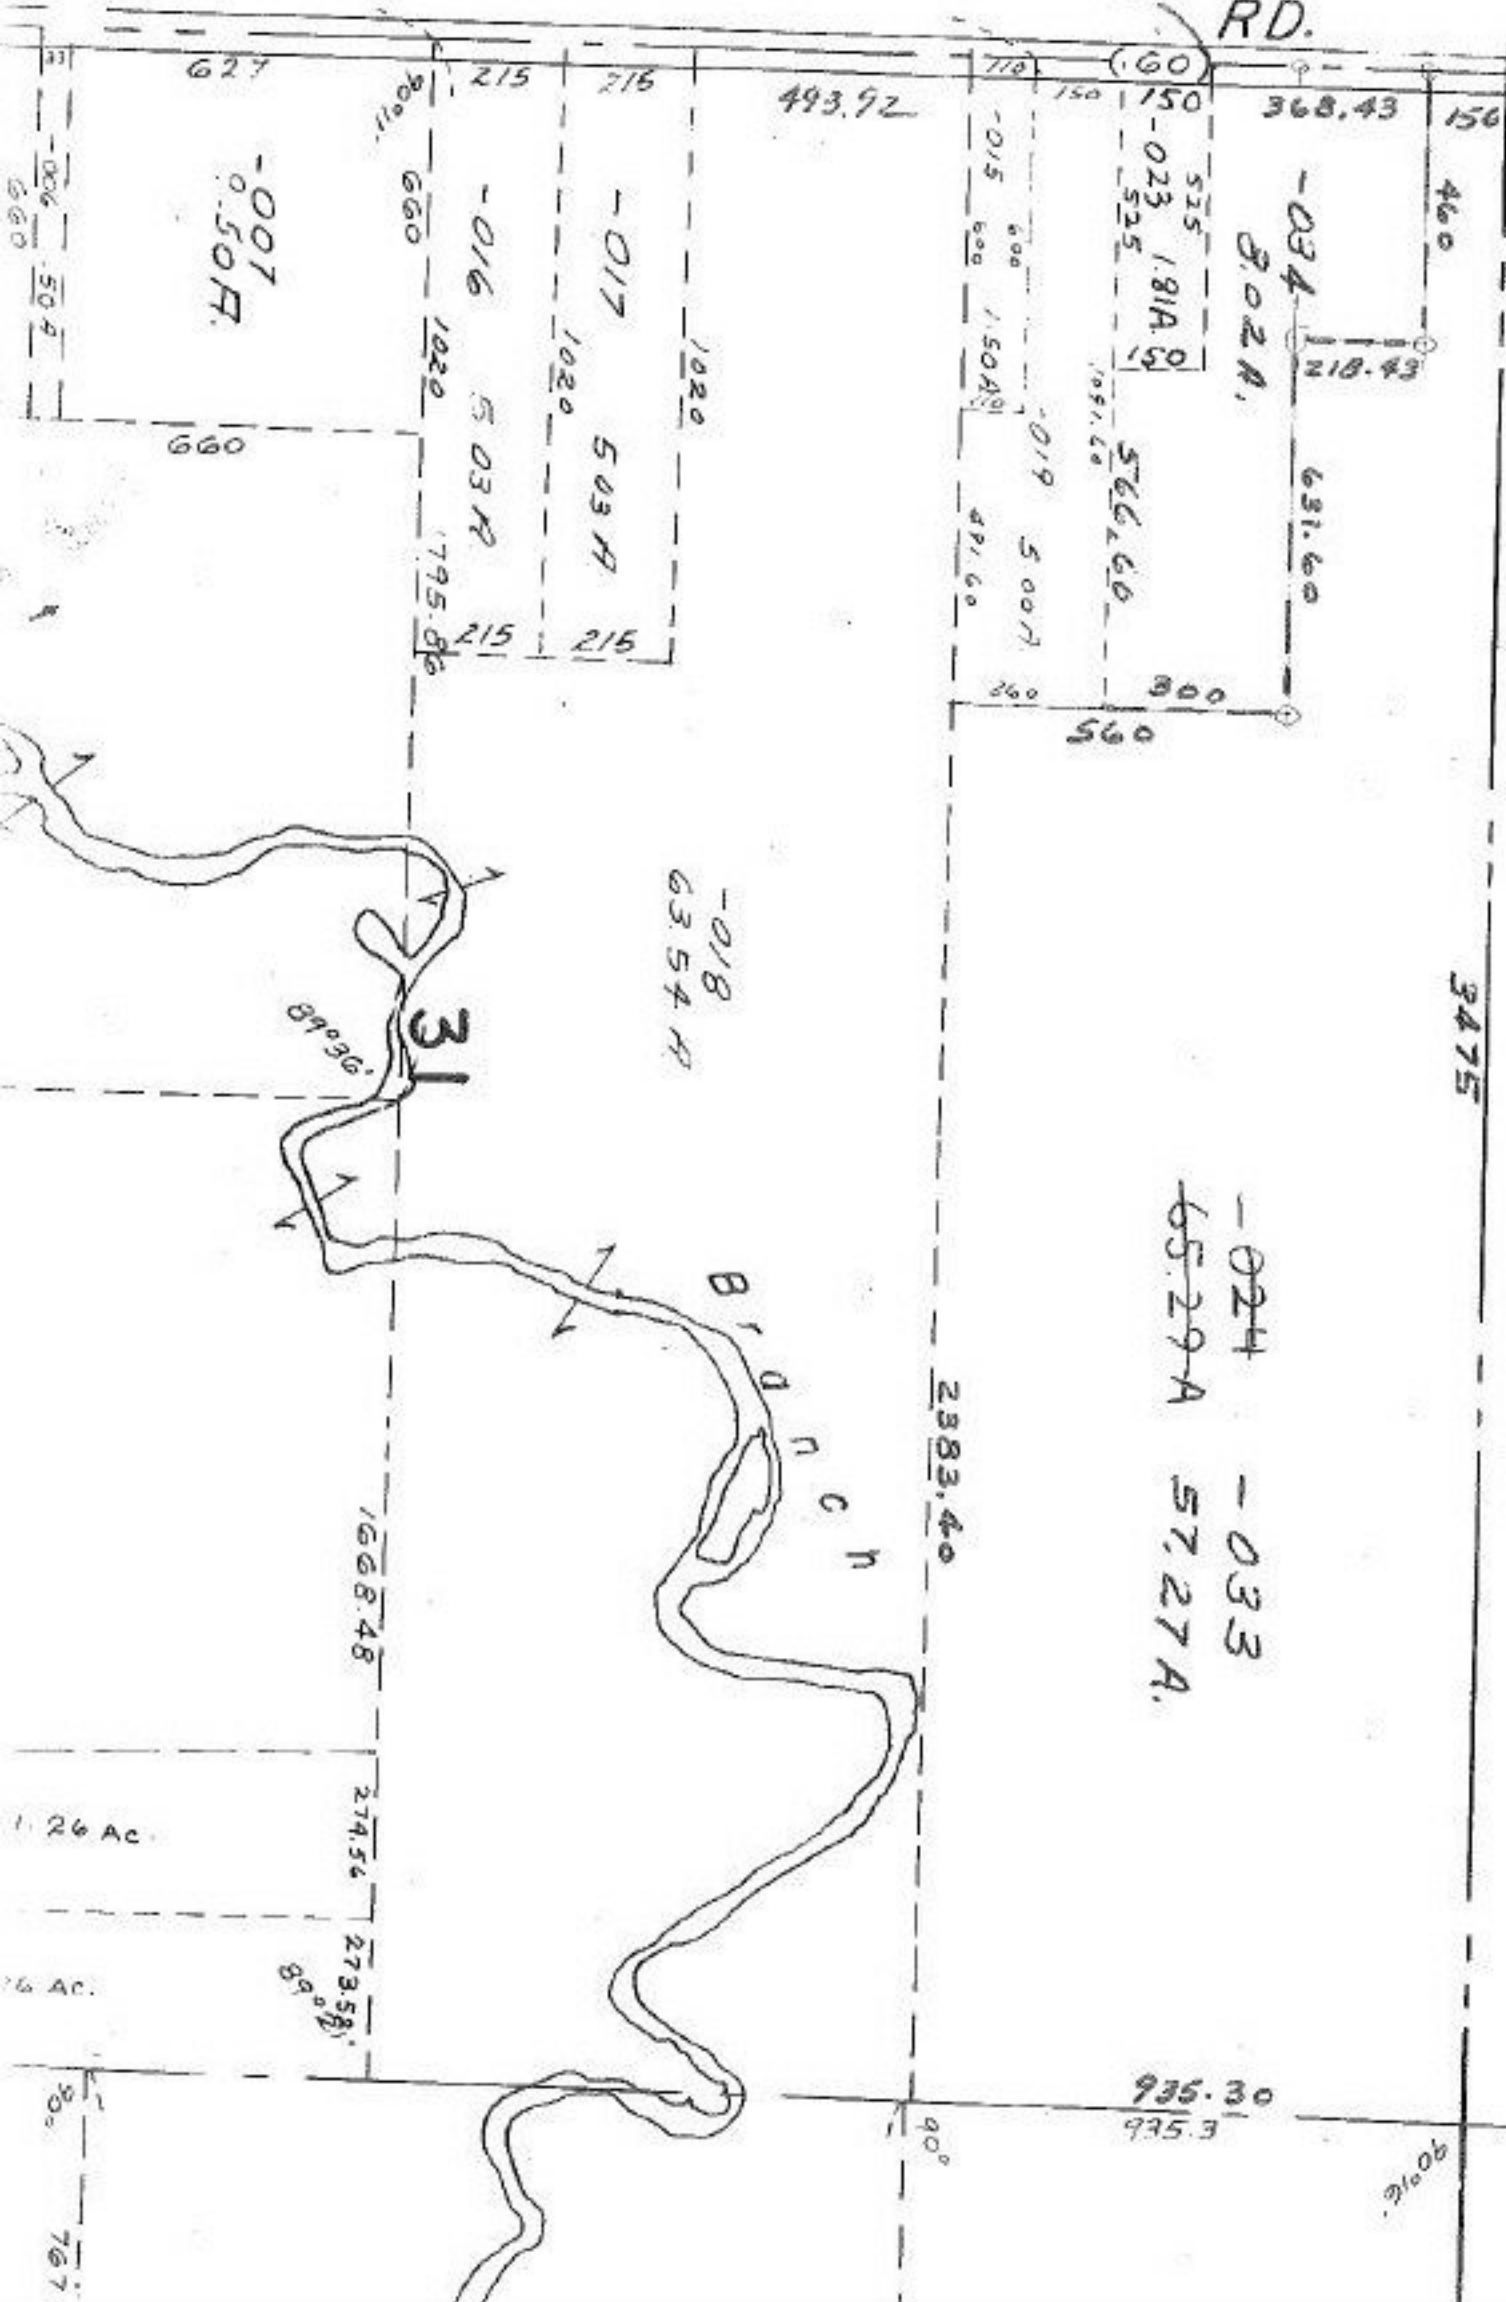

#13776

APPROVED LORAIN CO. MAP DEPT.	
DATE	8-28-80
PAGE	18-B
BY	Carlynn A
VOID AFTER	13776

MAR 23 1981



SEE 14-F

-024
65.29 A

-033
57.27 A.

-018
63.54 A

-007
0.50 A.

-016
5.03 A

-017
5.03 A

-019
5.00 A

-034
3.02 A.

-023
1.81 A.

1.26 Ac.

1.26 Ac.

30°

767

90°

90°

935.30
935.3

1668.48

274.54

273.58

2383.40

3475

493.92

368.43

156.87

460

631.60

800

260

710

150

150

515

525

1.81 A.

566.60

1091.60

566.60

566.60

900

660

1020

1020

