


#13783

NEW LONDON - LAFAYETTE

162

CHECK TO SEE  
IF THIS GOES  
ALONG PROP. LINE  
TO THE EAST

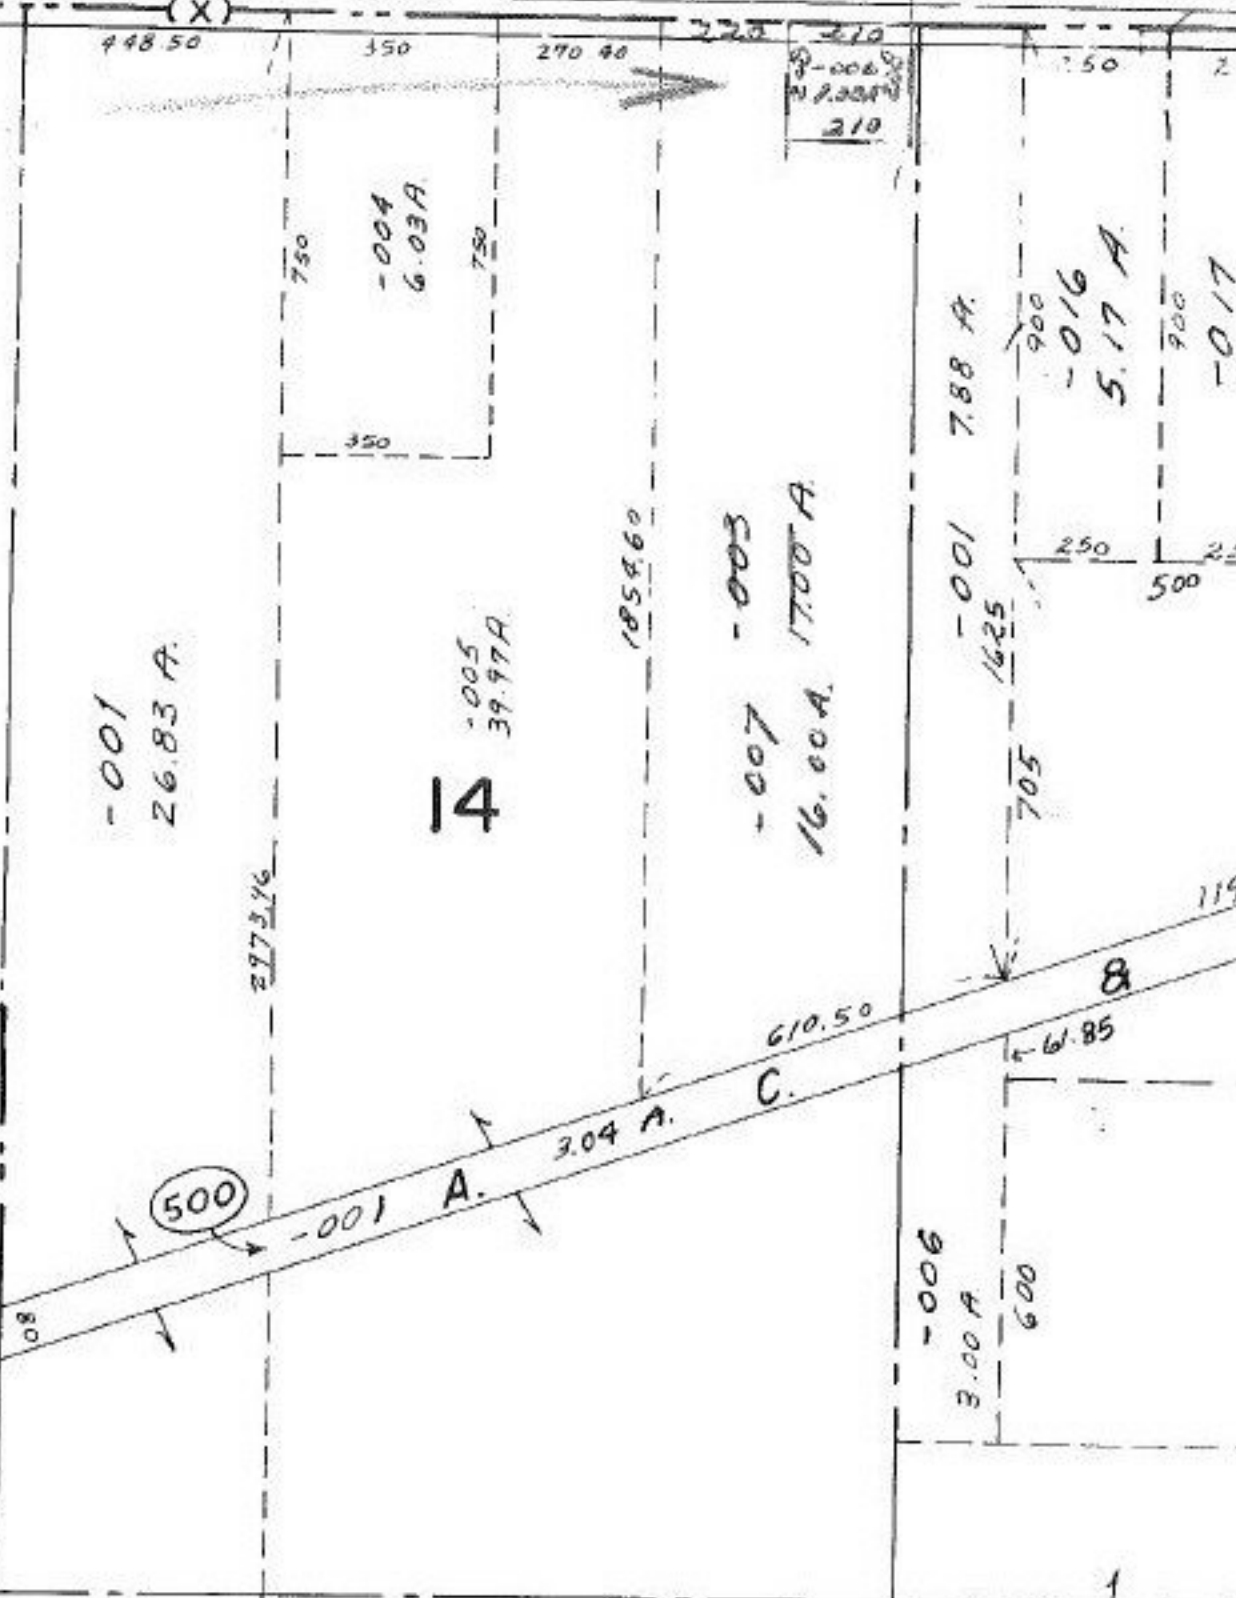

-006  
1.00 A

-007  
16.00 A.

-001  
26.83 A.

-005  
39.97 A.

-007  
16.00 A.

-003  
17.00 A.

-001  
7.88 A.

-016  
5.17 A.

-006  
3.00 A.

-001  
4.38 A. Dup.  
3.12 A. Pl.

-002  
9.00 A.

#13783

APPROVED LORAIN CO. MAP DEPT.	
DATE	8-29-80
PAGE	21-H
BY	Carolyn F
VOID AFTER	13783

3/23/81