


#13788

601
601A
601B

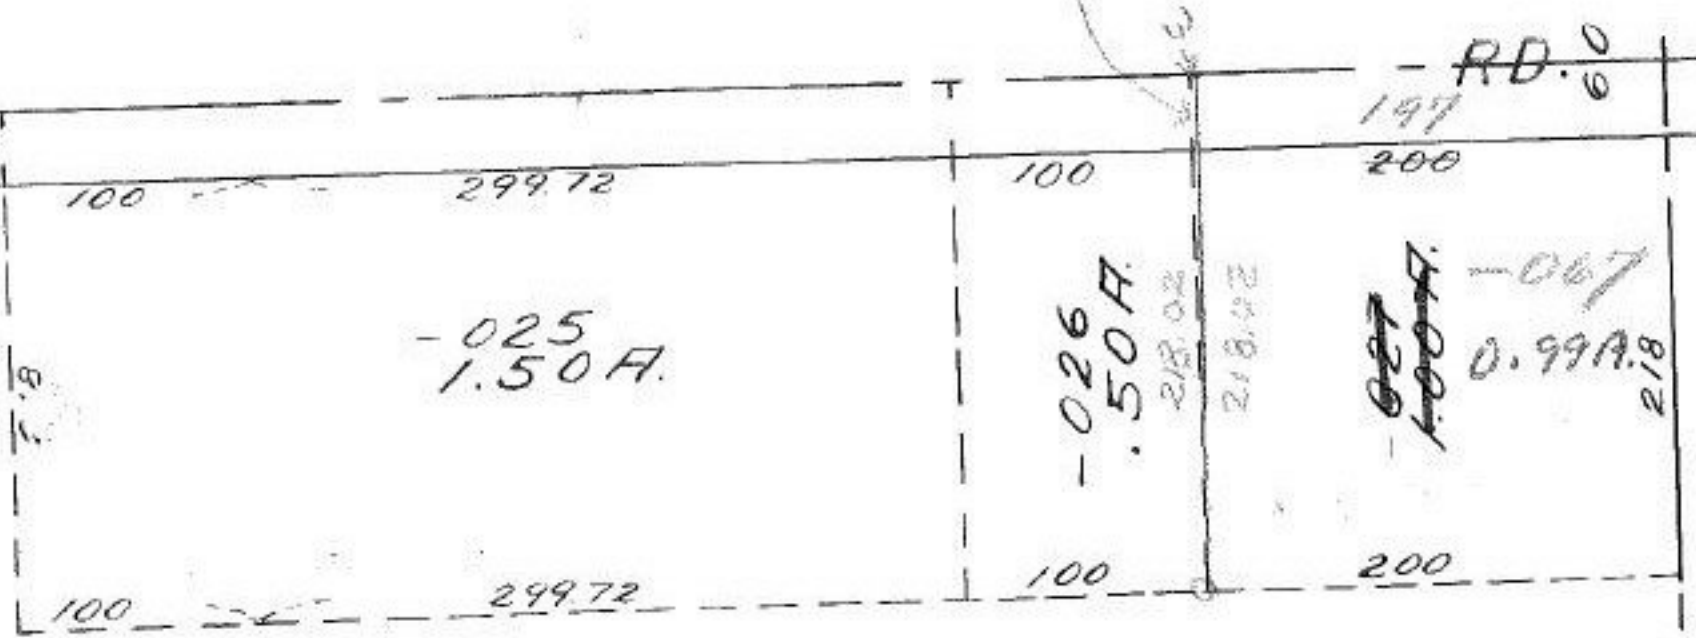

#13788

MAR 23 1981

APPROVED LORAIN CO. MAP DEPT.	
DATE	9-3-80
PAGE	18-00-020 - B
BY	Carolyn F
VOID AFTER	13788