


#13796

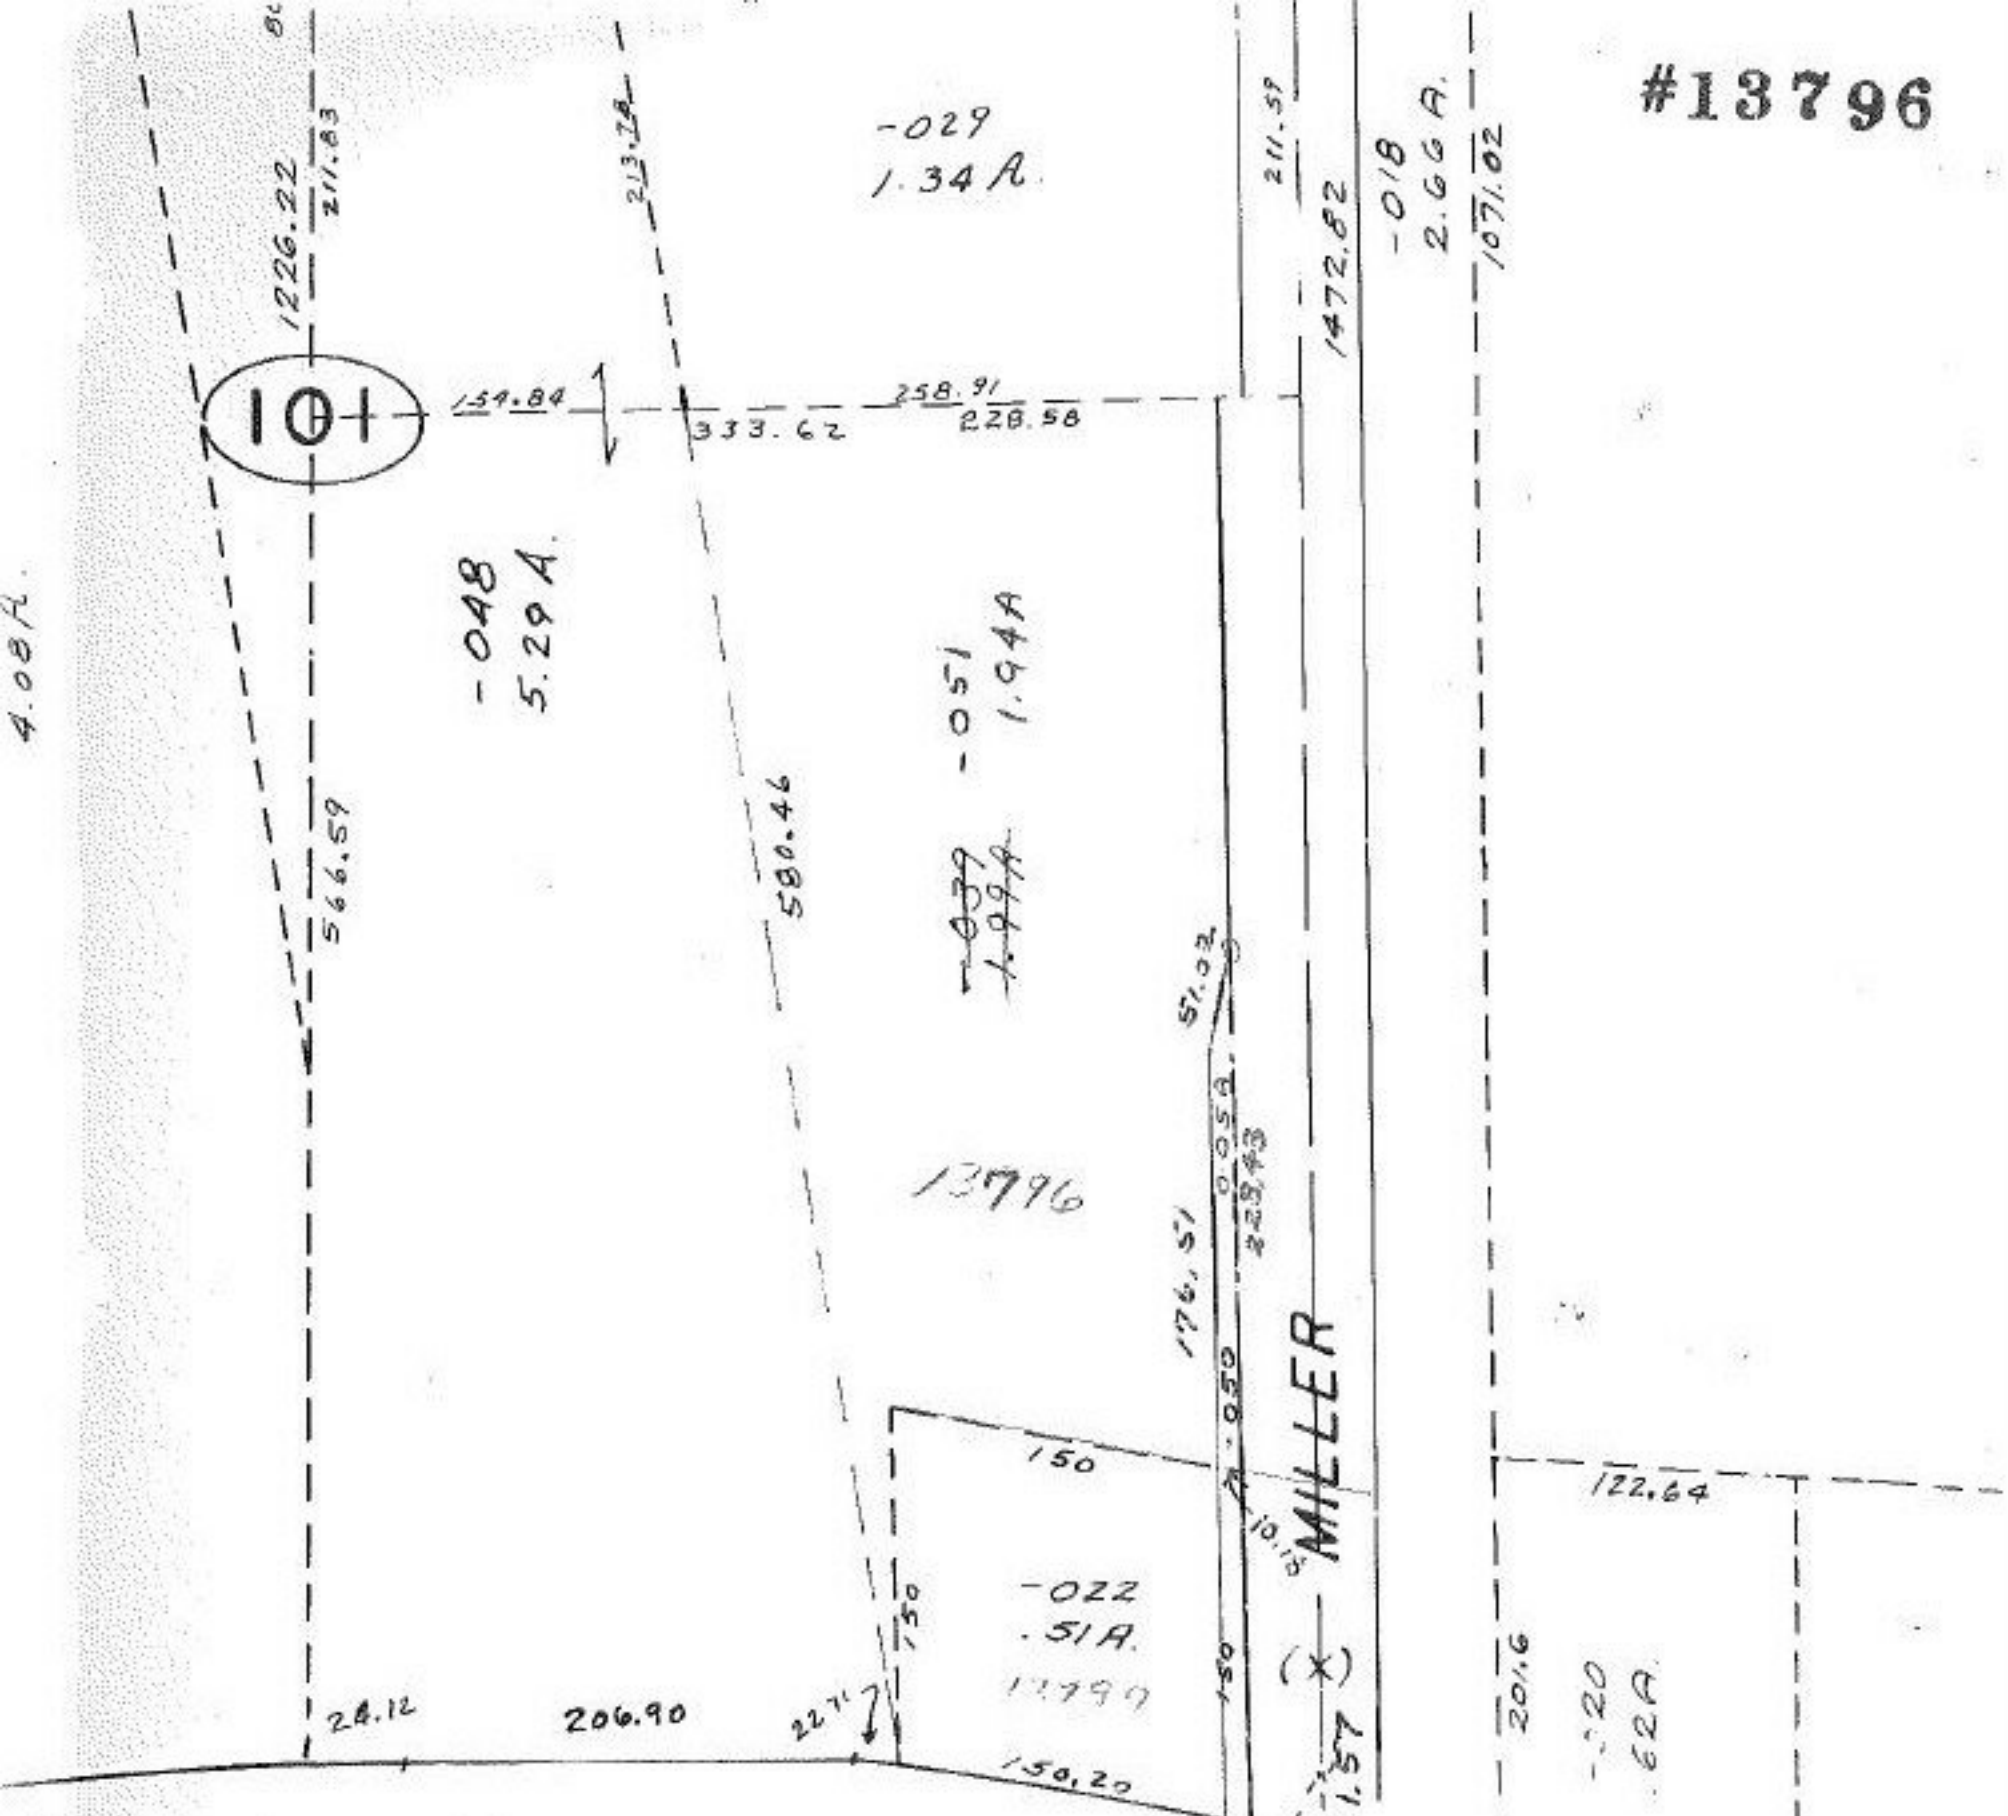

EVILLE - LORAIN

#13796

APR 10 1981

APPROVED LORAIN CO. MAP DEPT.	
DATE	9-10-80
PAGE	4-00-004-E
BY	<i>Carolyn A</i>
VOID AFTER	13796

