


#13812

COMBINATION

#13812
 APPROVED
 LORAIN CO.
 MAP DEPT.
 DATE 9-15-80
 PAGE 2-01-003-M
 BY T.M. Rain
 VOID AFTER

T.M.
3-18-81

-007

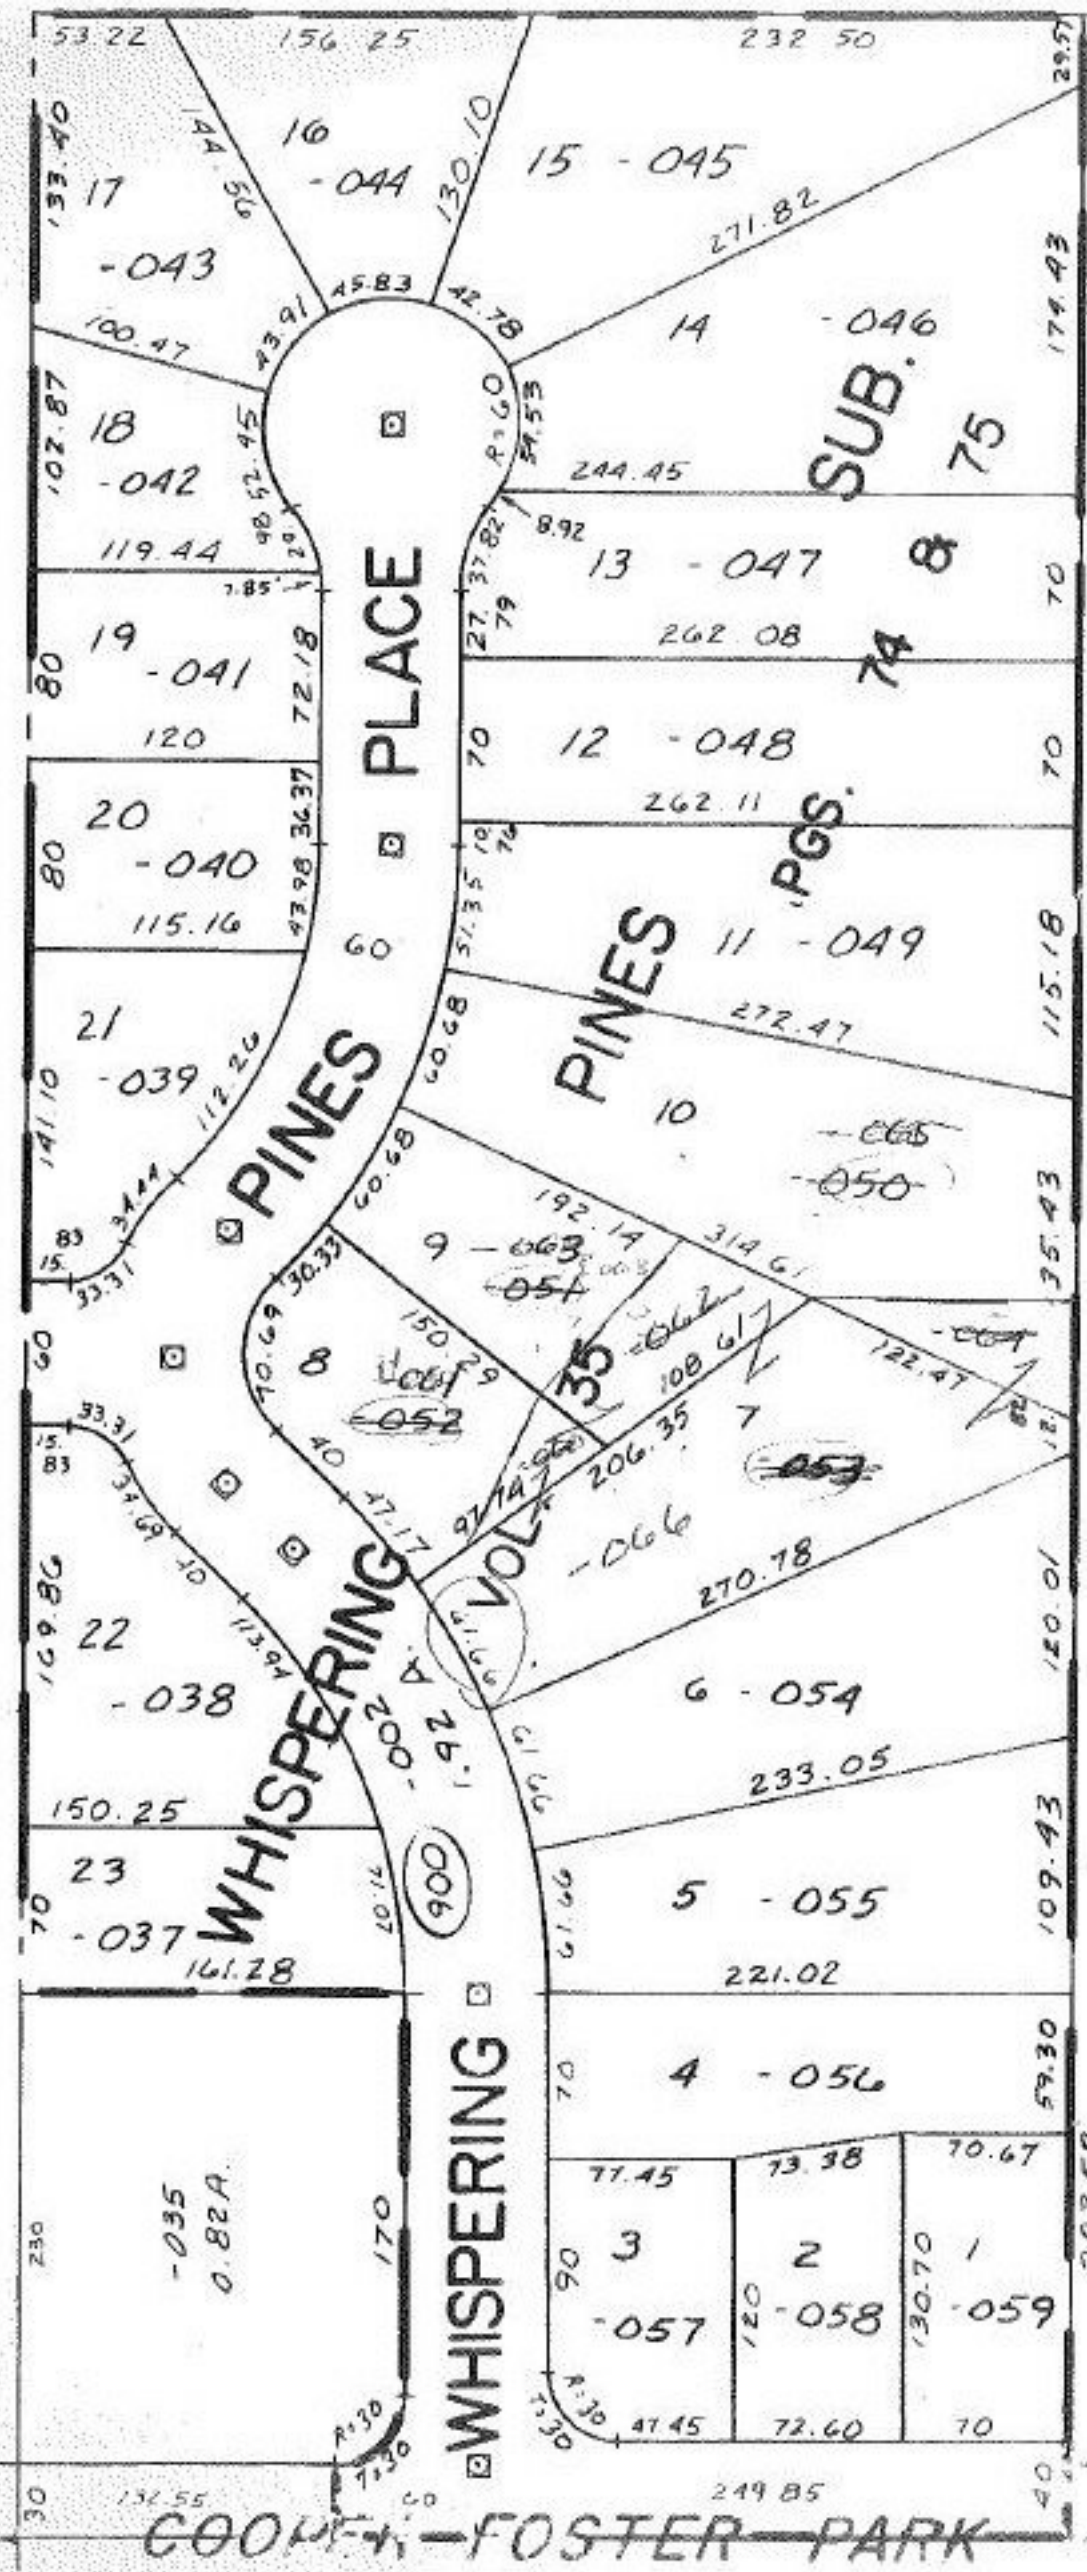

COOK-FOSTER PARK