



#13818

64

STANG

#13818

APPROVED
LORAIN CO.
MAP DEPT.

DATE 9-16 80

PAGE 5-D

BY T. McNamee

VOID AFTER

T.M.
A-10.81

65


60.29A

58.20 A.

18.83A

11.64A

4.00A

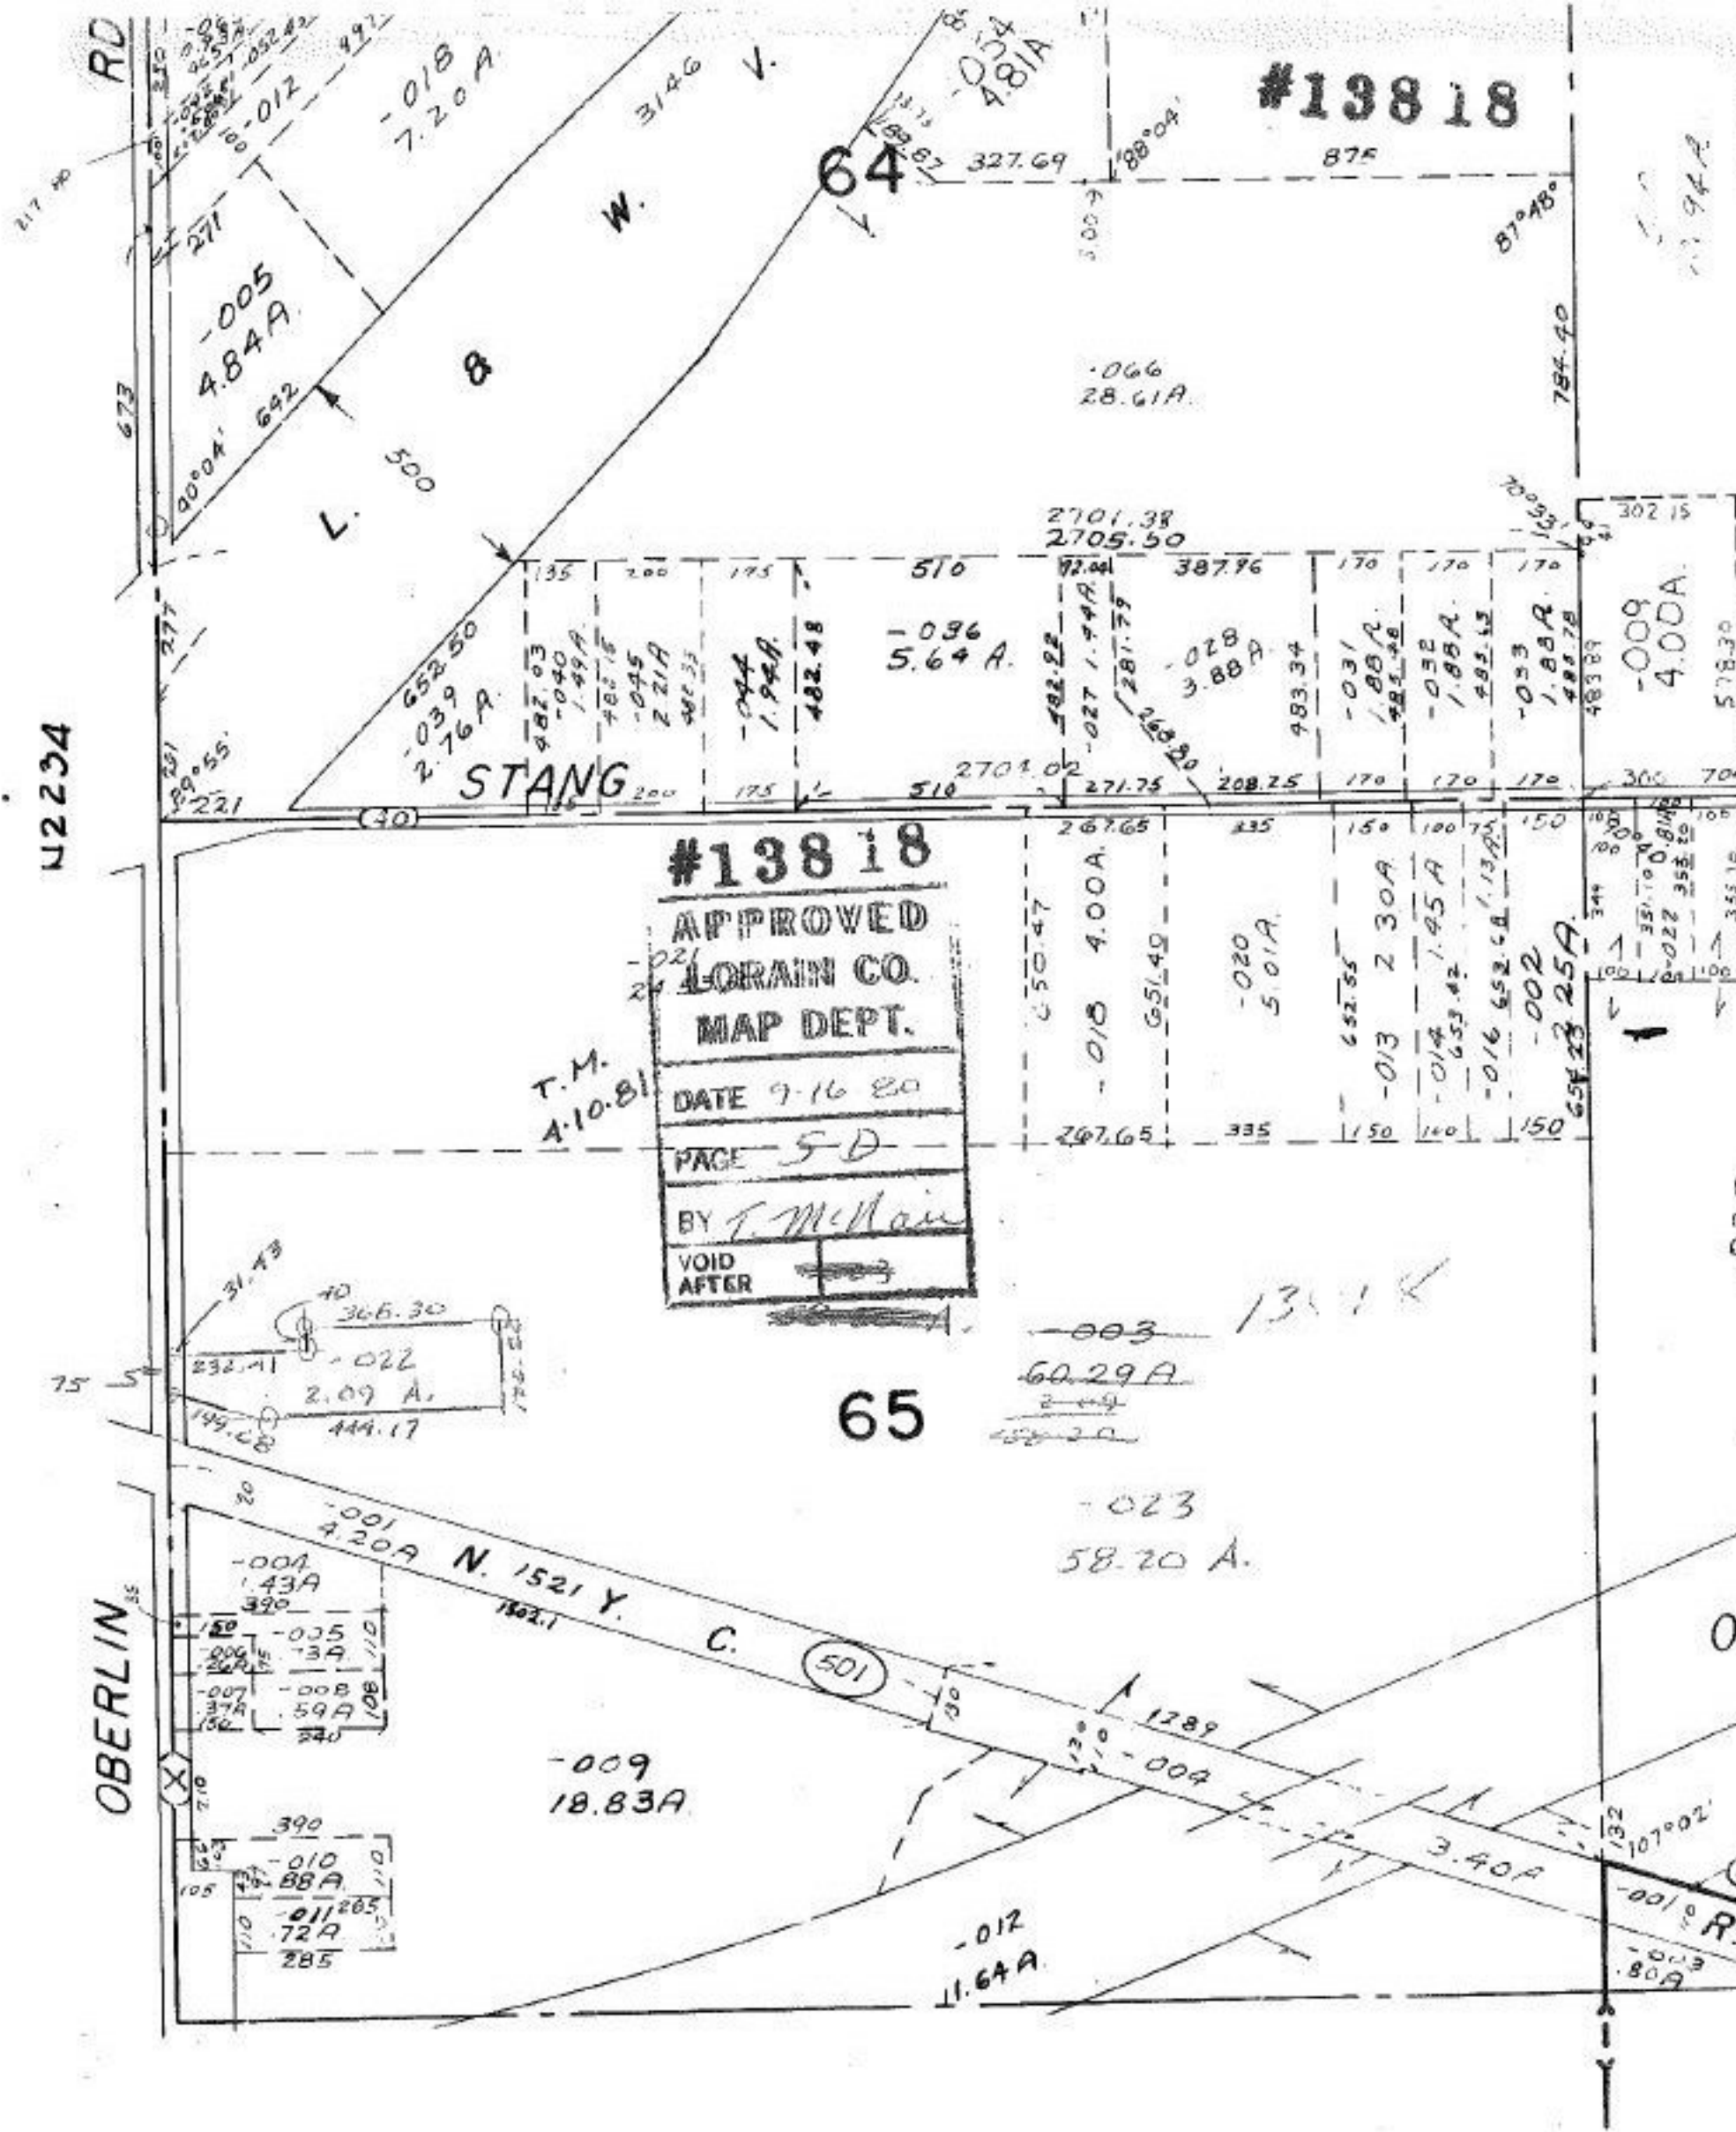

#13818

64

STANG

#13818

APPROVED
LORAIN CO.
MAP DEPT.

DATE 9-16 80

PAGE 5-D

BY T. McNamee

VOID AFTER

T.M.
A-10.81

65

60.29A

58.20 A.

18.83A

11.64A

4.00A