

#13833

PT. 02-03-005-101 -

PT. 02-03-005-101-051

-059

PT. 112.28A.


PT. 111.67A.

13833

#13833

APPROVED LORAIN CO. MAP DEPT.	
DATE 9-25-80	
PAGE 2-03-004-B	
BY Carolyn	
VOID AFTER	13833

T.M.
3-18-81

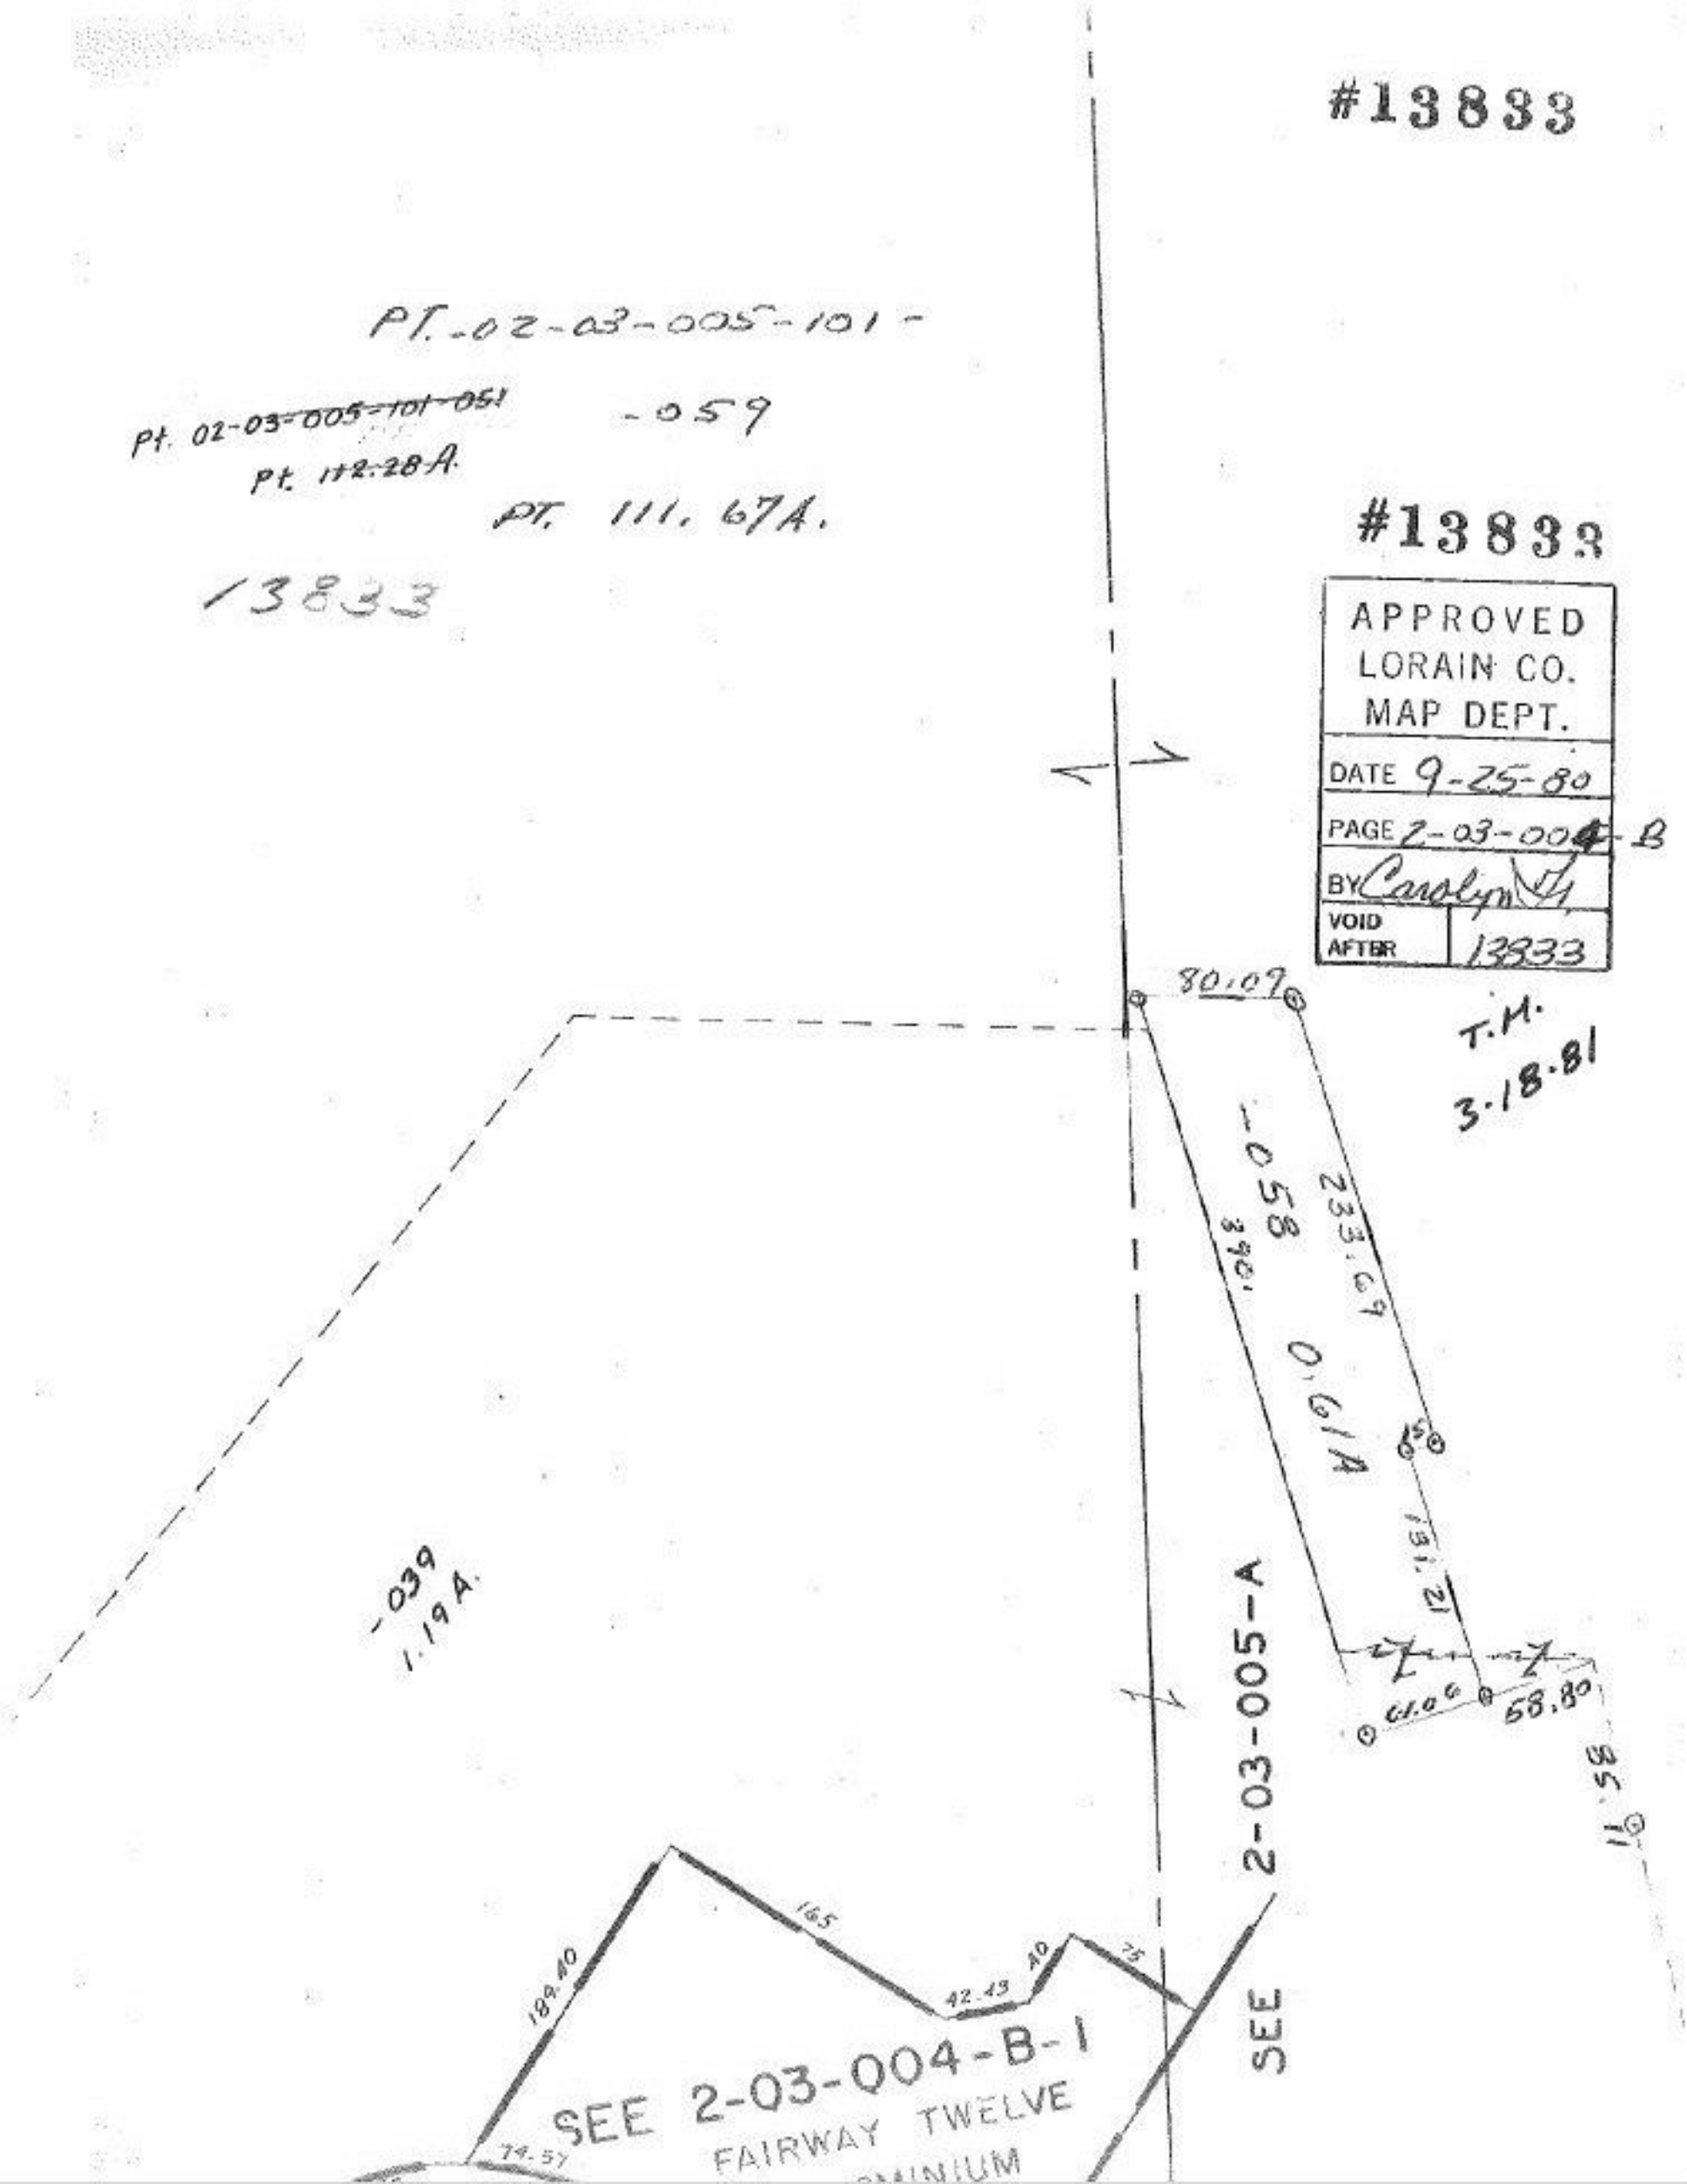

-039
1.19A.

2-03-005-A

SEE 2-03-004-B-1
FAIRWAY TWELVE
MINIMUM

SEE