


#13864

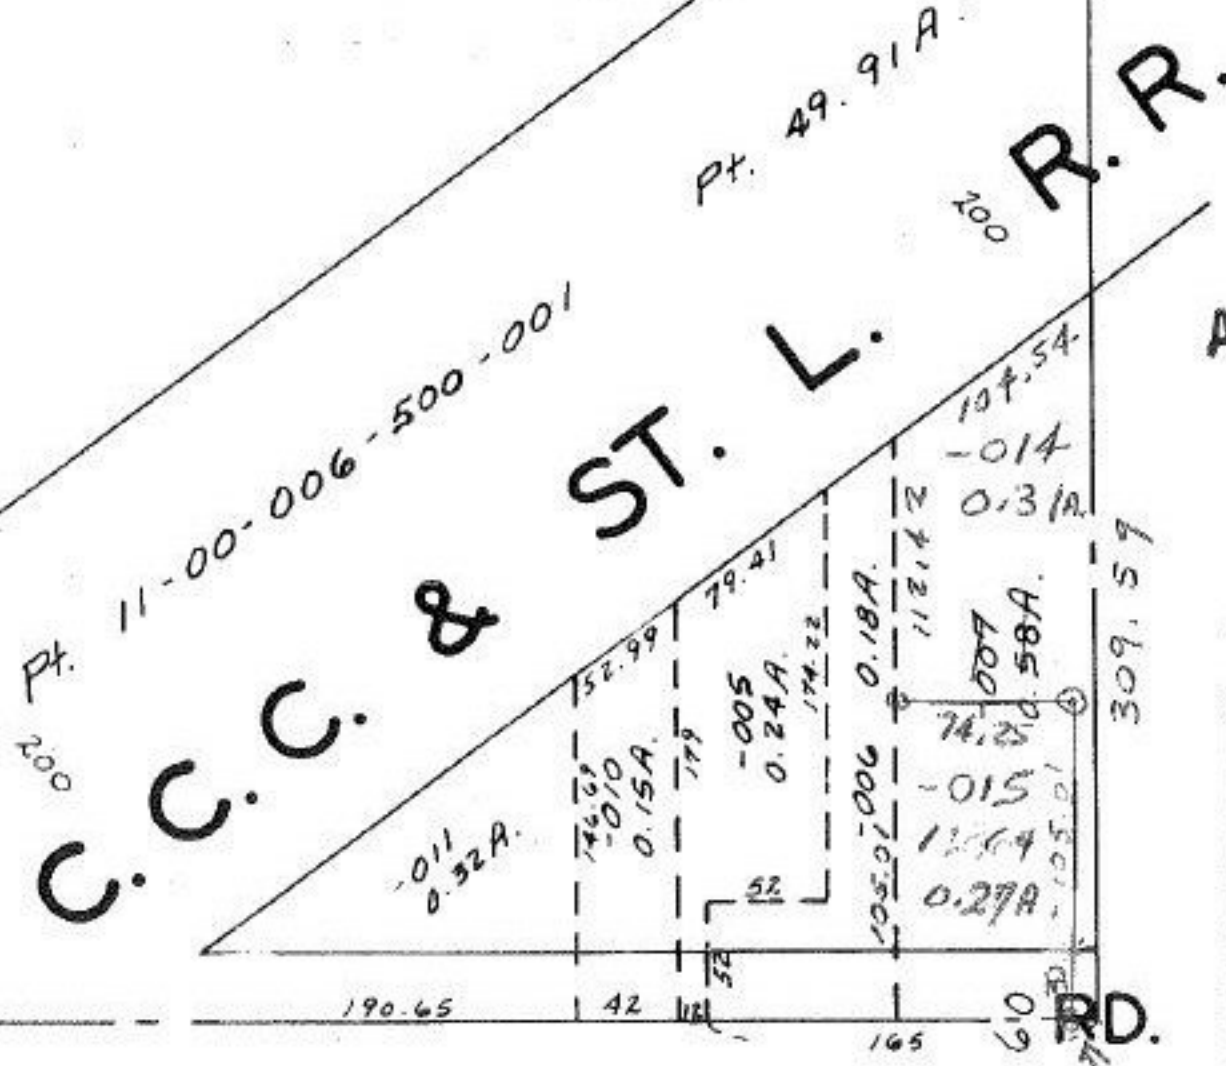

APR 17 1981

*[Handwritten signature]*

#13864

APPROVED	
LORAIN CO.	
MAP DEPT.	
DATE 10-15-80	
PAGE 11-00-015-B	
BY Carolyn J.	
VOID AFTER	13864

B