


#13866

EE 3-00-102-A

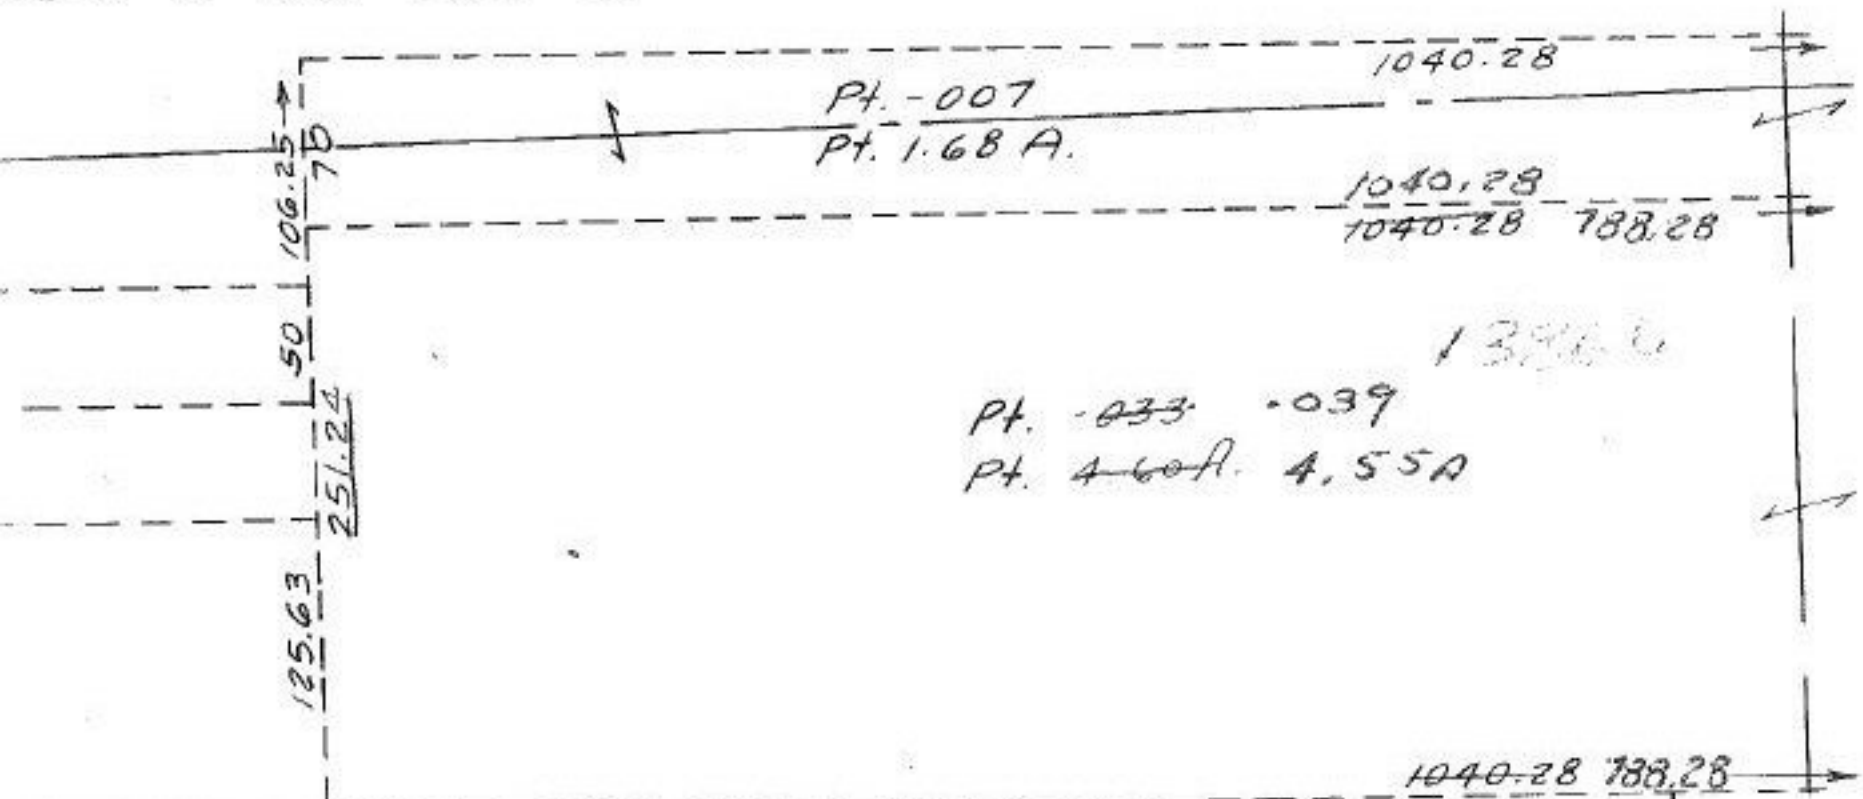

13866  
 Pt. -033 -039  
 Pt. 4.60 A. 4.55 A

#13866

APPROVED LORAIN CO. MAP DEPT.	
DATE 10-15-80	
PAGE 03-00-107-A	
BY <i>Caroline</i>	
VOID AFTER	13866

T.M.  
A.B.81

Pt. -037  
 Pt. 8.63 A.

101

502.49

89°45'

124.81

5.87° 51' E.

572.20

1040.28 788.28

1040.28

Pt. -007  
Pt. 1.68 A.

1040.28  
1040.28 788.28

106.25

50

251.22

125.63