


SEE 4-L

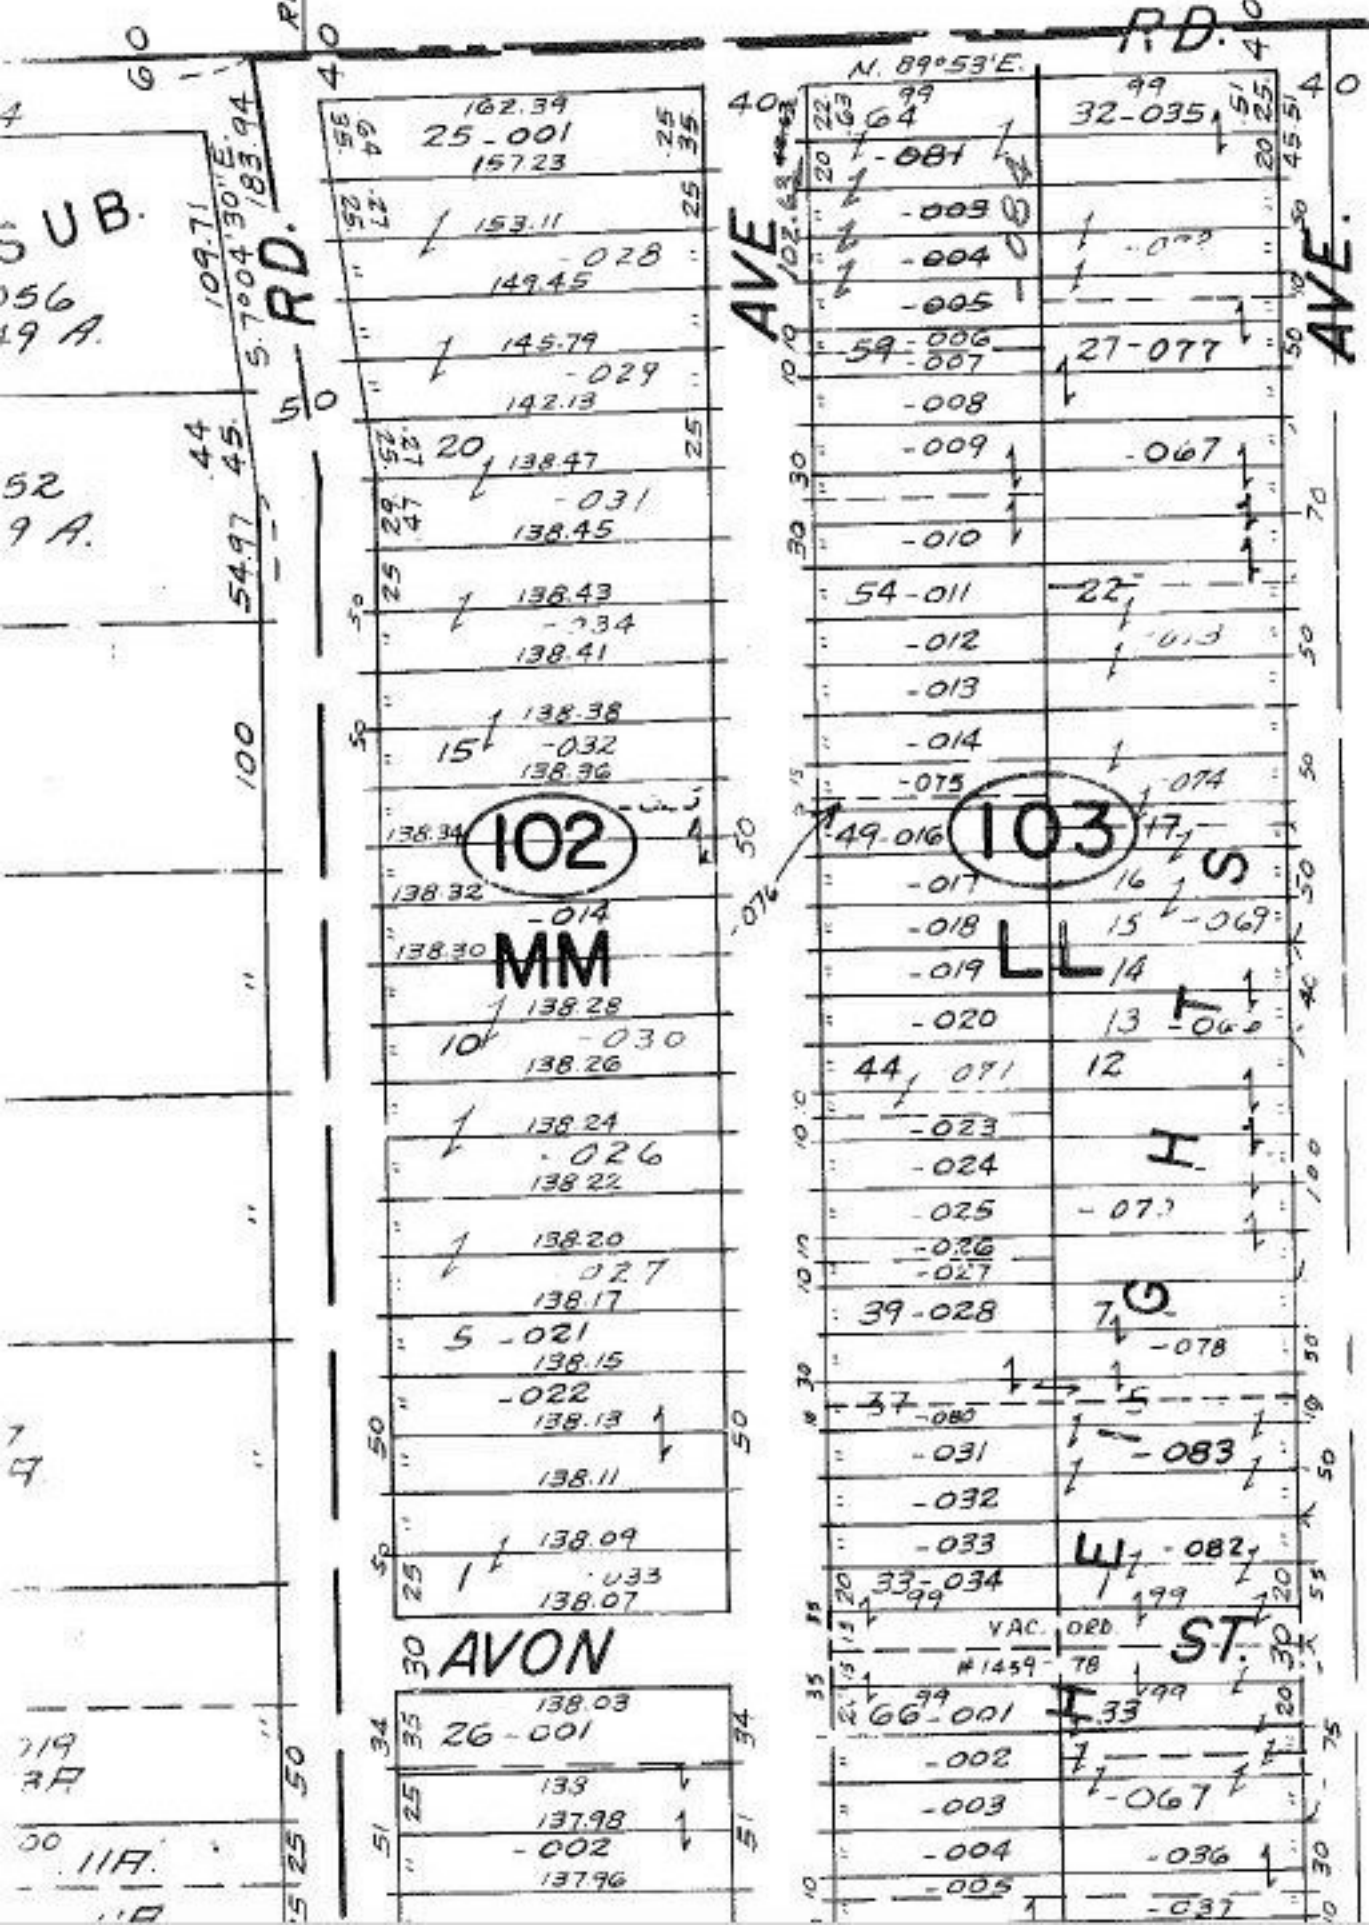

#13875

APPROVED LORAIN CO. MAP DEPT.
DATE 10-22-80
PAGE 7-00-007A
BY <i>[Signature]</i>
VOID AFTER

17-B