


#13879

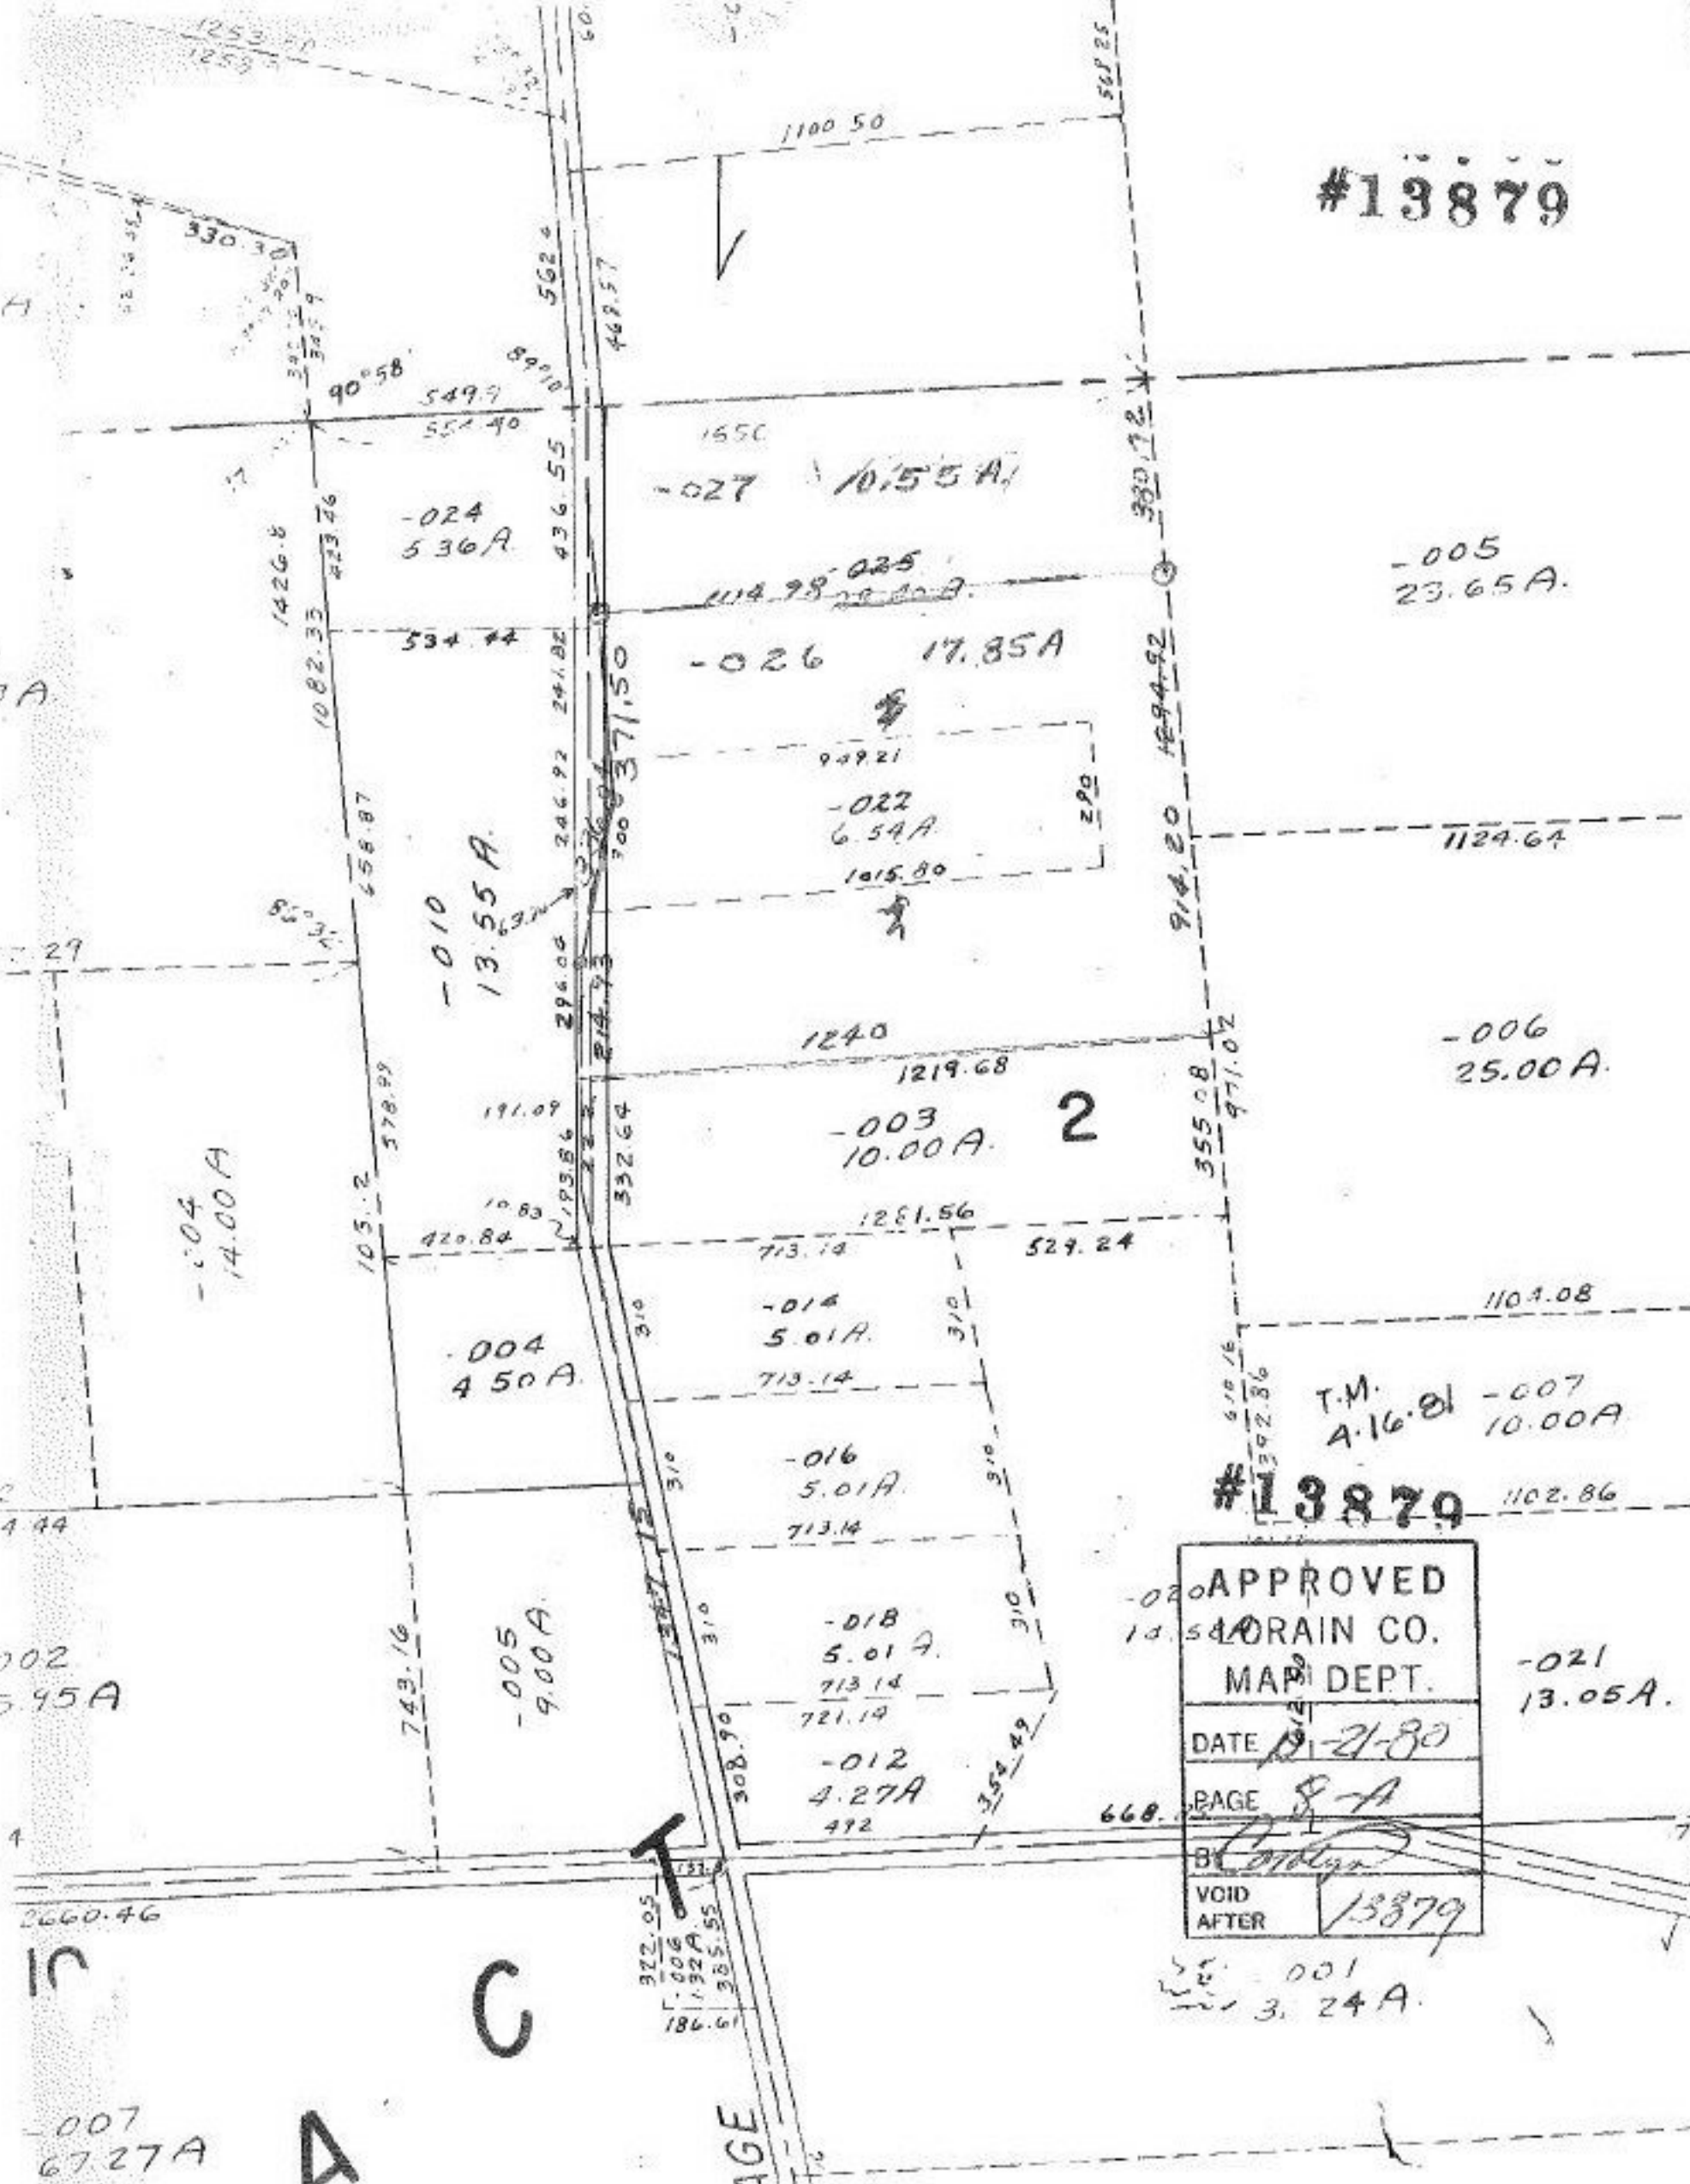

#13879

APPROVED	
MORAIN CO. MAP DEPT.	
DATE	11-21-80
PAGE	8-A
BY	[Signature]
VOID AFTER	13879

001
3.24 A.

007
67.27 A

A

C

AGE