


#13895  
Pt. 03-00-012-000-023

APPROVED  
LORAIN CO.  
MAP DEPT.  
DATE 11-3-80  
PAGE 3-00-11-B  
BY [Signature]  
VOID AFTER 13895

101

#13895

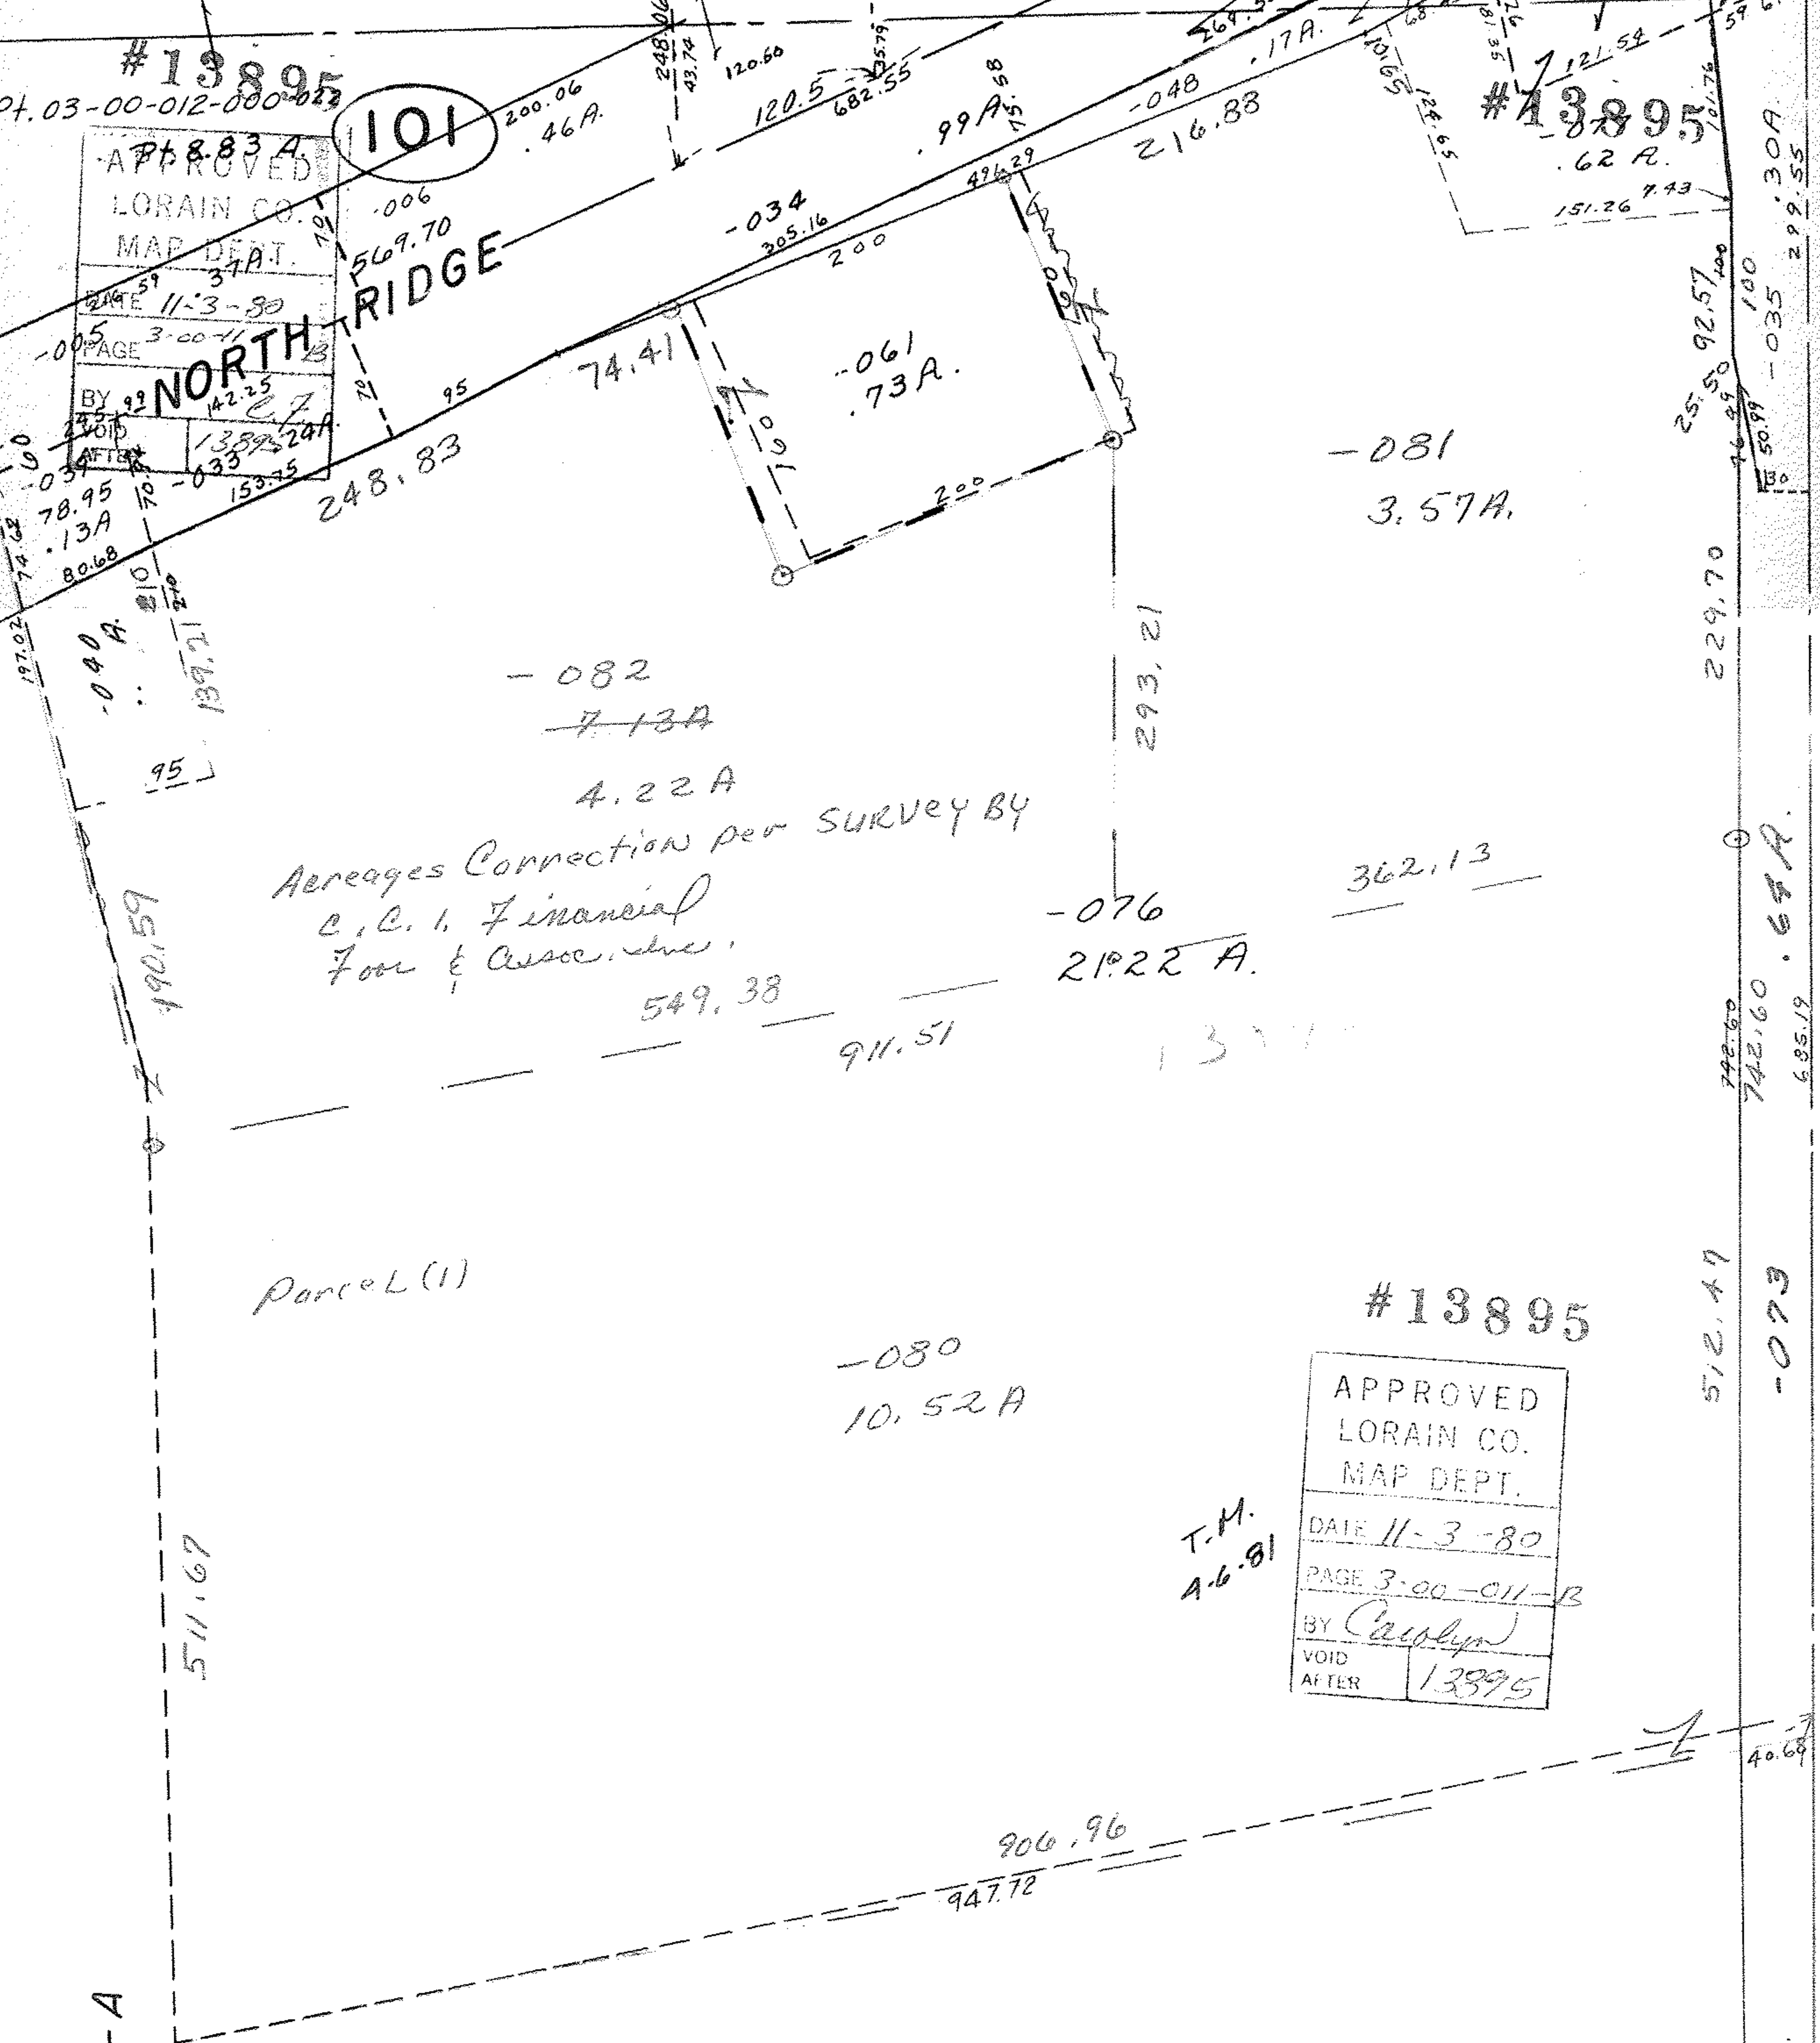

Acreages Correction per SURVEY BY  
C.C.I. Financial  
For & Assoc. Inc.  
4.22 A

Parcel L(1)

#13895  
APPROVED  
LORAIN CO.  
MAP DEPT.  
DATE 11-3-80  
PAGE 3-00-011-B  
BY [Signature]  
VOID AFTER 13895

T.M.  
4-6-81

1-A

9.