


6-47

APPROVED LORAIN CO. MAP DEPT.	
DATE 11-4-80	
PAGE 6-65	
BY Carolyn F	
VOID AFTER	13896

T.M.
4-14-81

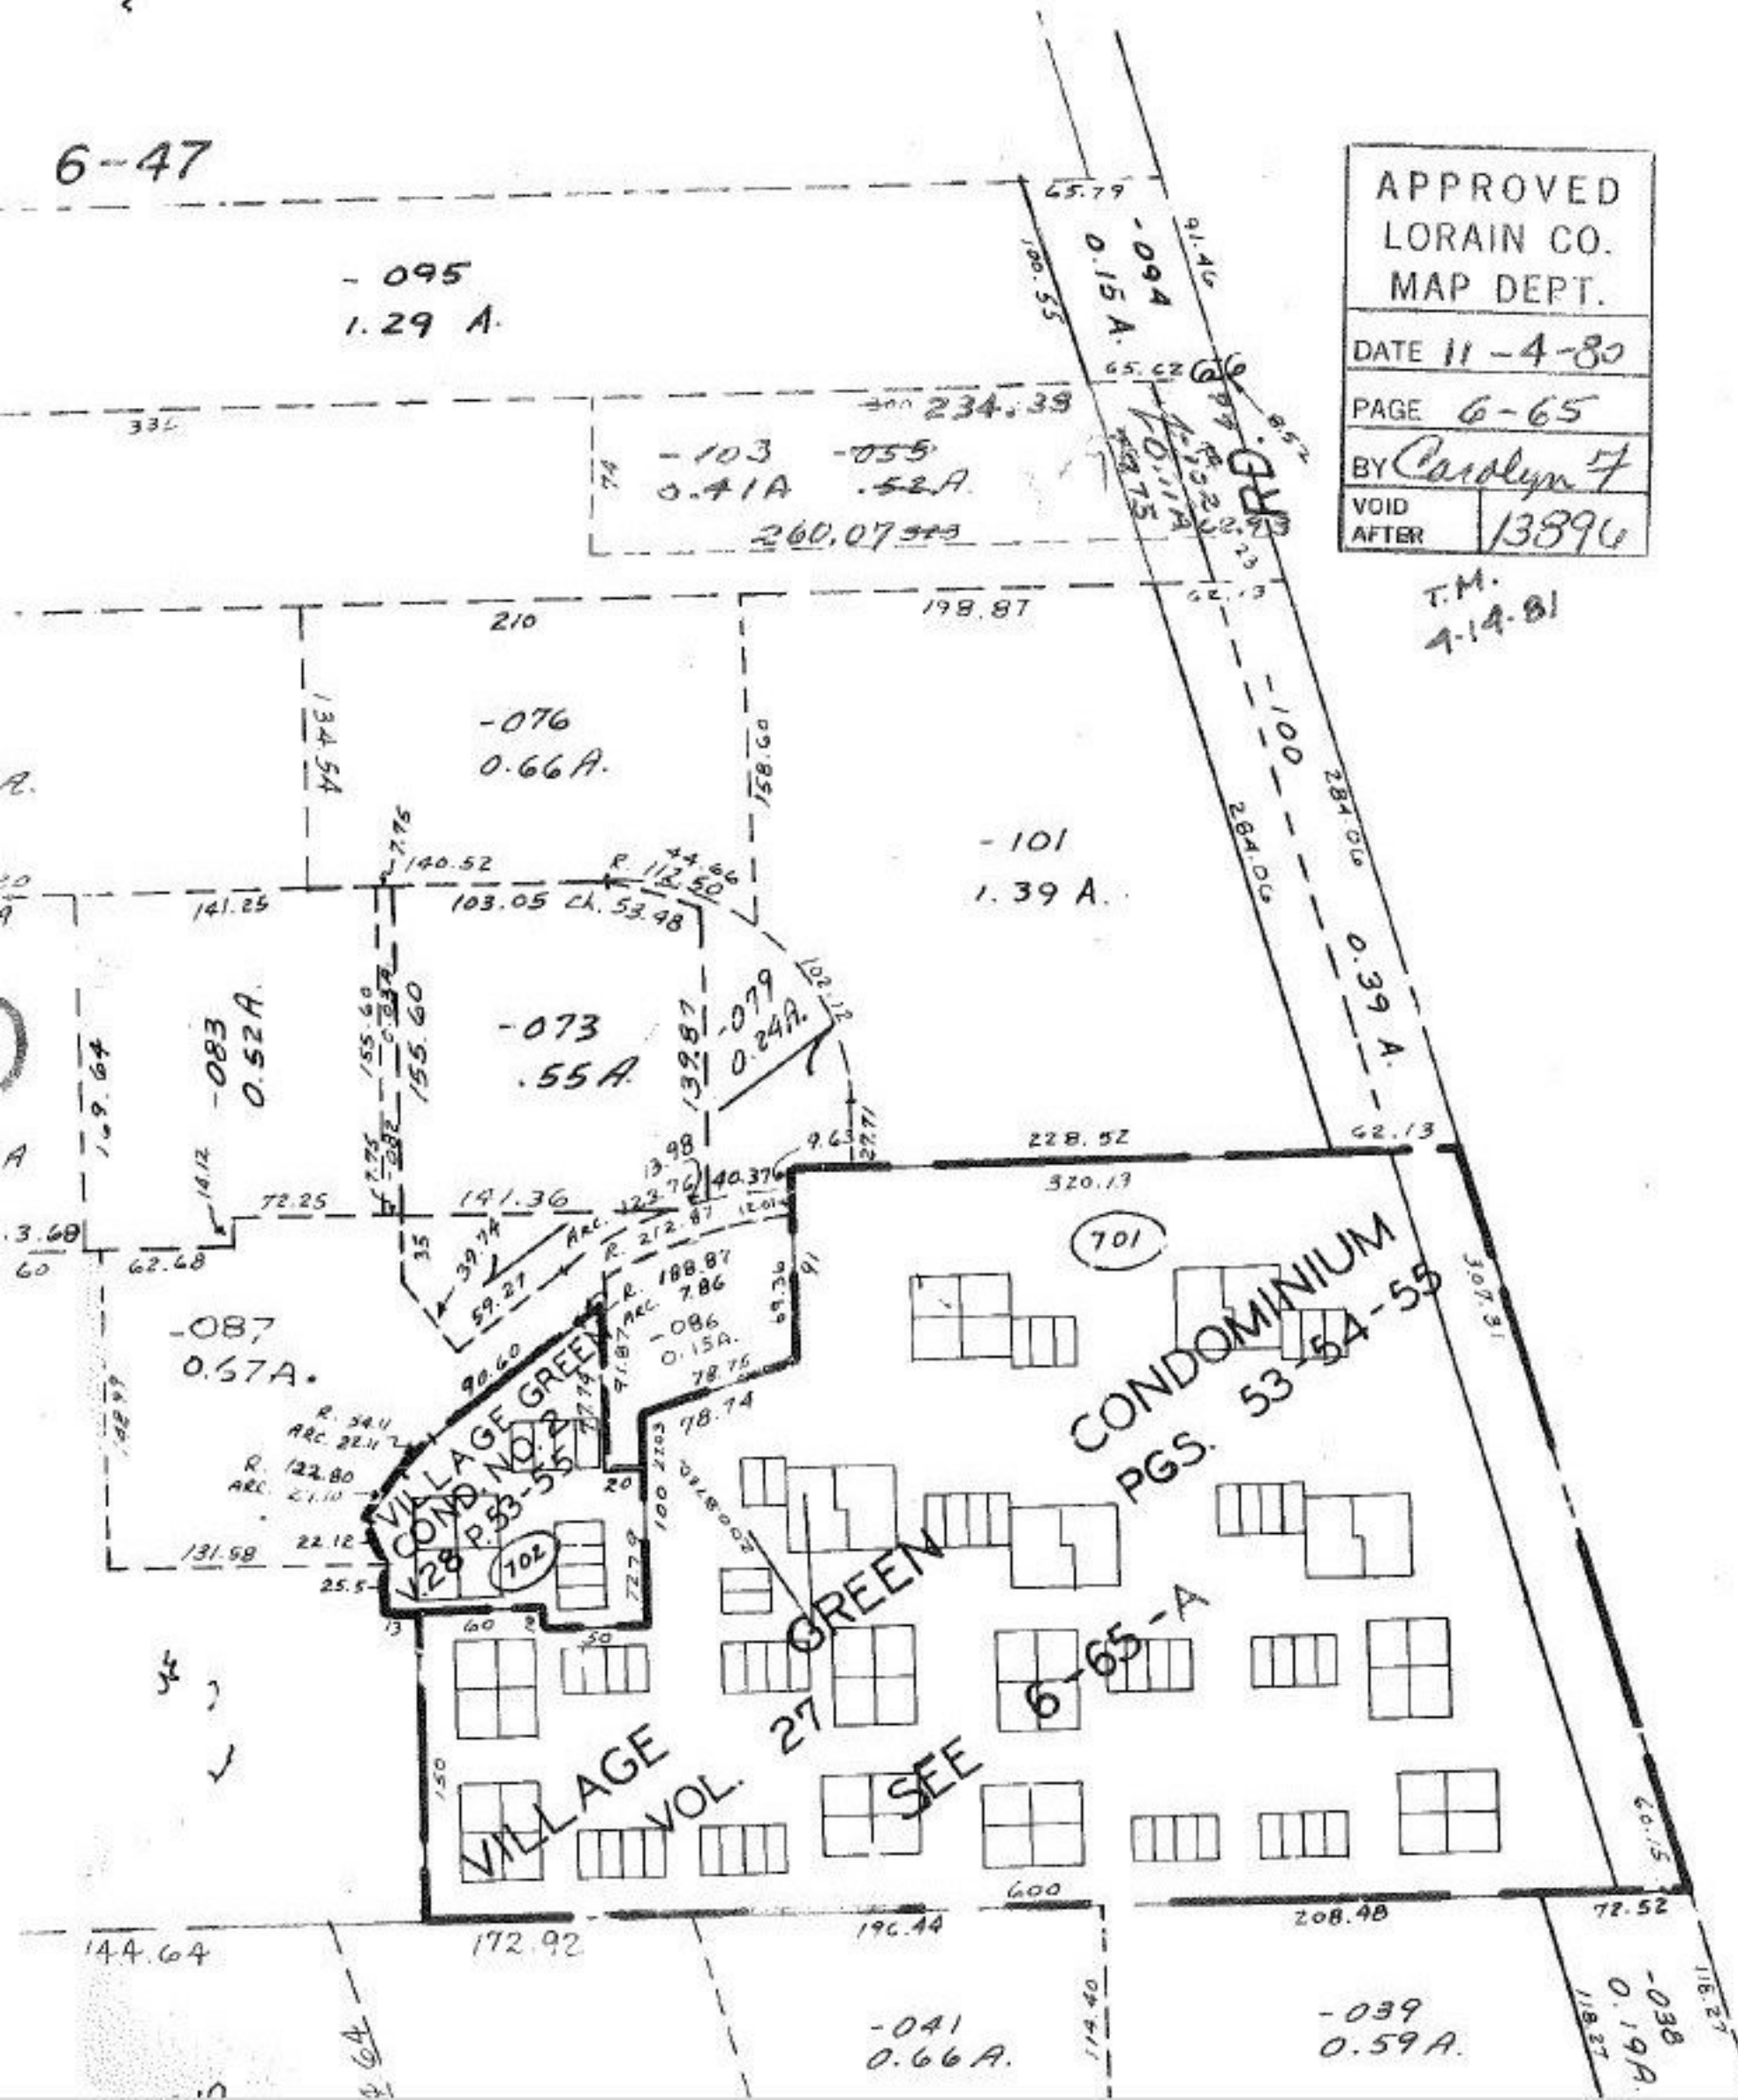

- 095
1.29 A.

234.39
- 103 - 055
0.41A .52A
260.07

- 076
0.66 A.

- 101
1.39 A.

- 073
.55 A.

- 079
0.24 A.

- 087
0.67 A.

- 083
0.52 A.

R. 54.11
ARC. 22.11
R. 122.80
ARC. 21.10

VILLAGE GREEN
COND. NO. 28
PGS. 53-55
702

701
COND. NO. 28
PGS. 53-54-55

VILLAGE GREEN
VOL. 27
SEE 6-65-A

- 041
0.66 A.

- 039
0.59 A.

- 038
0.19 A.