
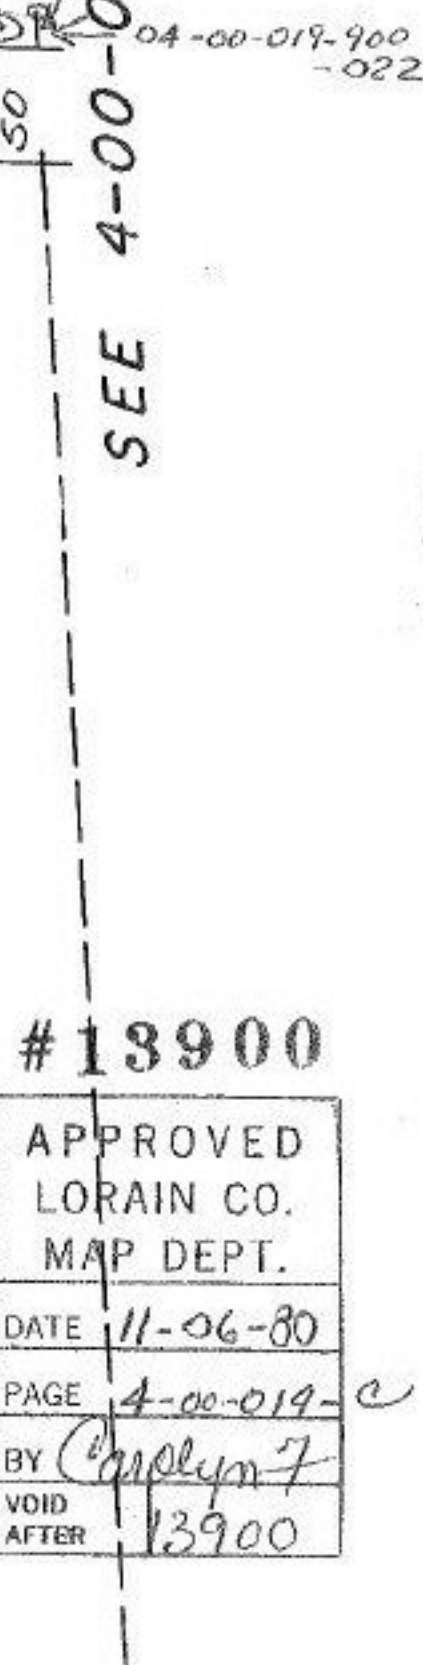
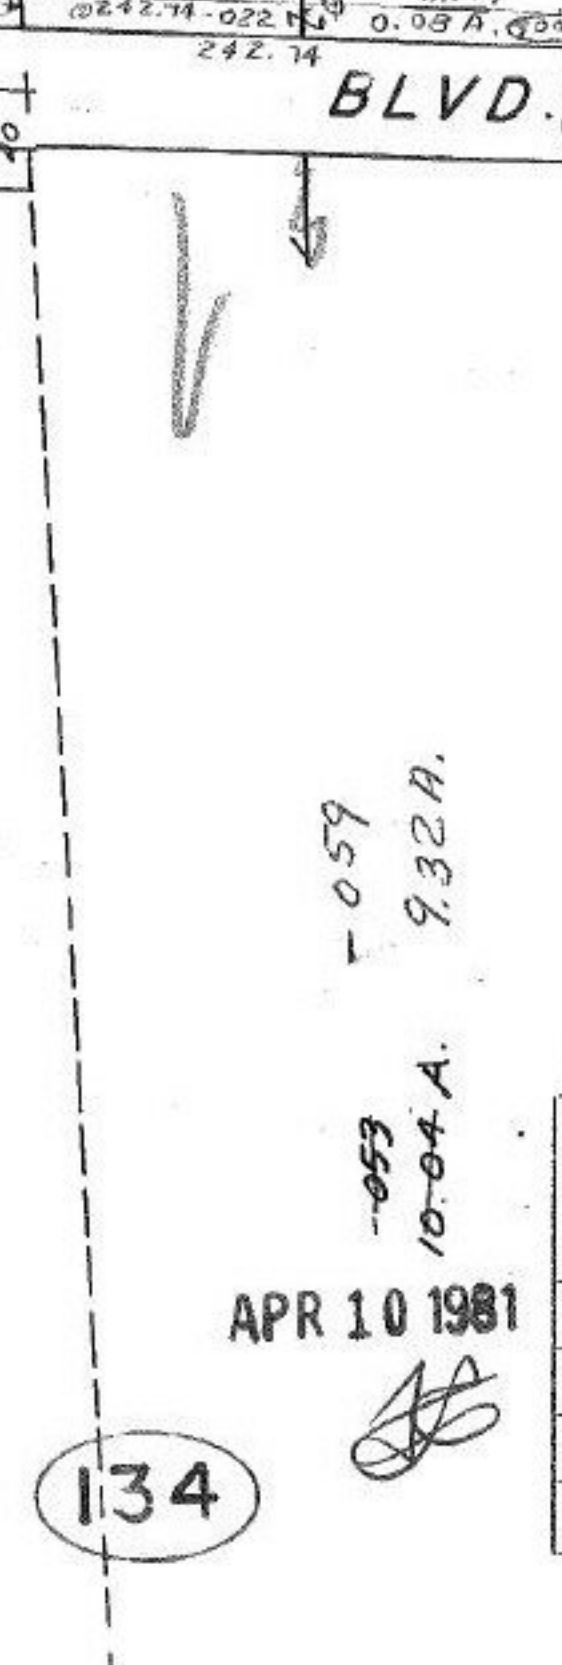
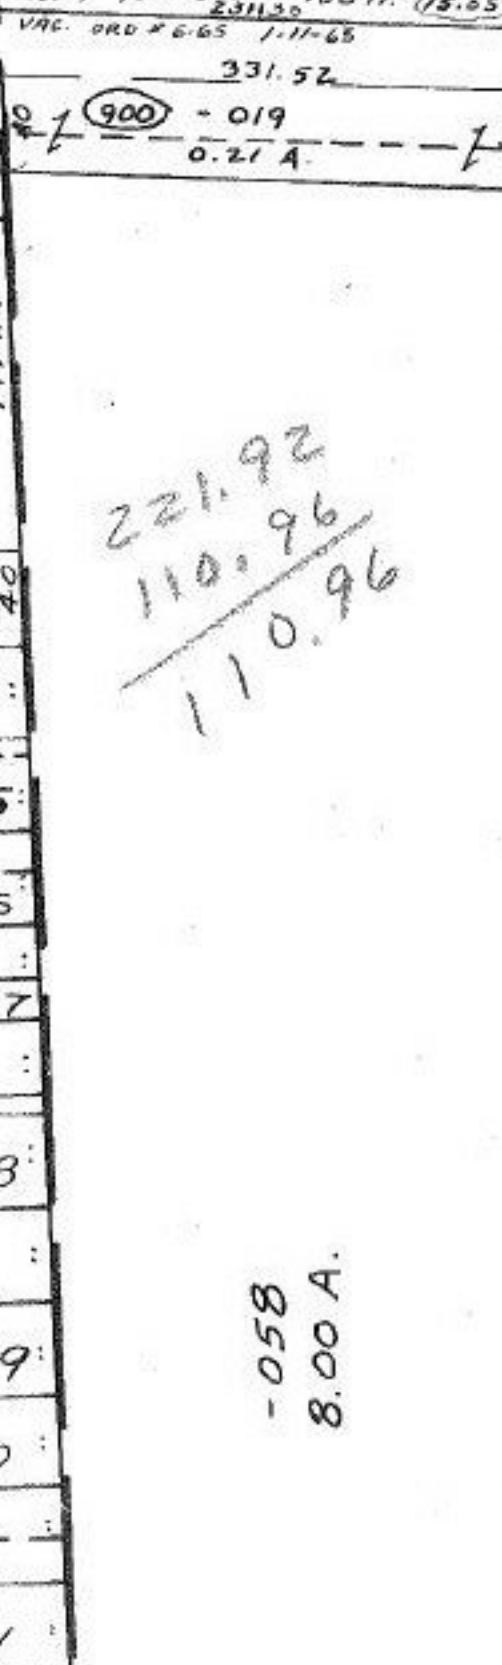
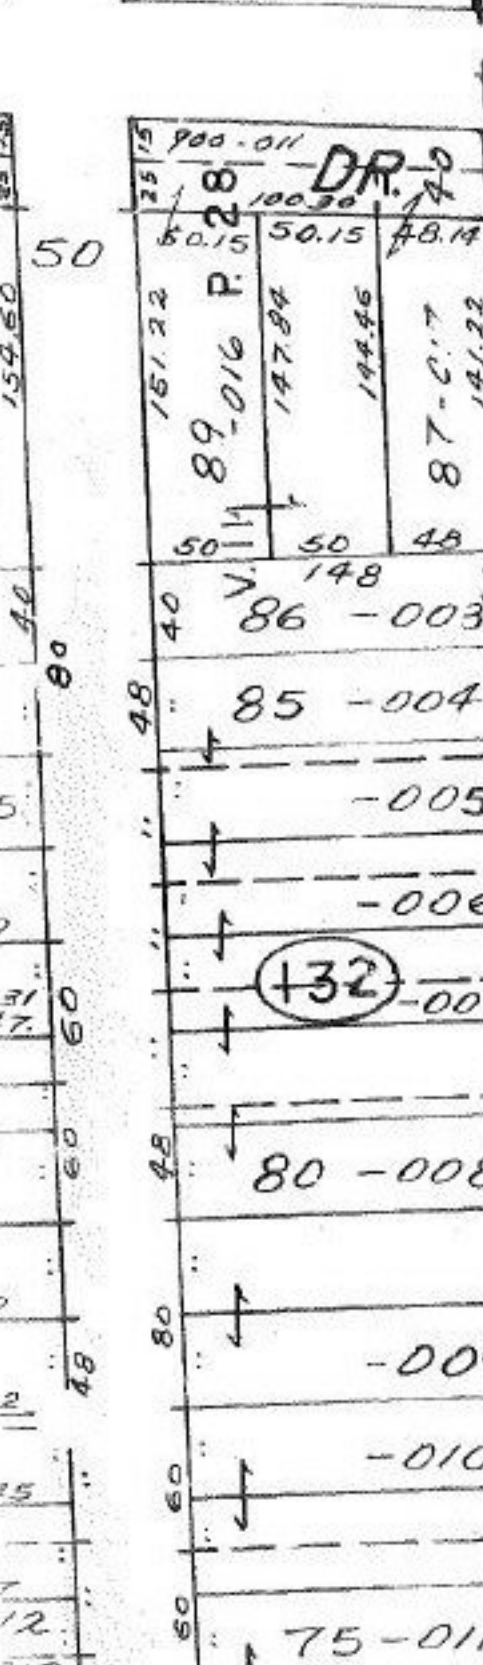
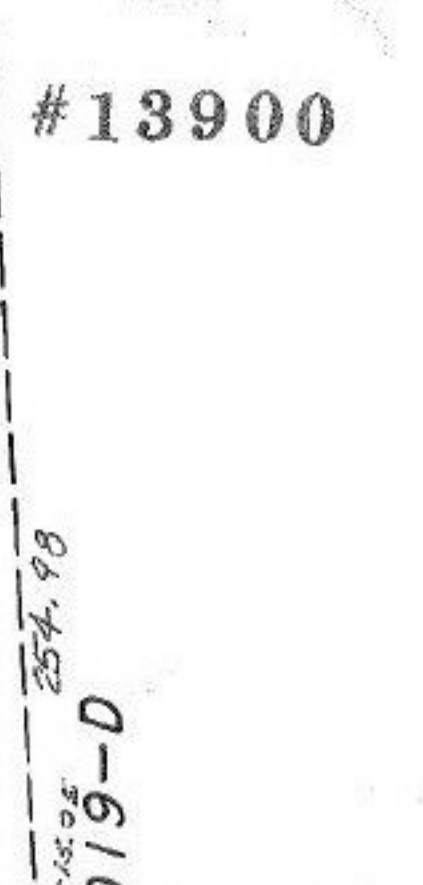
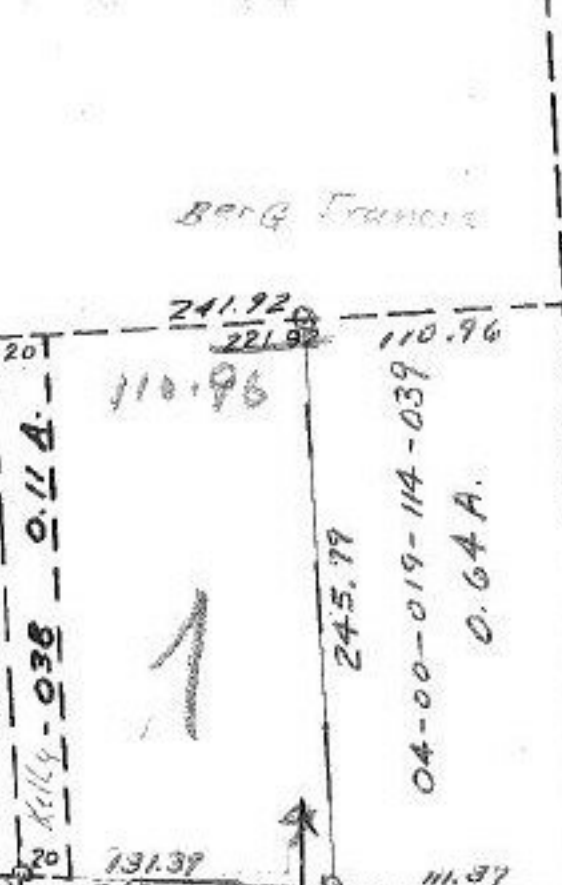
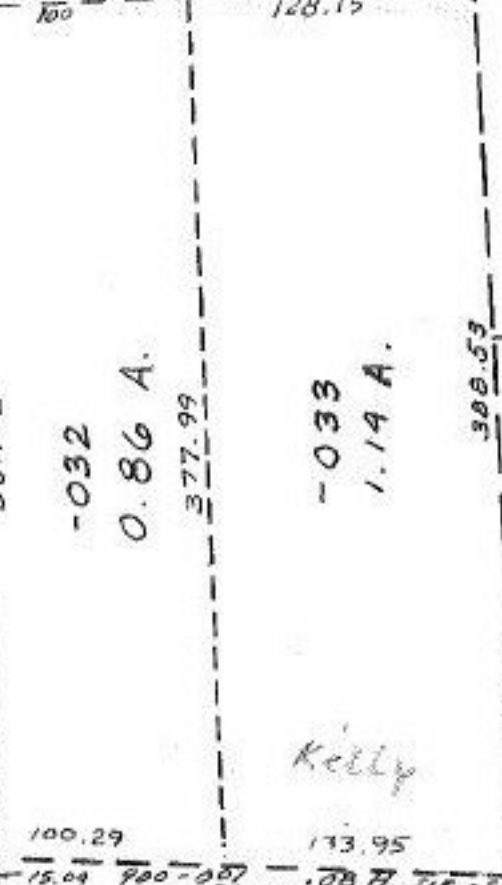


#13900

Berg Francis

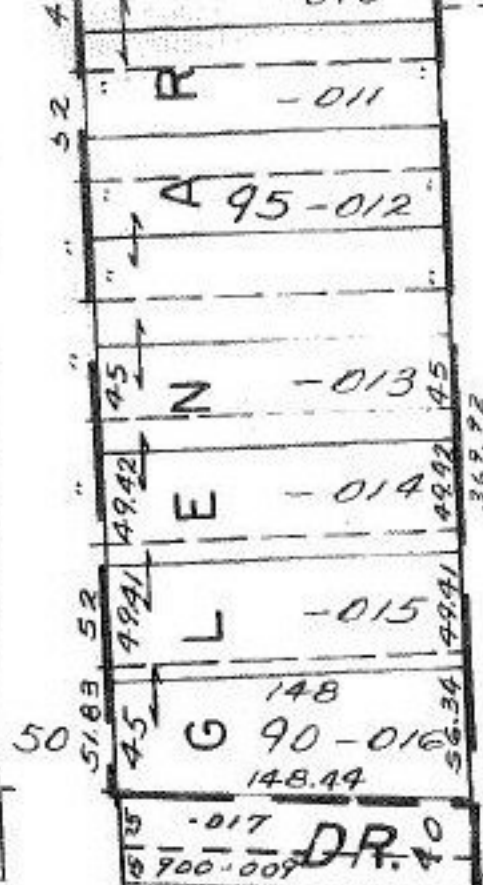

BLVD.

SEE 4-00-019-D

#13900

APPROVED LORAIN CO. MAP DEPT.	
DATE	11-06-80
PAGE	4-00-019-C
BY	Carolyn 7
VOID AFTER	13900

APR 10 1981

(134)

-059
10-04 A. 9.32 A.

-058
8.00 A.