


05-00-031-B

#13939

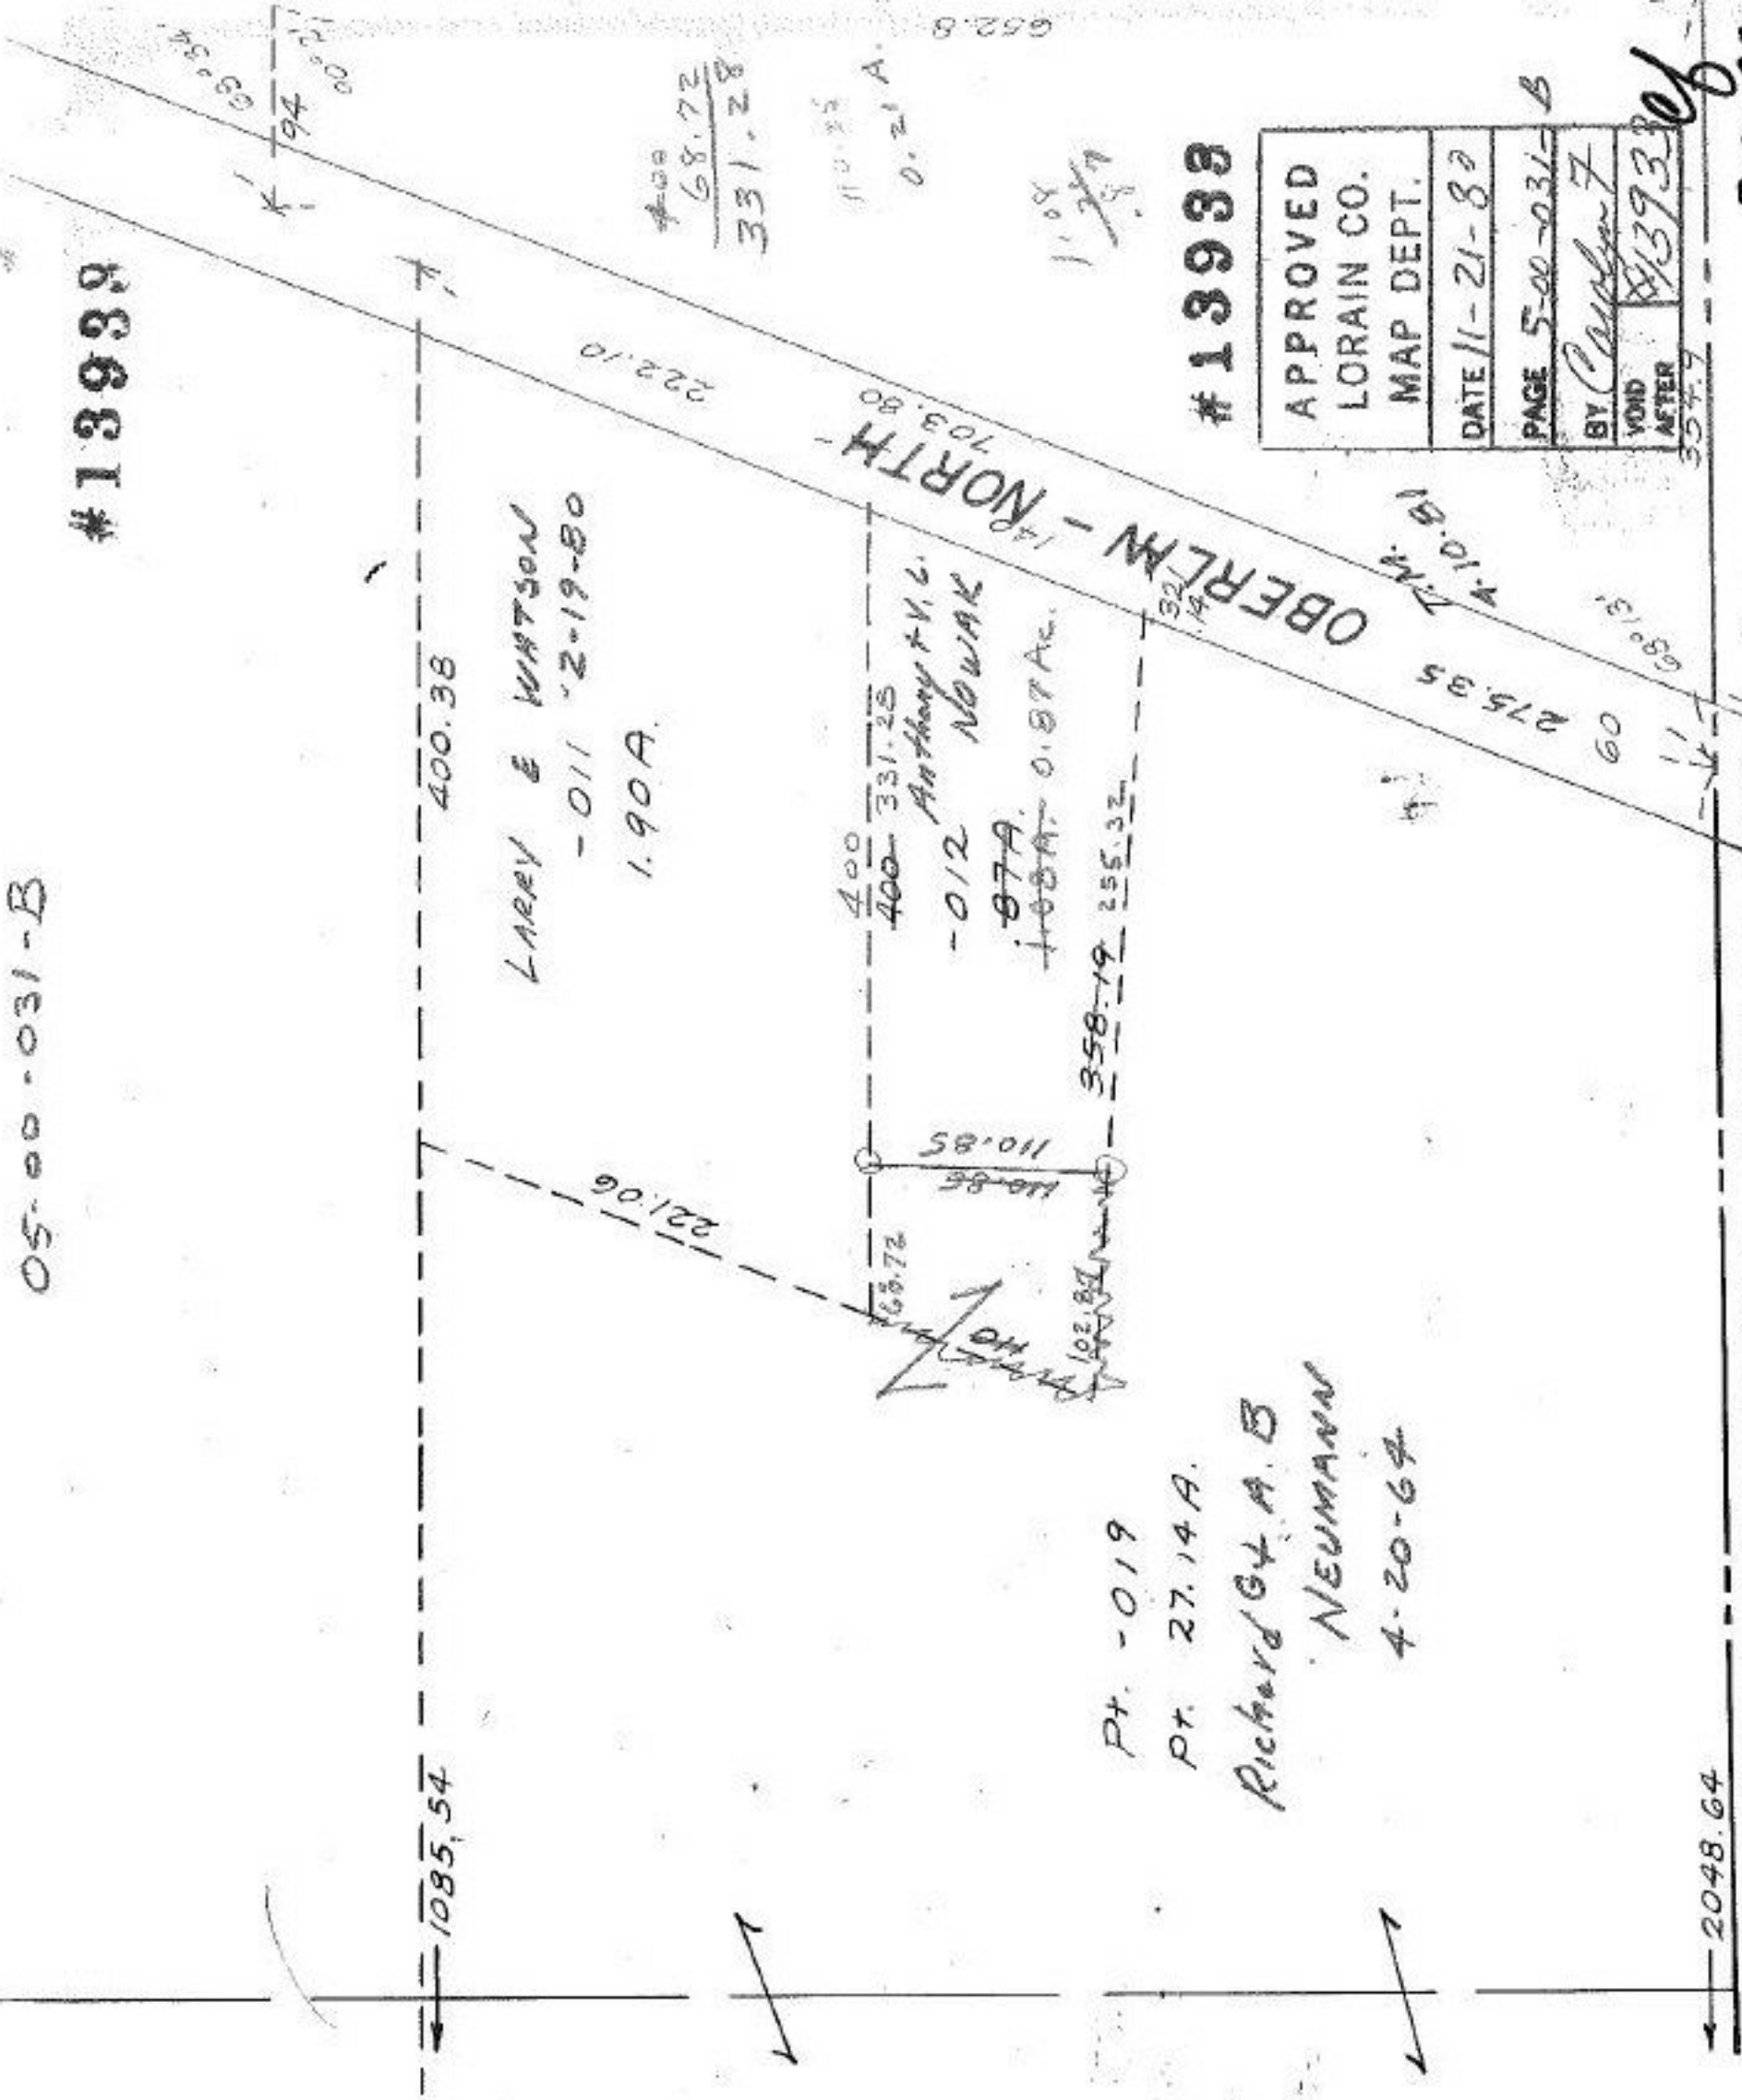

1085.54

400.38

LARRY E WATSON  
-011-2-19-80  
1.90A.

400  
400 331.25

Anthony F.V. G.  
NOWAK  
-012-07A.  
1.08A. 0.87Ac.

358.19 255.32

Pt. -019

Pt. 27.14A.

Richard G. A. B  
NEUMANN  
4-20-64

68.72  
331.28

110.35  
0.21A.

1.08  
1.27

#13939

APPROVED	LORAIN CO. MAP DEPT.
DATE 11-21-80	
PAGE 5-00-031-B	BY <i>Carlson</i>
VOID AFTER	8/3939

2048.64

58

8-21-80