


LORAIN COUNTY MAP DEPT.  
P. P. No. 18964

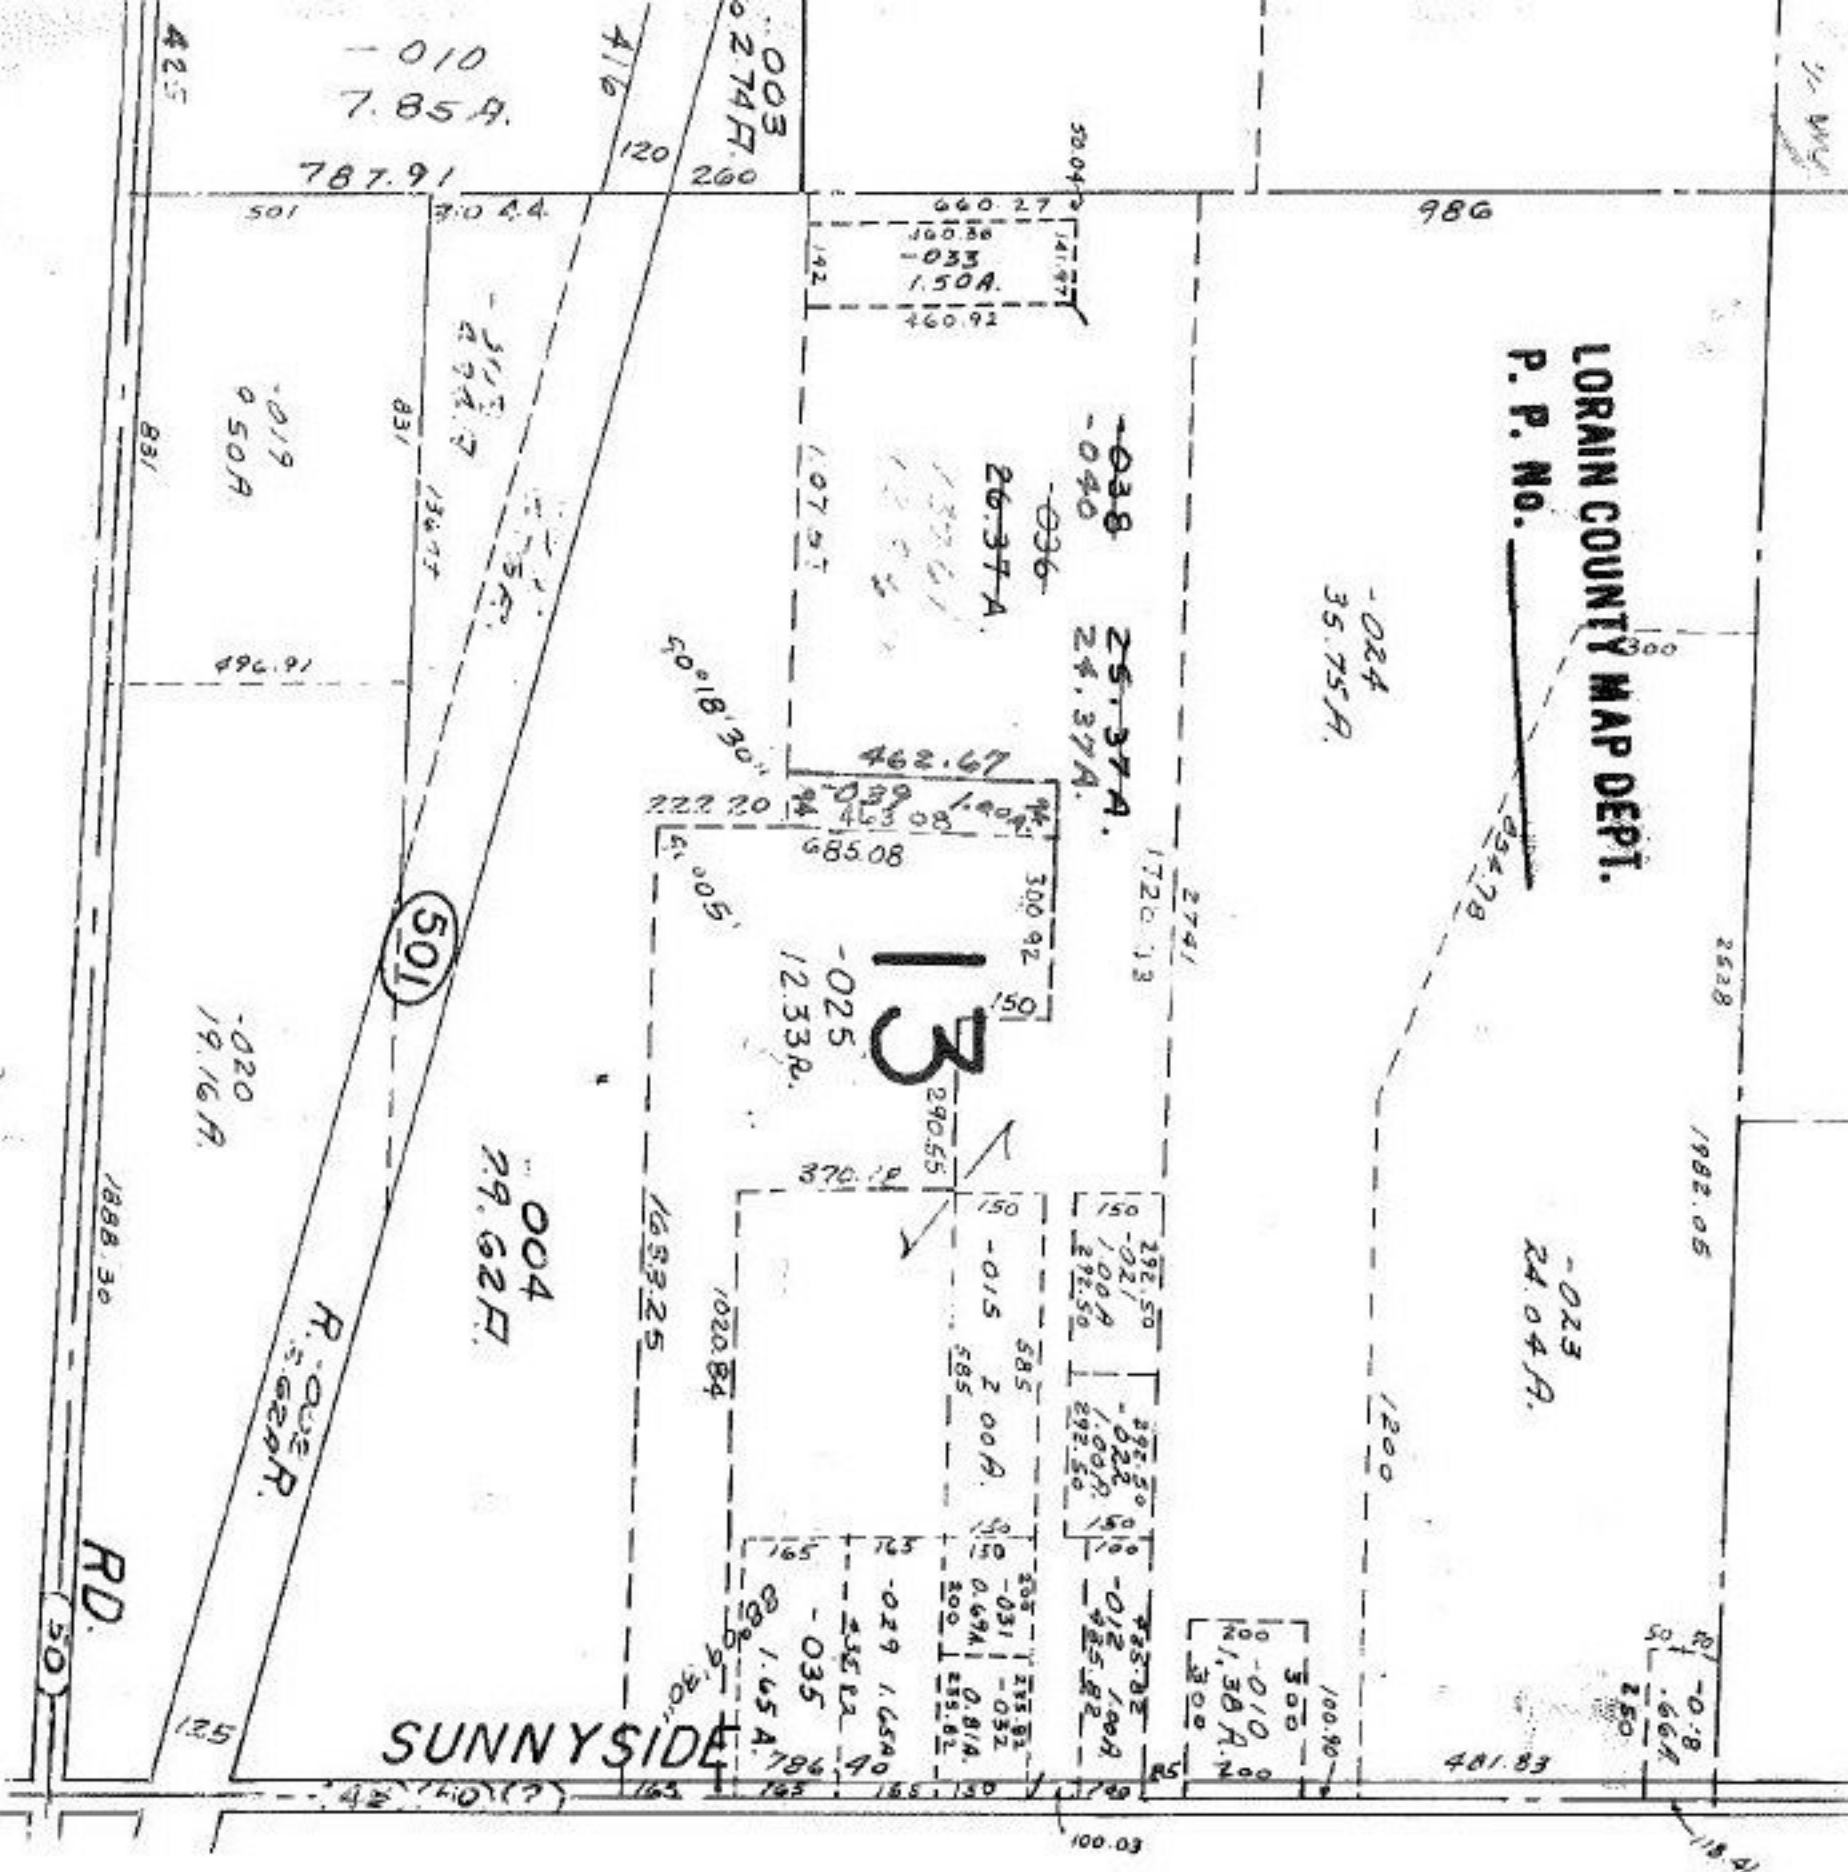

APPROVED	
LORAIN CO.	
MAP DEPT.	
DATE	12-10-80
PAGE	1-8
BY	<i>Applicant</i>
VOID AFTER	

#18964

18964  
12-10-80