

#13967

1387

-002

18.75 A.

1401.8

585.6

-001
49.00 A.

8



-006
80.89 A.

#13967

APPROVED
LORAIN CO
MAP DEPT.
DATE 12-10-80
PAGE 19-E
BY Carolyn
VOID AFTER #13967

MAR 23 1981
R

435.60
217.80
653.40

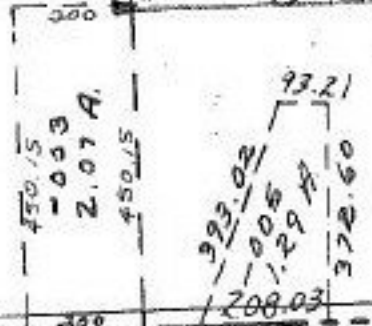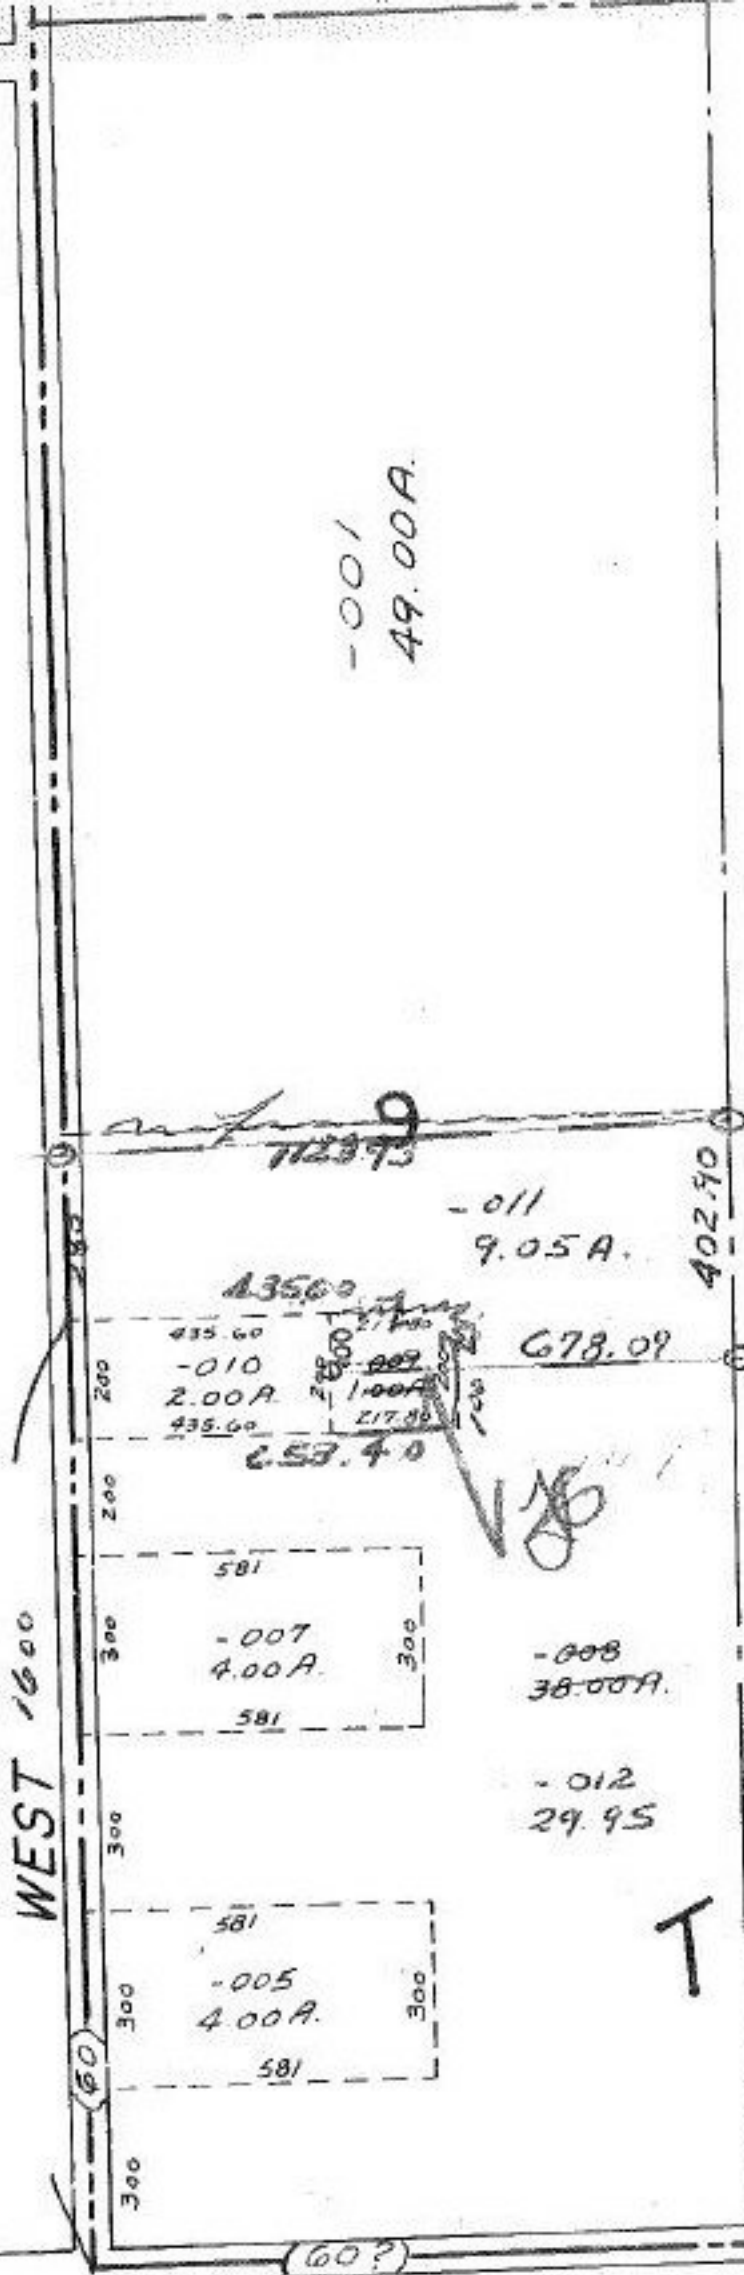

SMITH

PENFIELD TWP.

SCALE: 1" = 400'

Copyright 1962

7 24 80

19-E