


#13969

SE

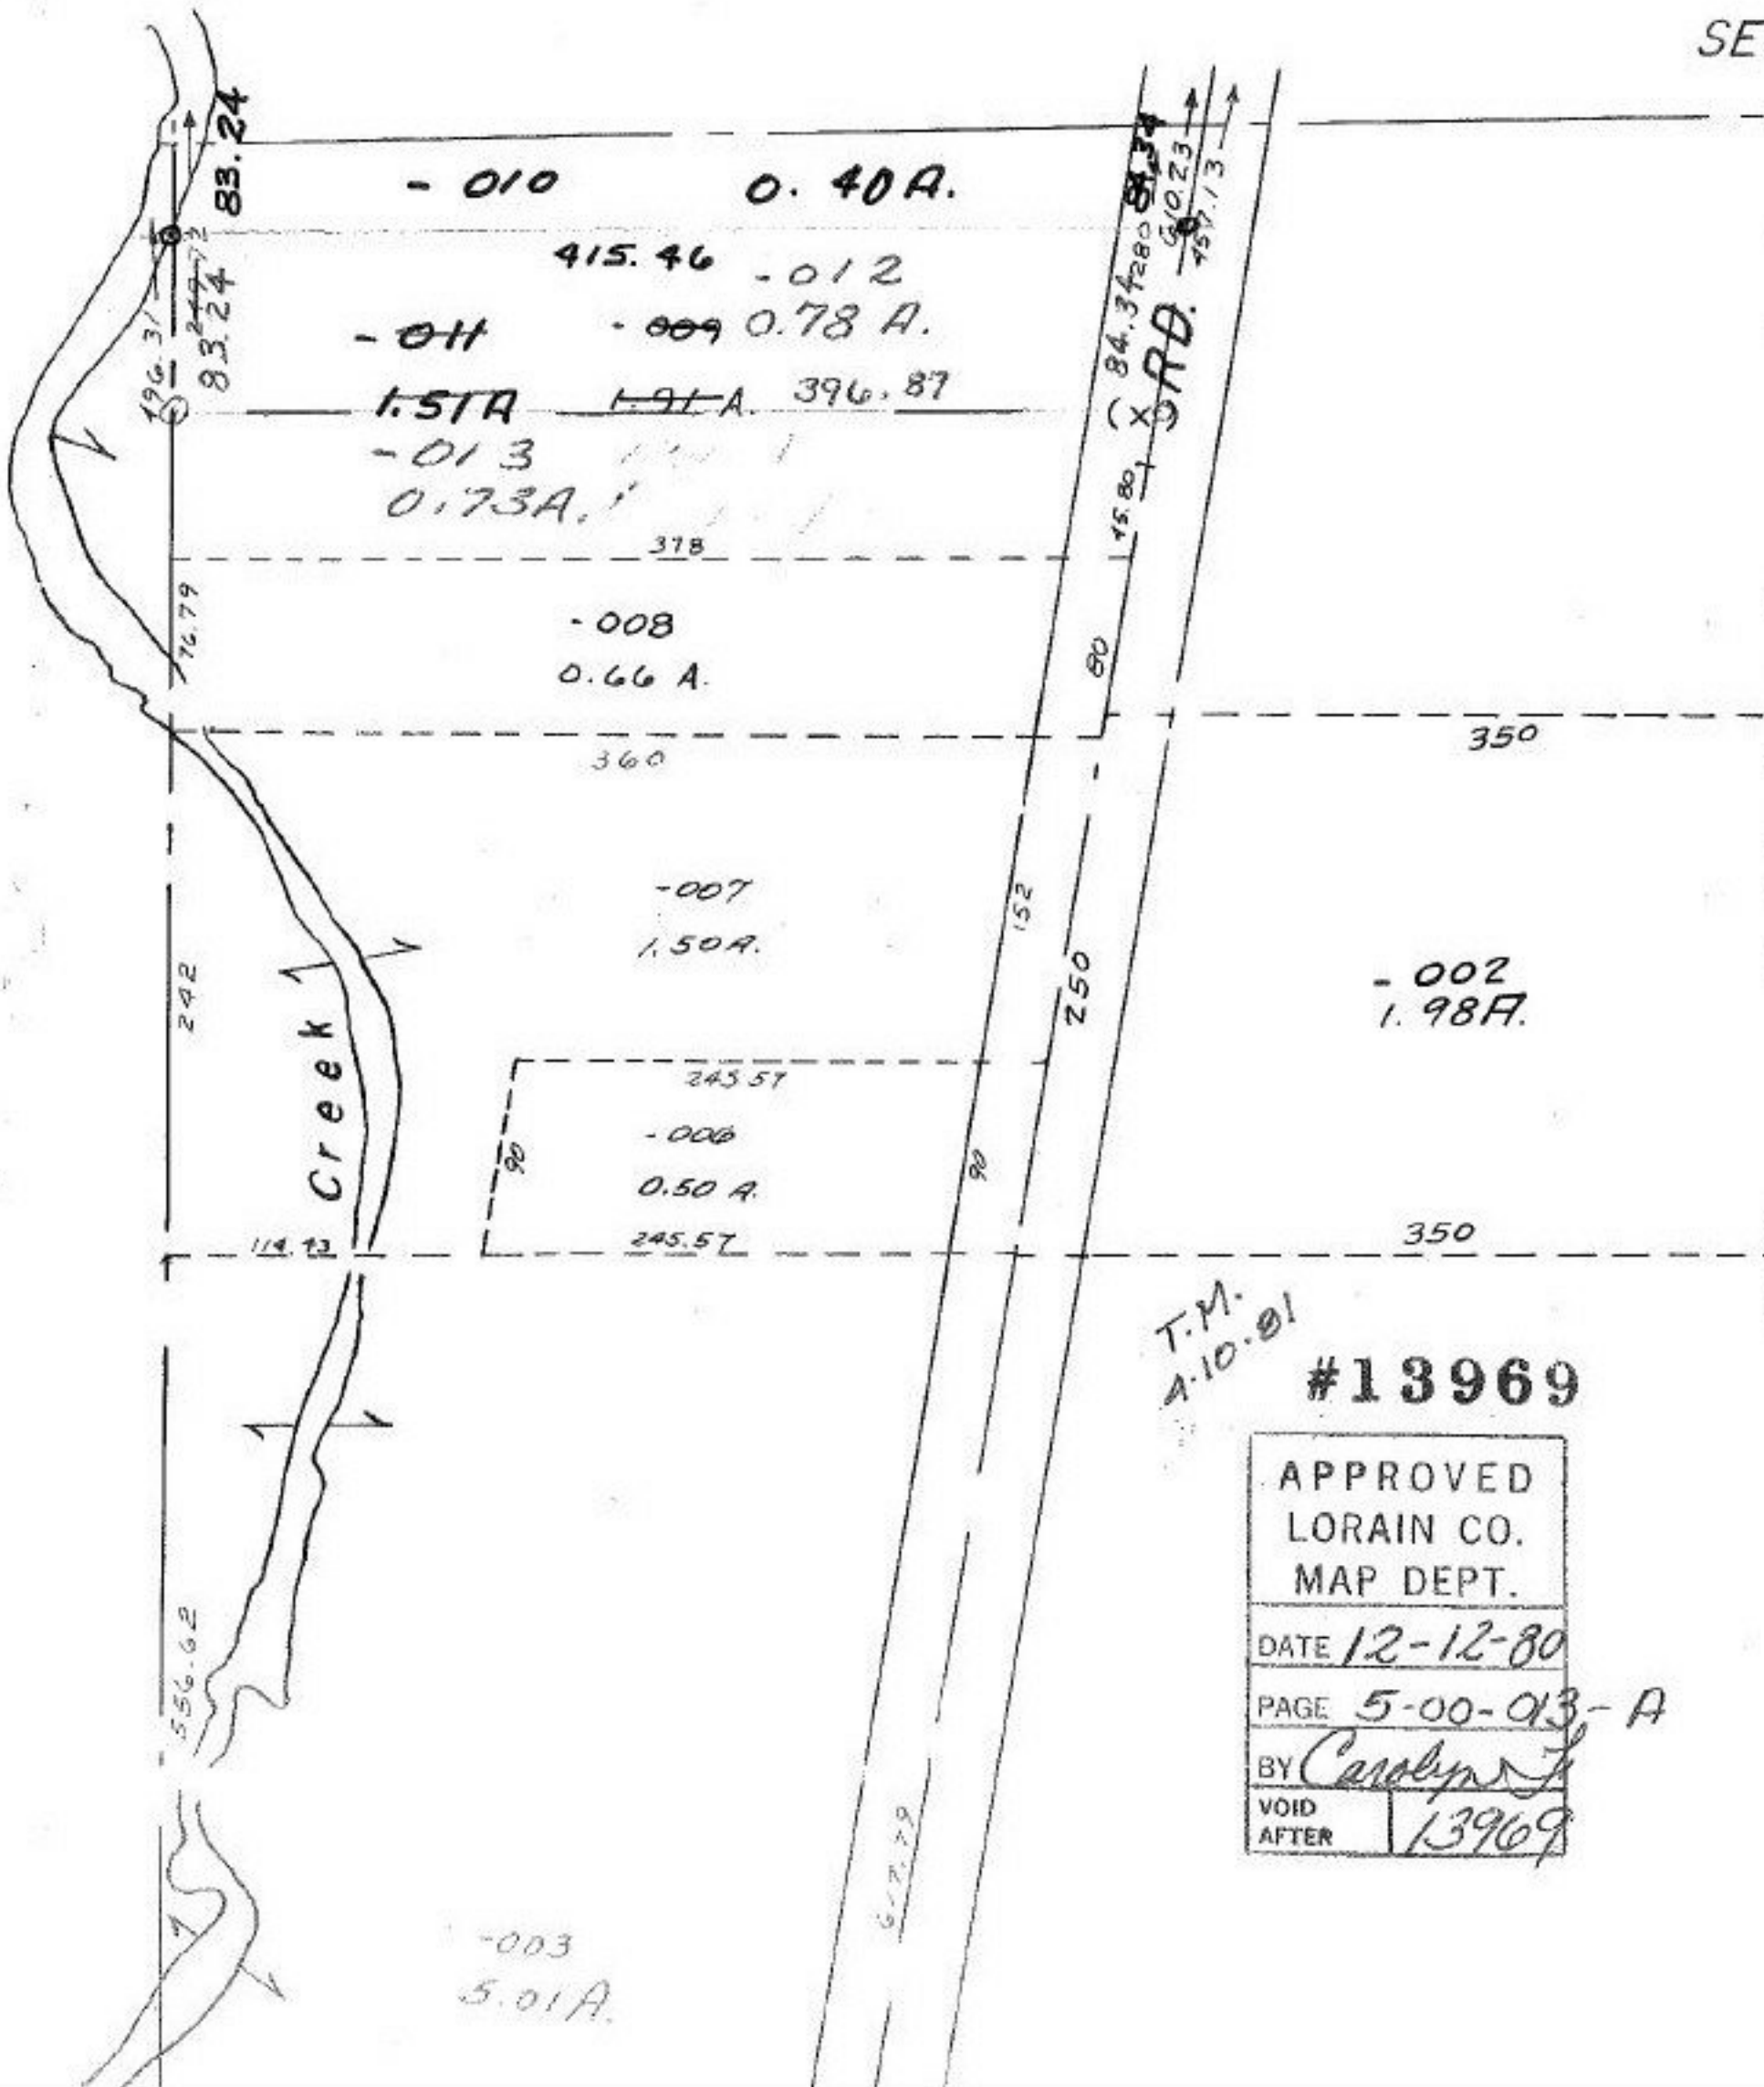

T.M.
4-10-81

#13969

APPROVED LORAIN CO. MAP DEPT.	
DATE 12-12-80	
PAGE 5-00-013-A	
BY Carolyn J.	
VOID AFTER	13969

-003
5.01 A.