


#13970

~~166~~  
~~18.17A~~ 13710

- 200  
17.61A.

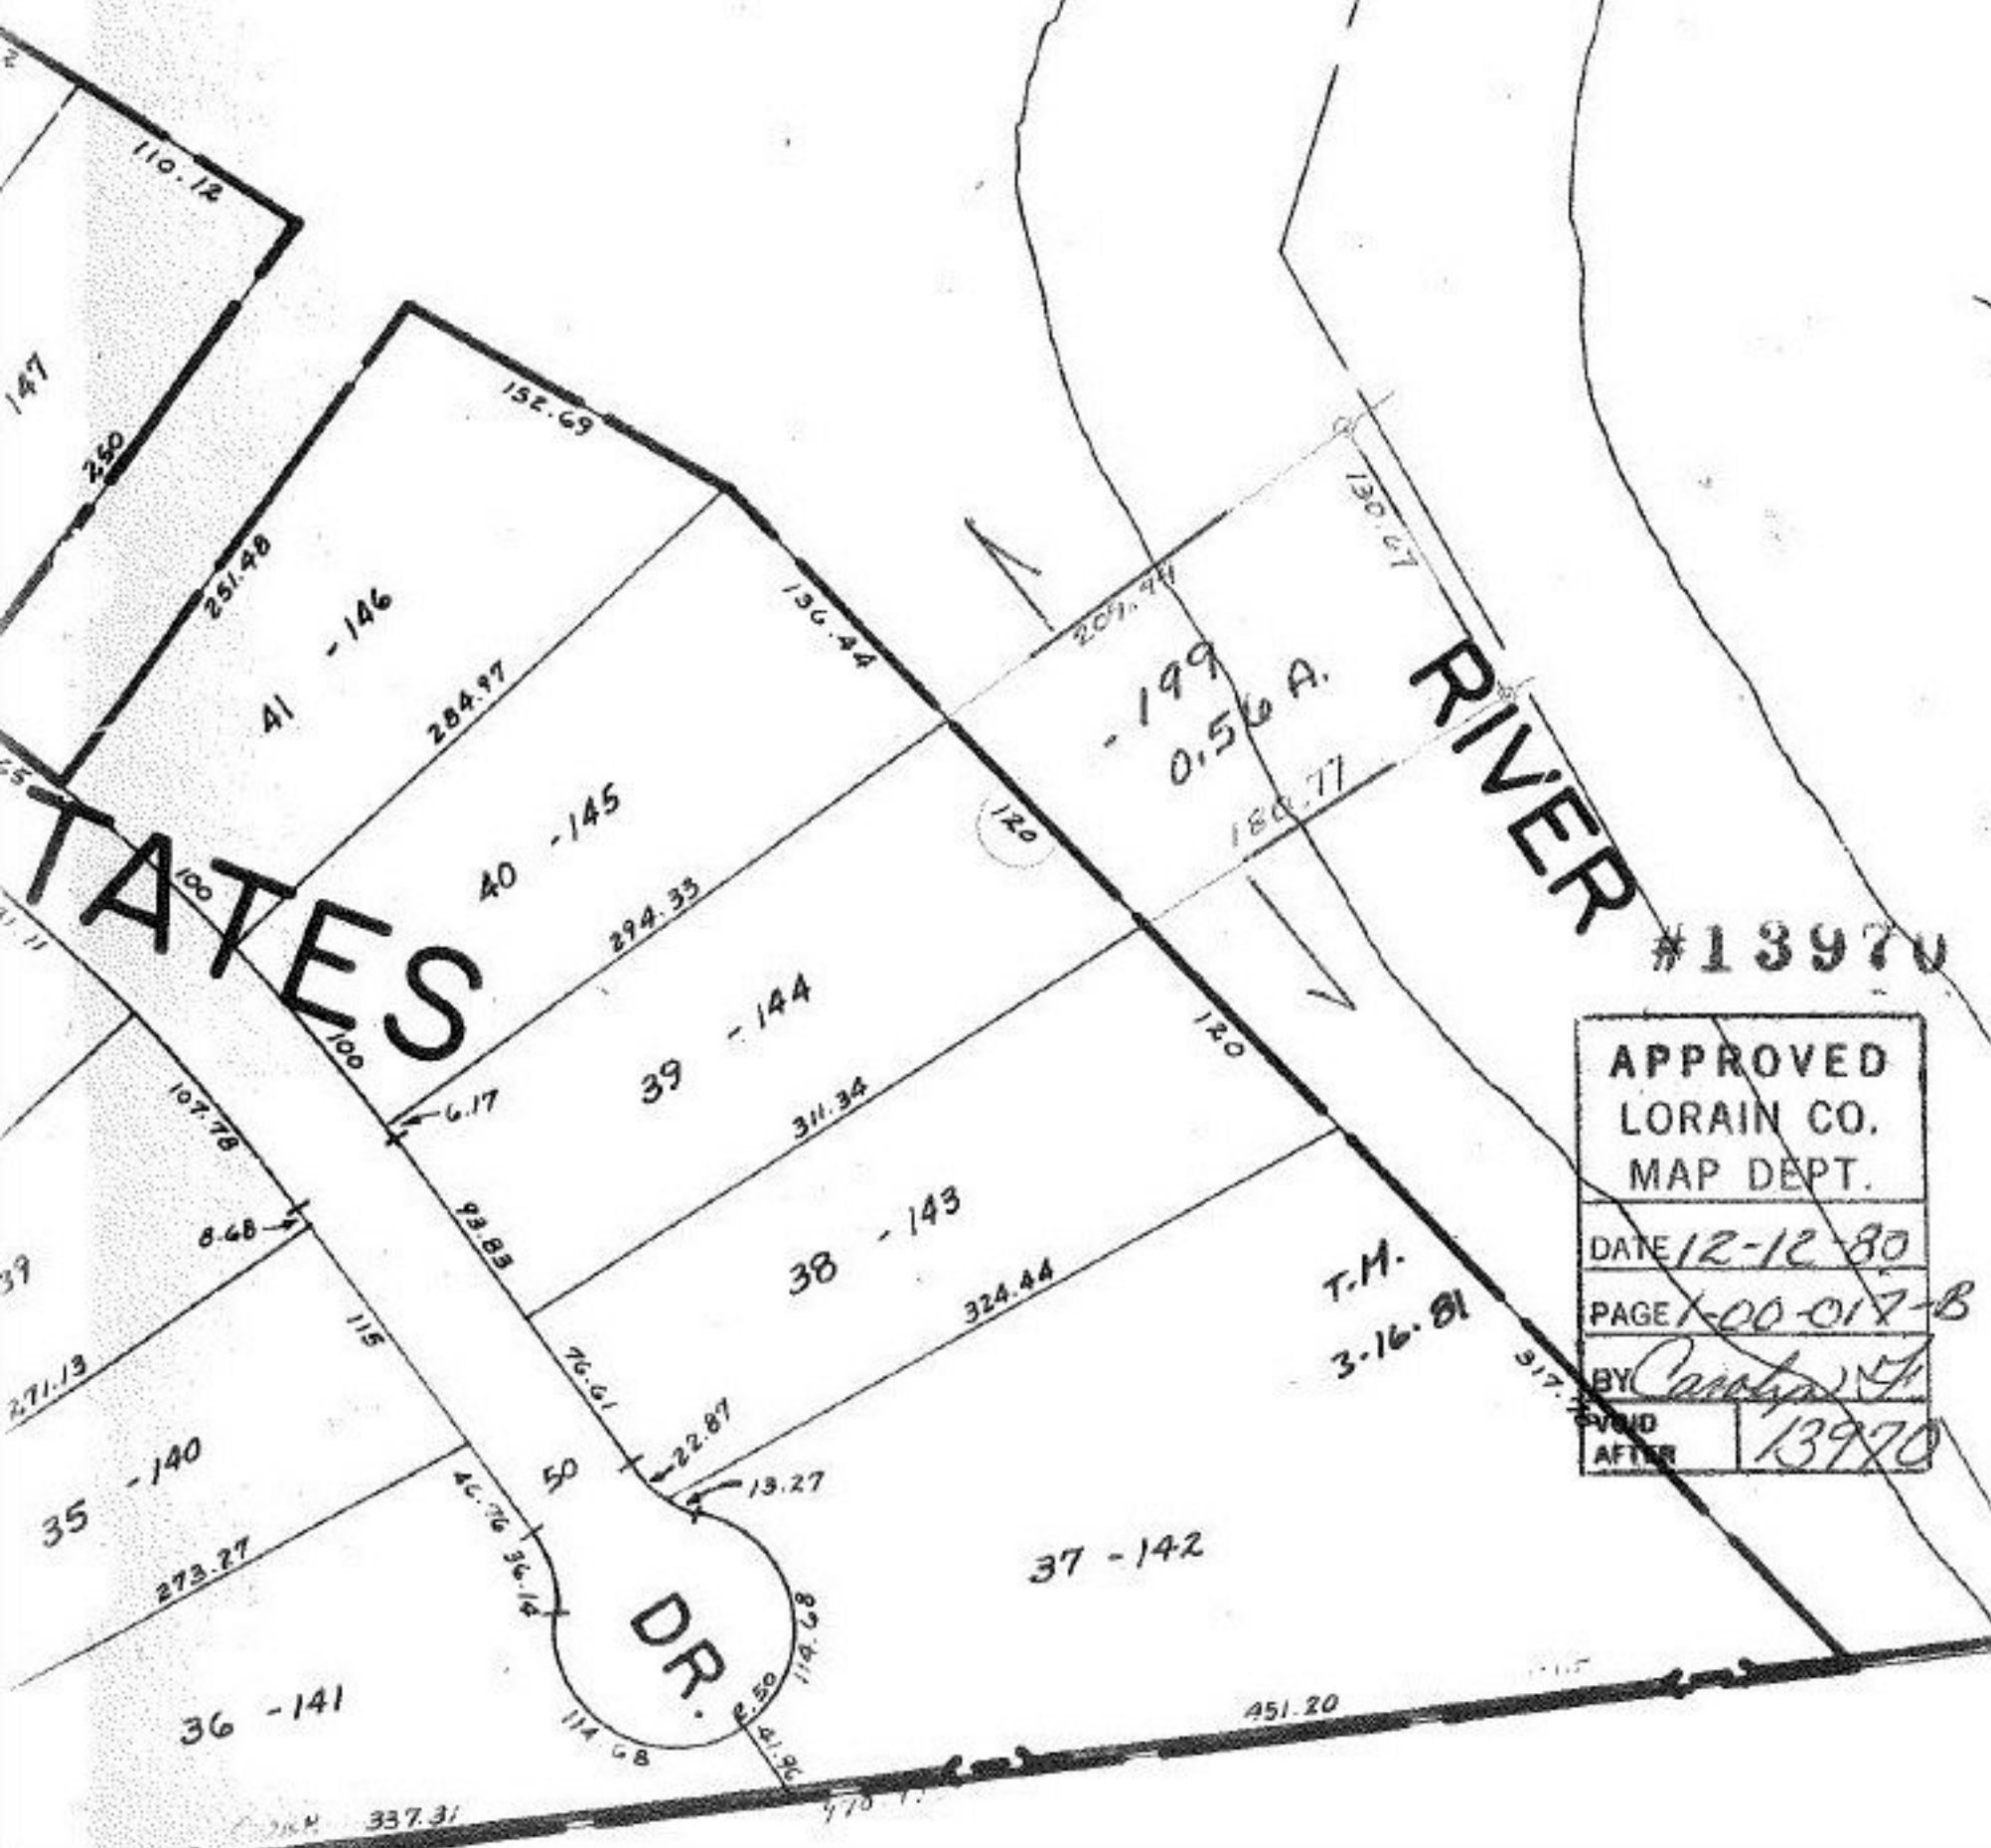

#13970

APPROVED LORAIN CO. MAP DEPT.	
DATE	12-12-80
PAGE	1-00-017-B
BY	Carroll
VOID AFTER	13970

T.M.  
3-16-81

337.31

451.20