


#13982  
#13983

# COMBINATION

SEE 3-

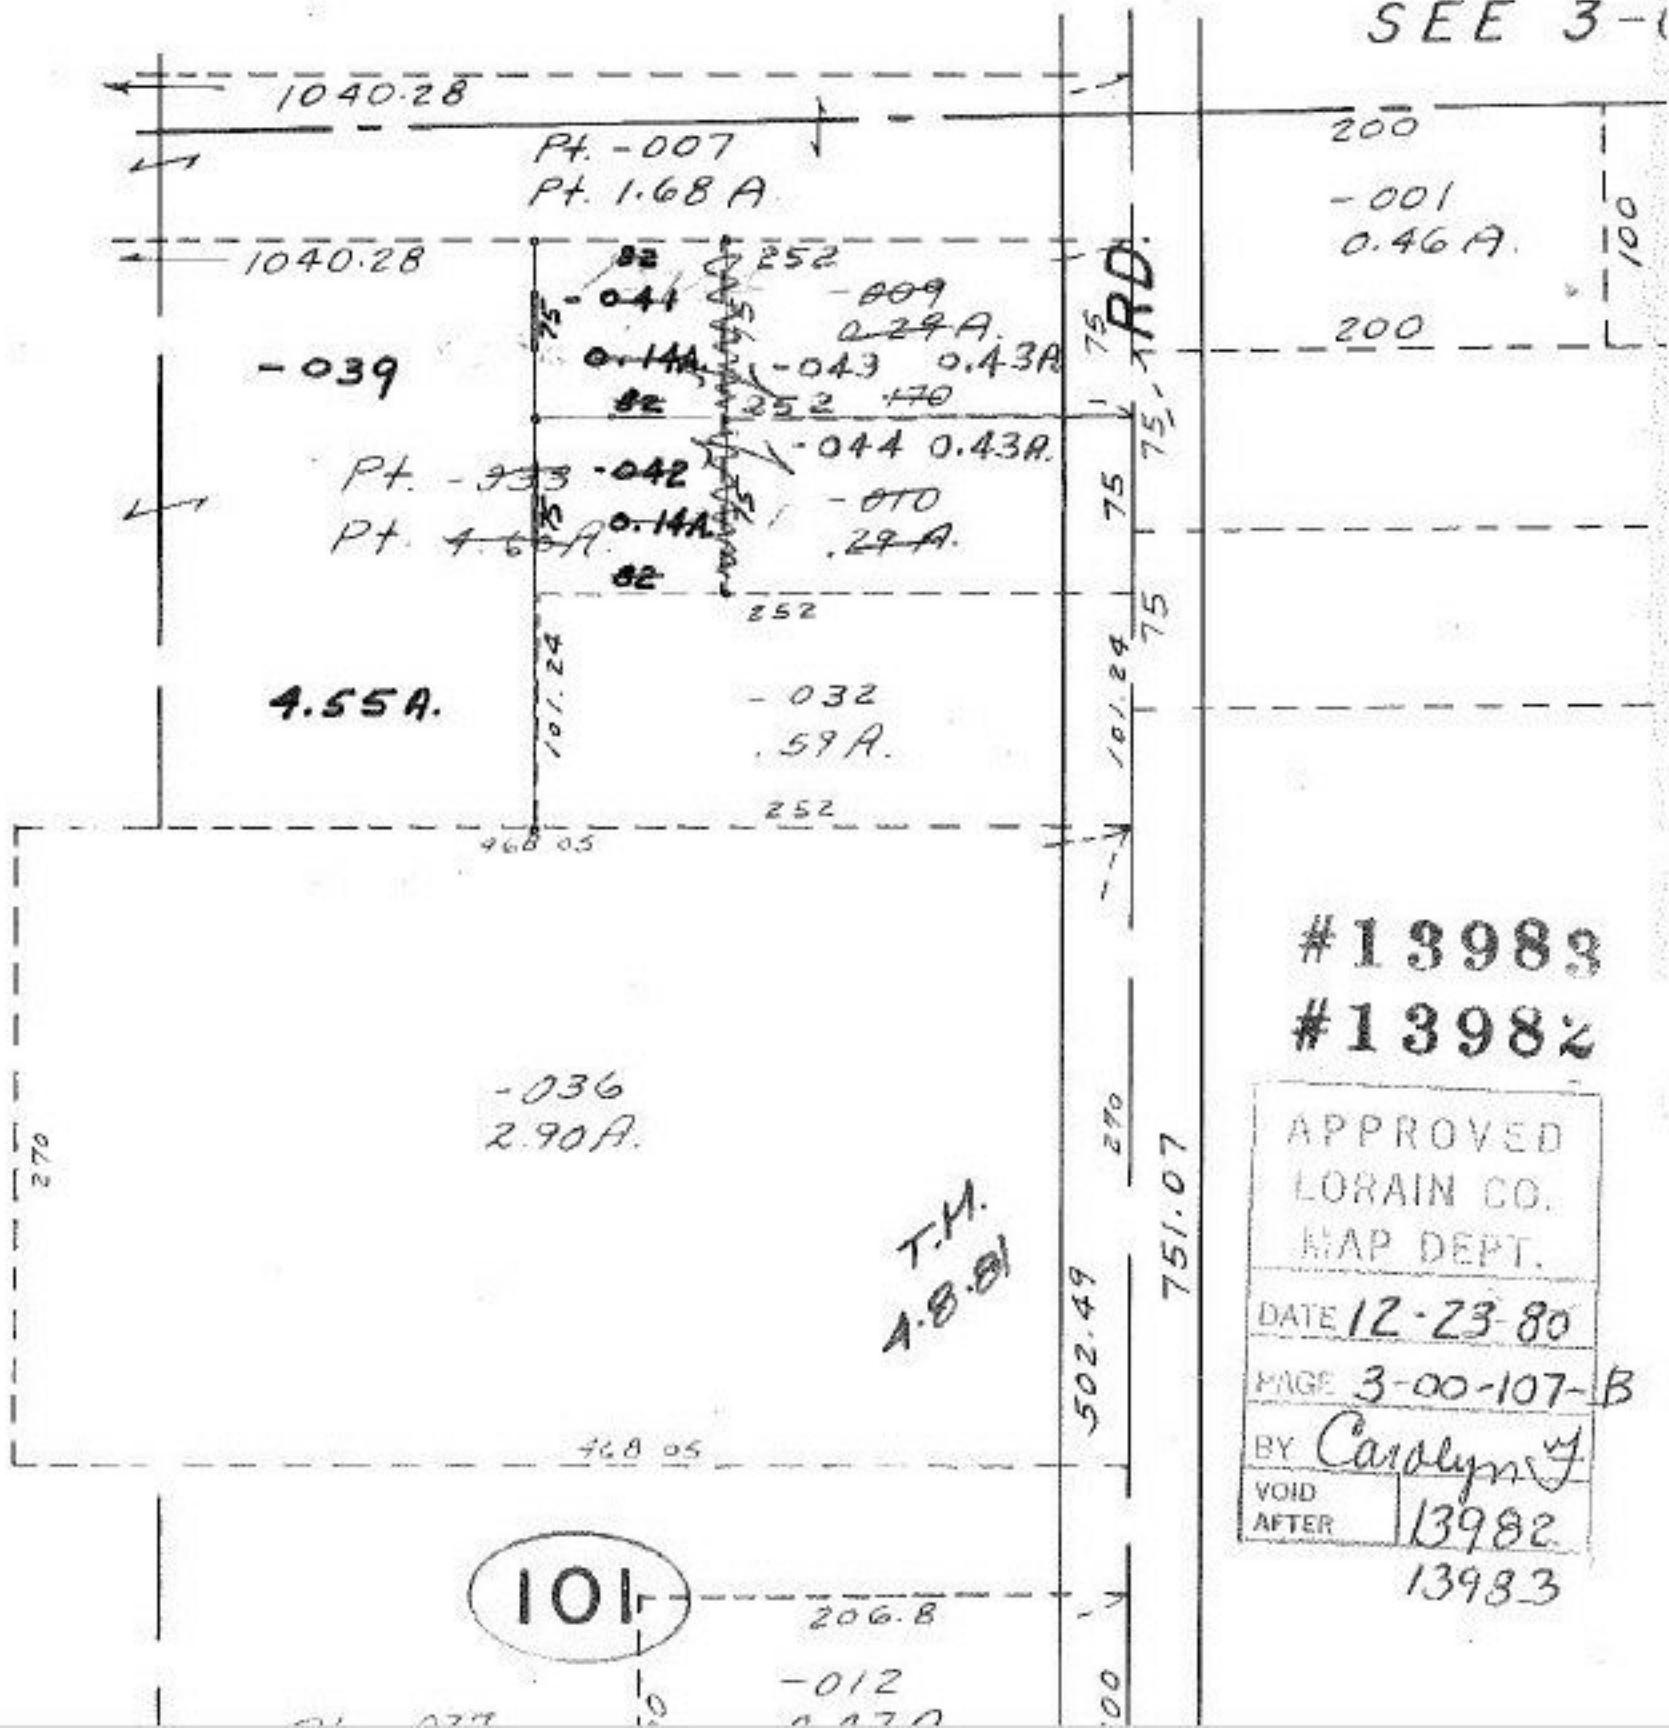

#13983  
#13982

APPROVED  
LORAIN CO.  
MAP DEPT.  
DATE 12-23-80  
PAGE 3-00-107-B  
BY Carolyn J  
VOID AFTER 13982  
13983