


#1 3991

SEE 4-00-022-D

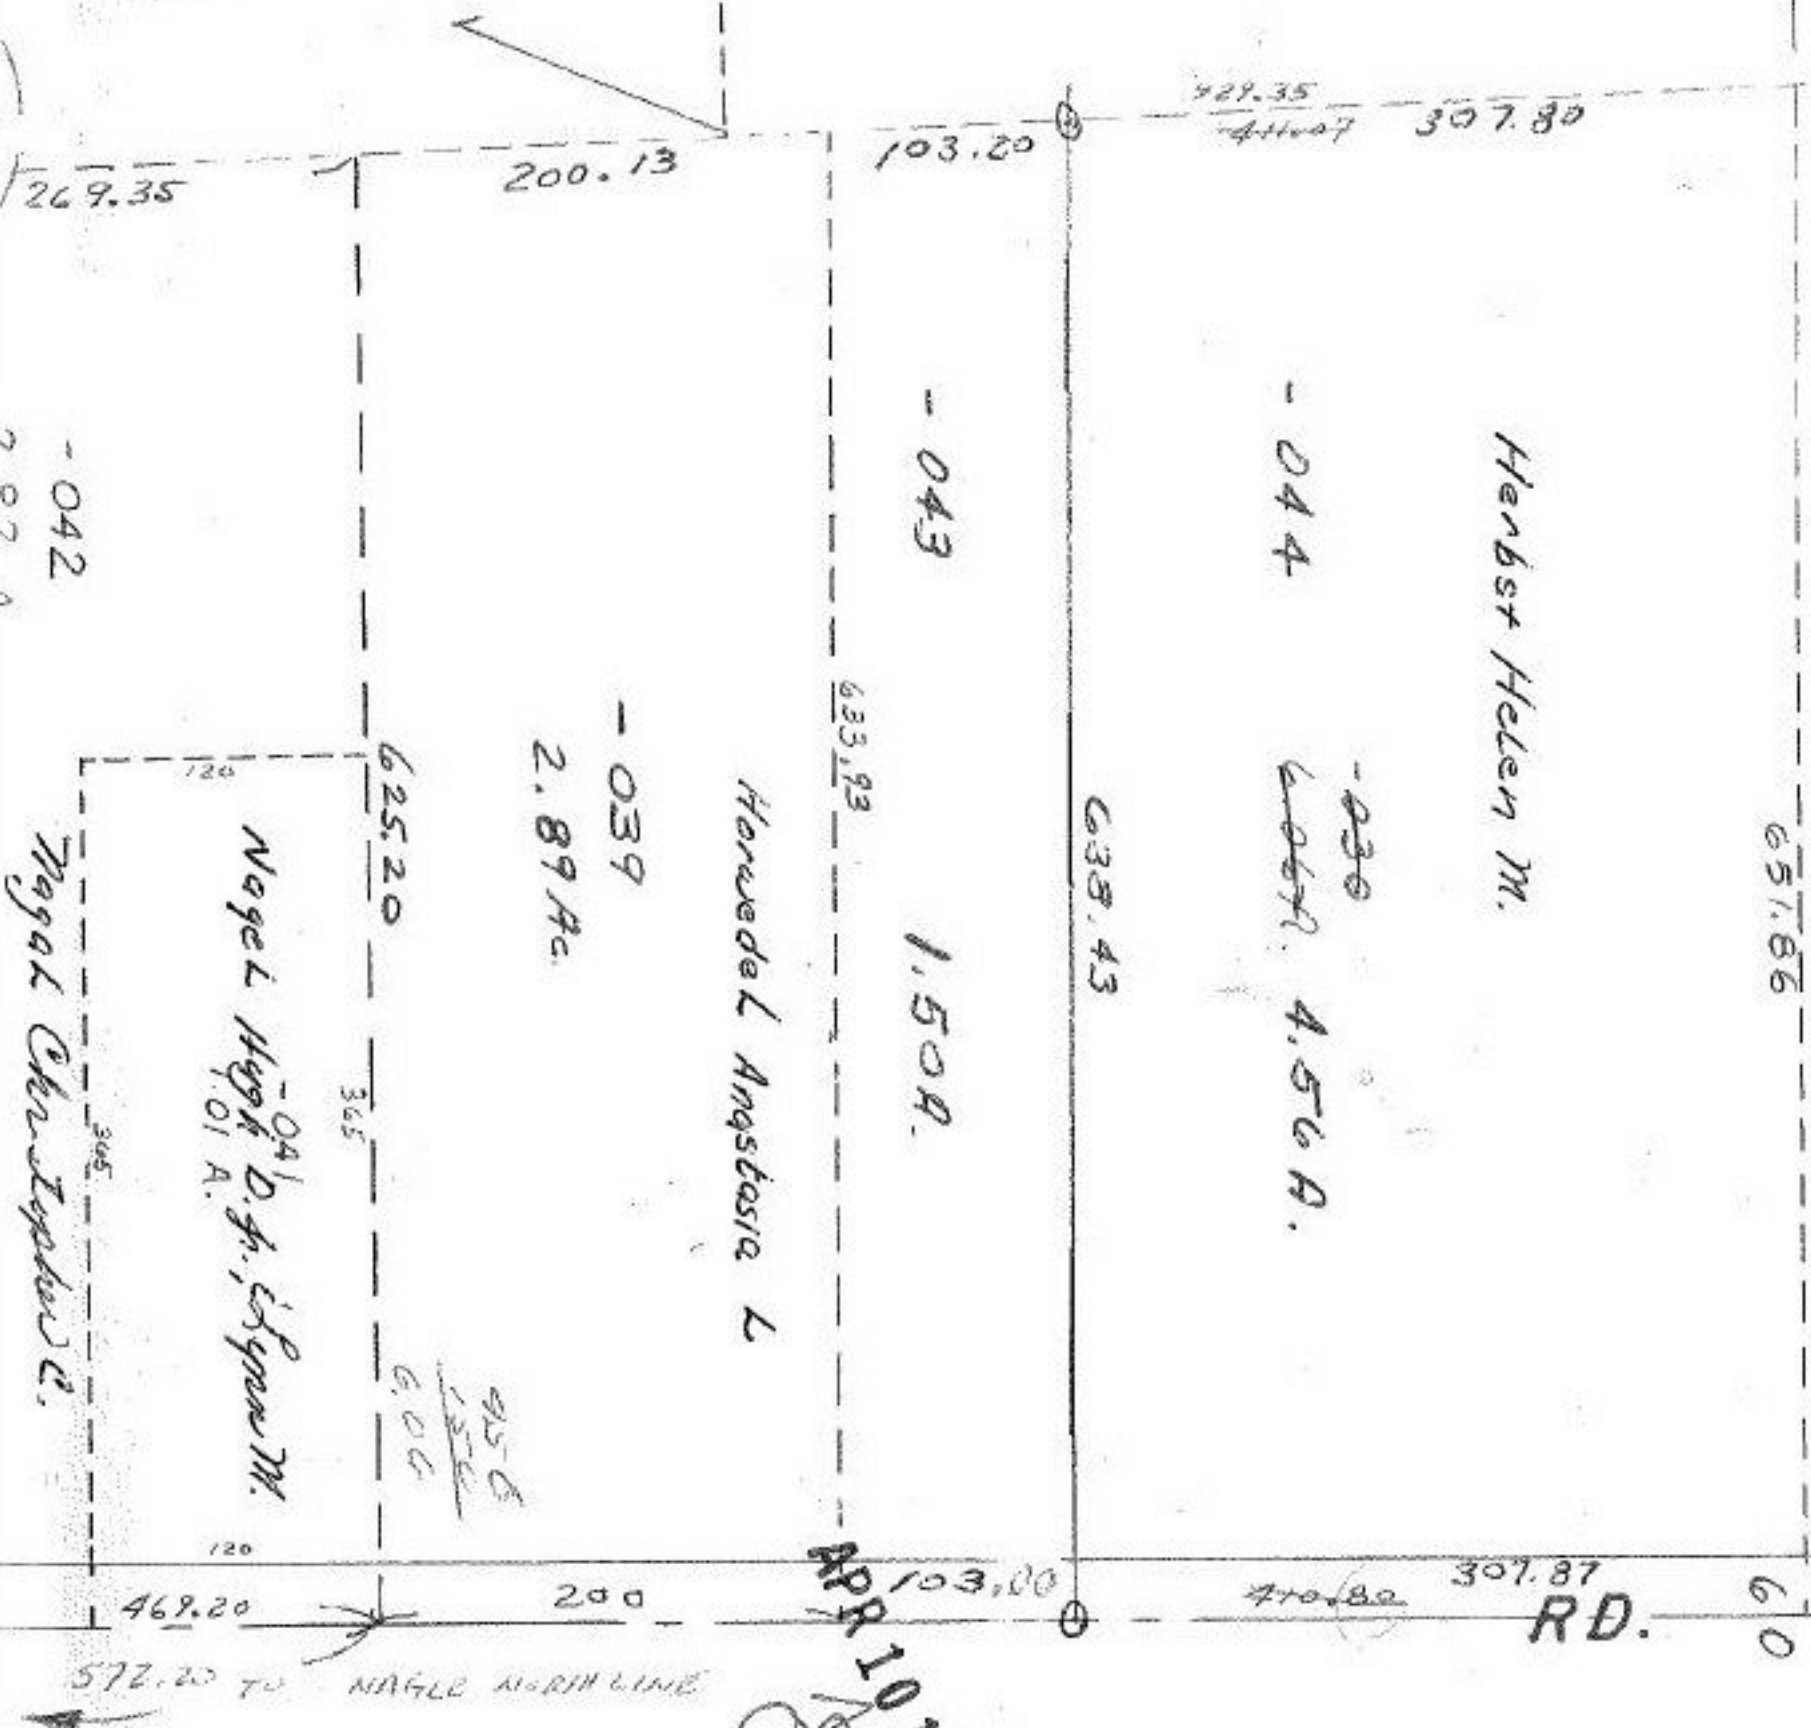

APR 10 1981

103
307.87
410.87

#1 3991

APPROVED  
 COUNTY CO.  
 1-5-81  
 4-00-022-H  
 Carolyn  
 13991

572.20 TO NAGLE NORTH LINE