


13992

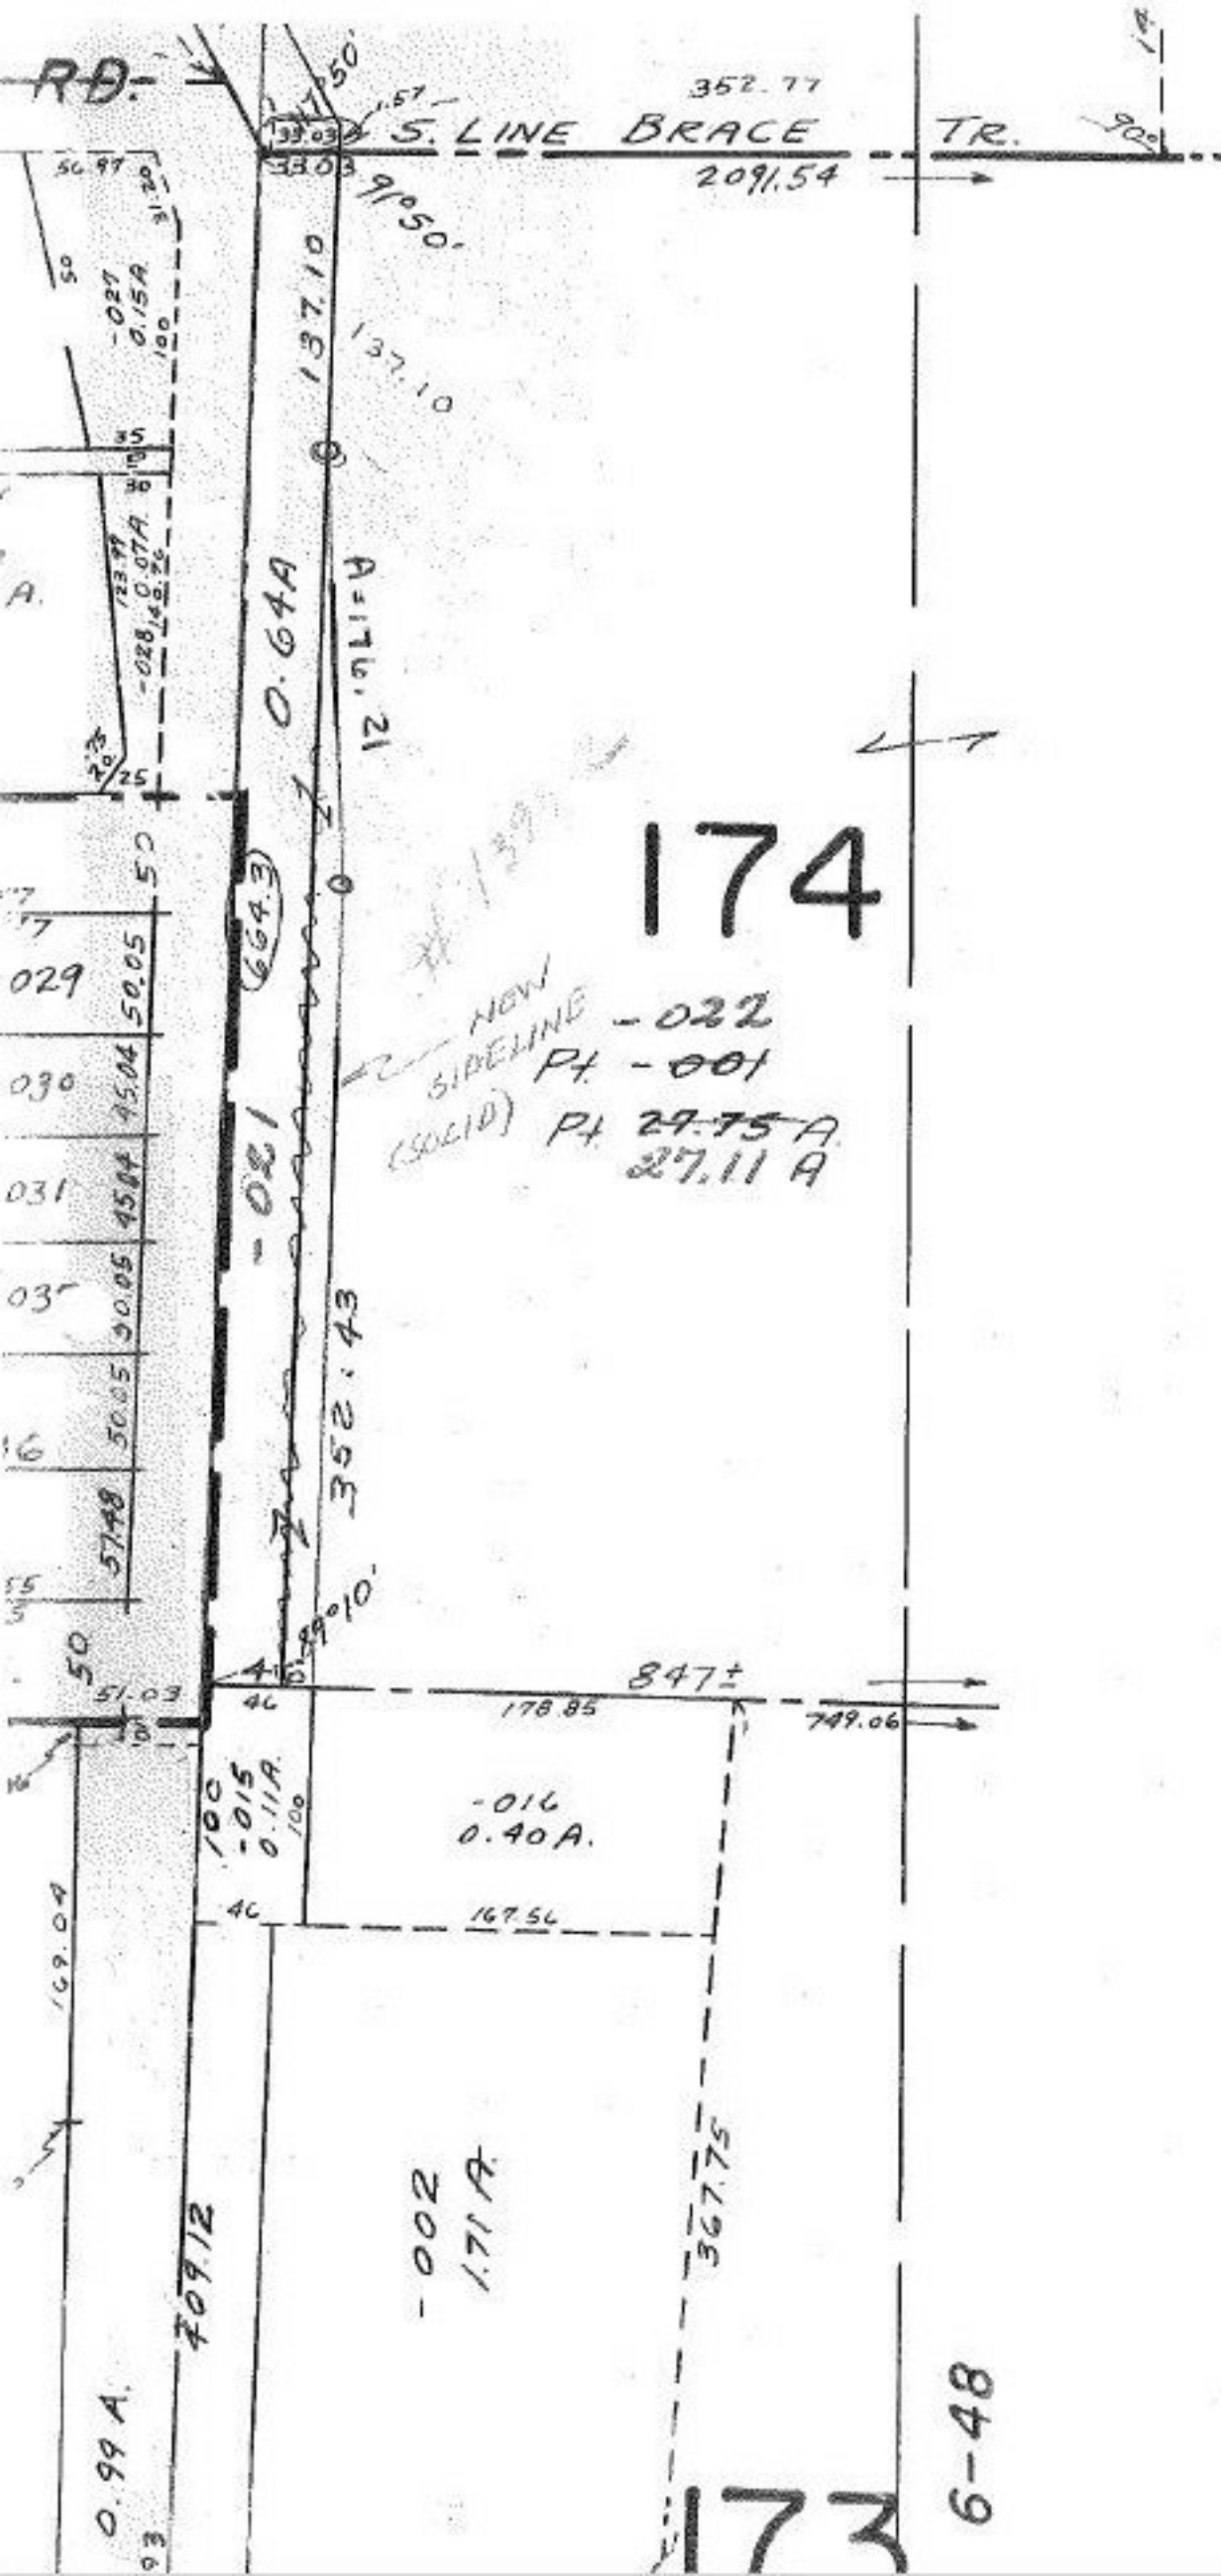

13992

T.M.
4-22-81

APPROVED
LORAIN CO.
MAP DEPT.
DATE 1-5-81
PAGE 6-47
BY Carolyn J.
VOID AFTER #13992