
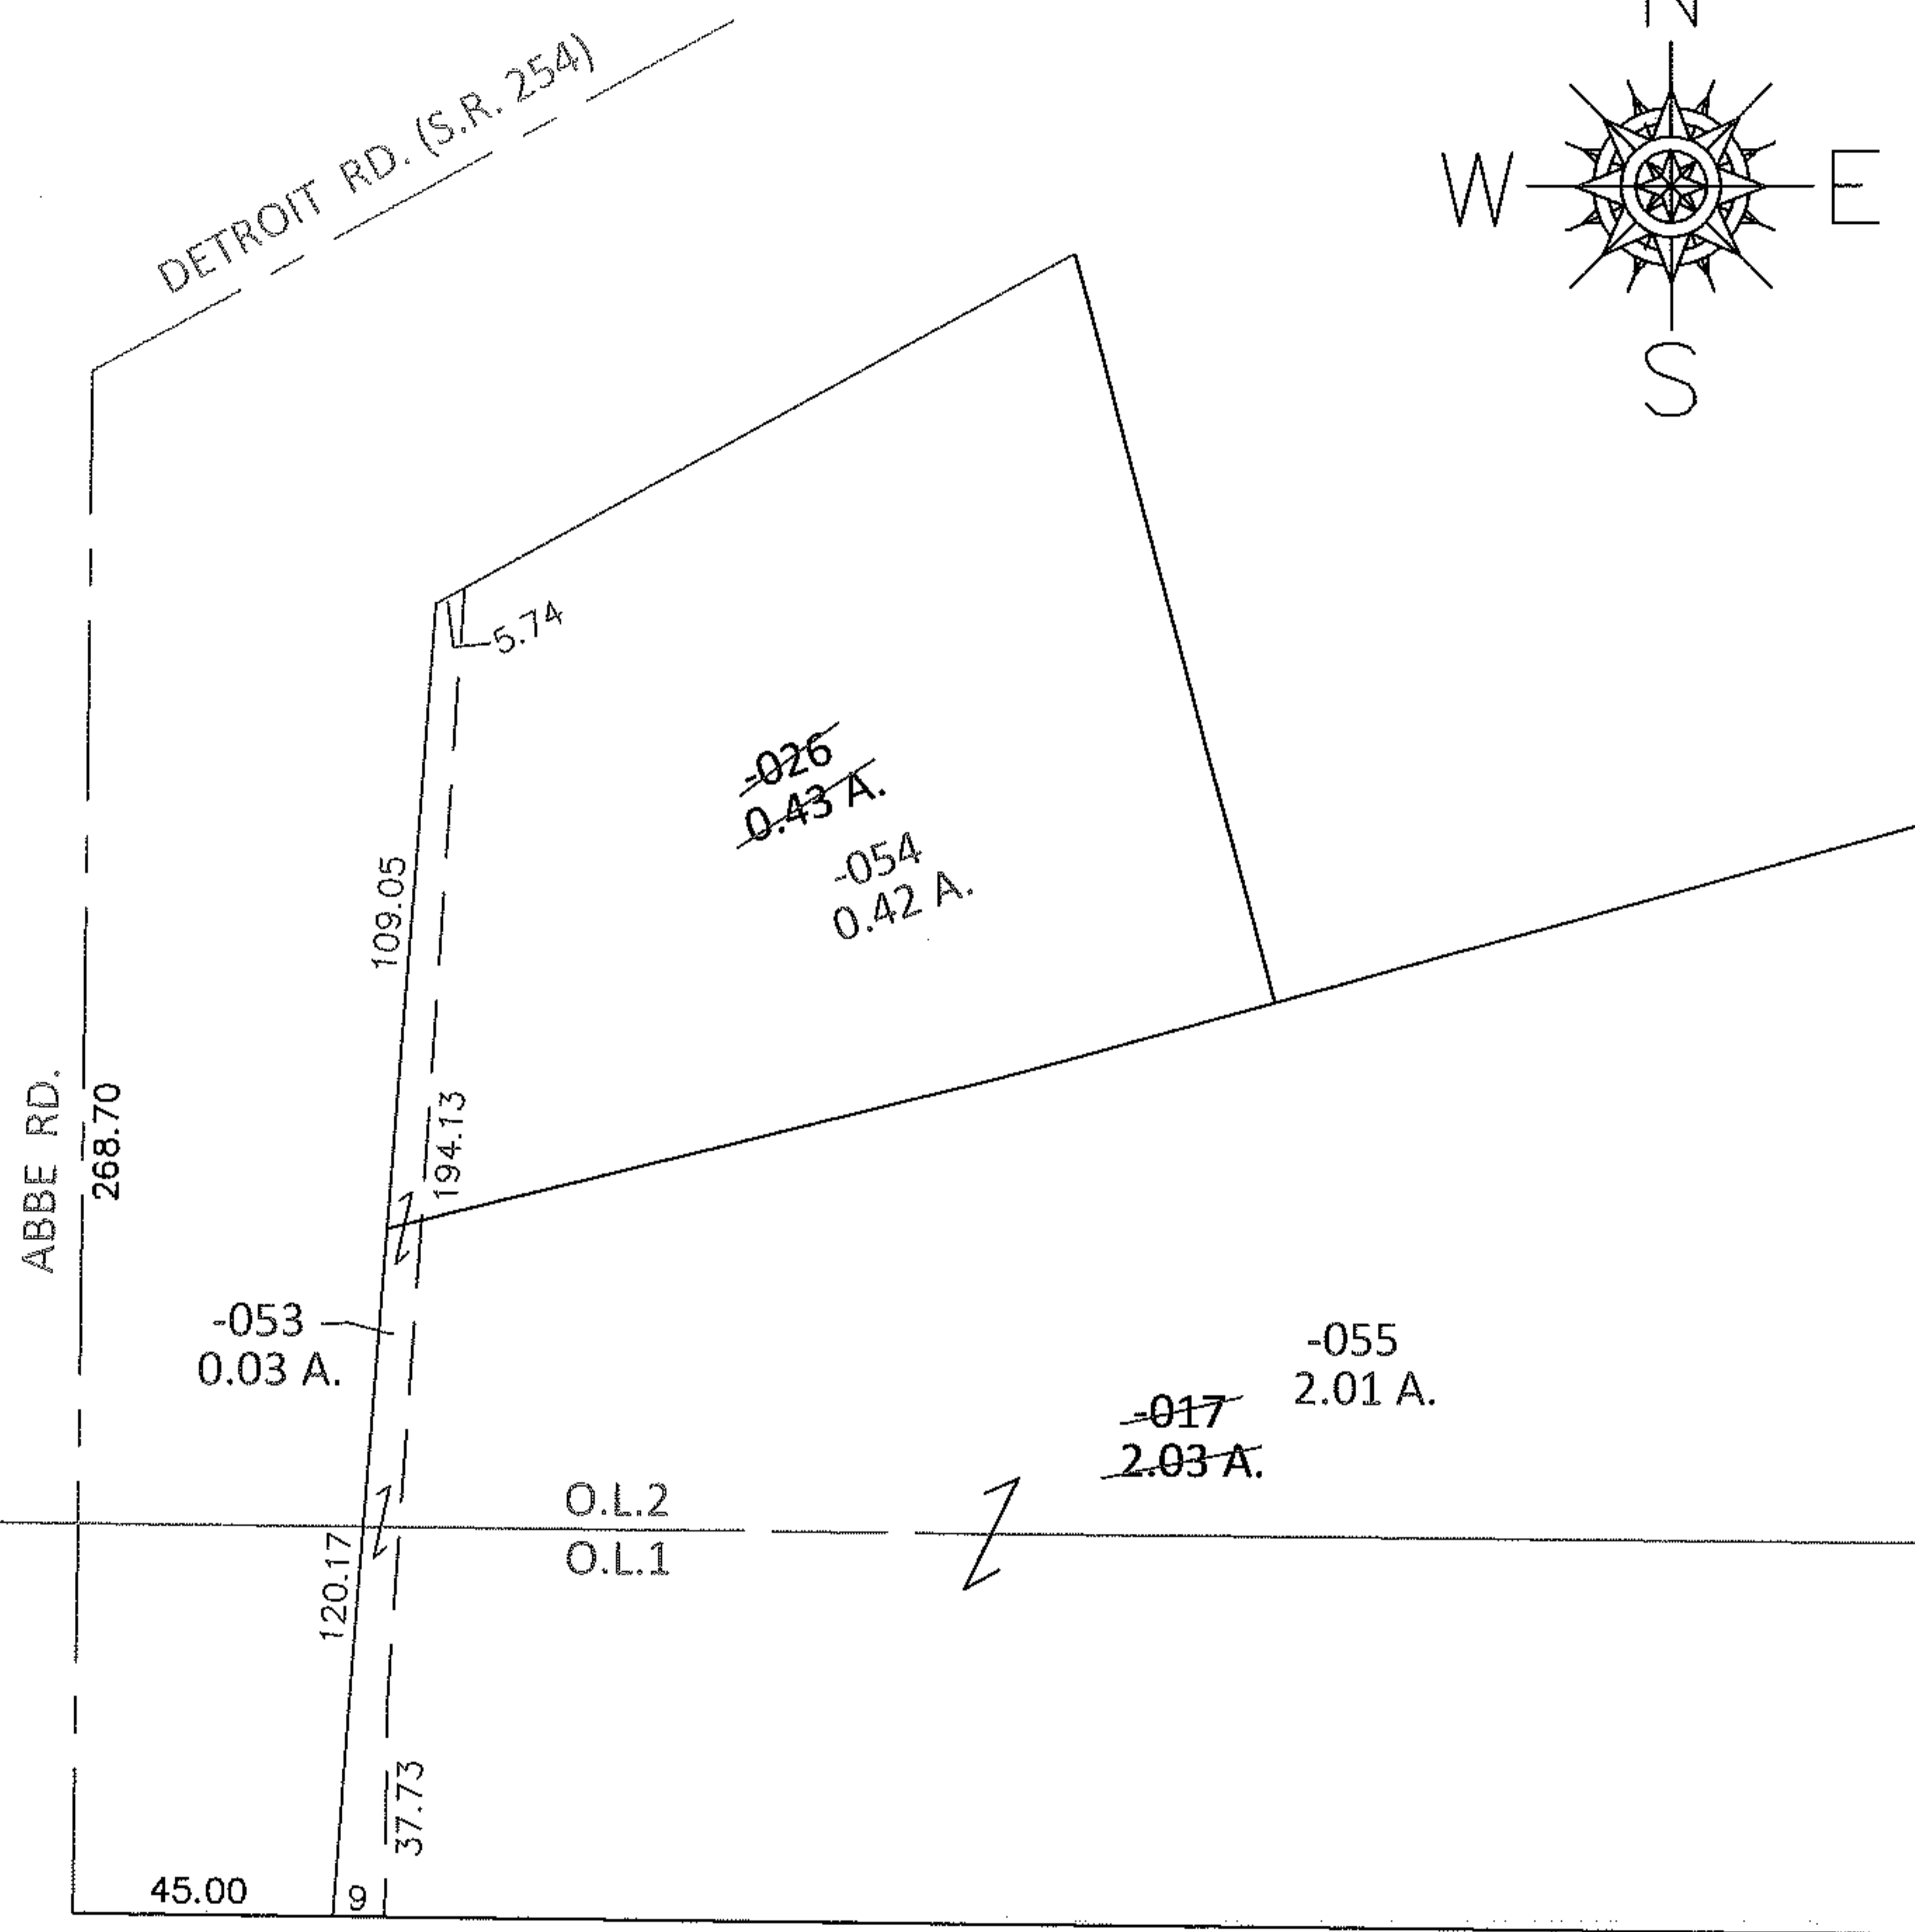


PARENT PARCEL: 03-00-002-102-017, -026


CHILD PARCEL: 03-00-002-102-053 THRU -055

14-00470

STARTING POINT: AT A MON BOX AT INTERSECTION OF C/L OF S.R. 254 AND C/L OF ABBE RD.

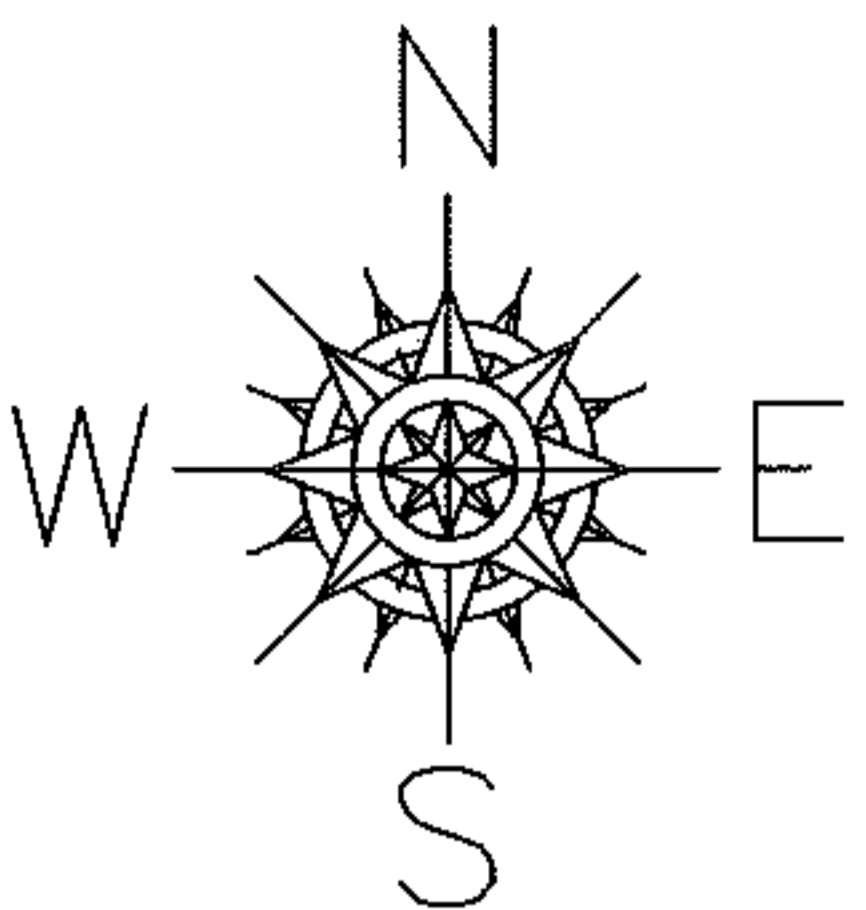

LOR-301-21.50
34-WD

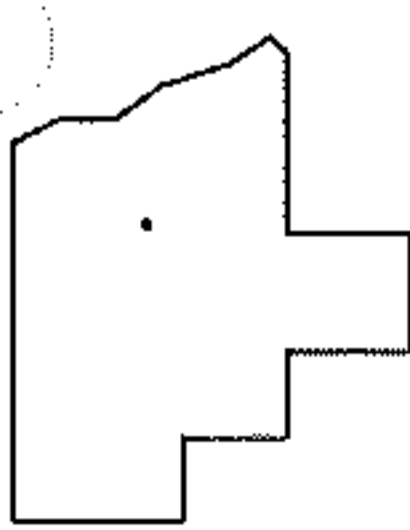

SPLITS/DEEDS PROCESSED

LORAIN COUNTY TAX MAP DEPARTMENT
226 MIDDLE AVE. ELYRIA, OHIO

SURVEYED BY:	RICHARD JOHN SWAN
CLOSURE:	.01:10,000
MAP PAGE(S):	3-00-002-A
APPROVED BY:	RRM DATE: 3-17-14
SCALE:	1" = 50' PRIOR INST.: OR 1054/17