
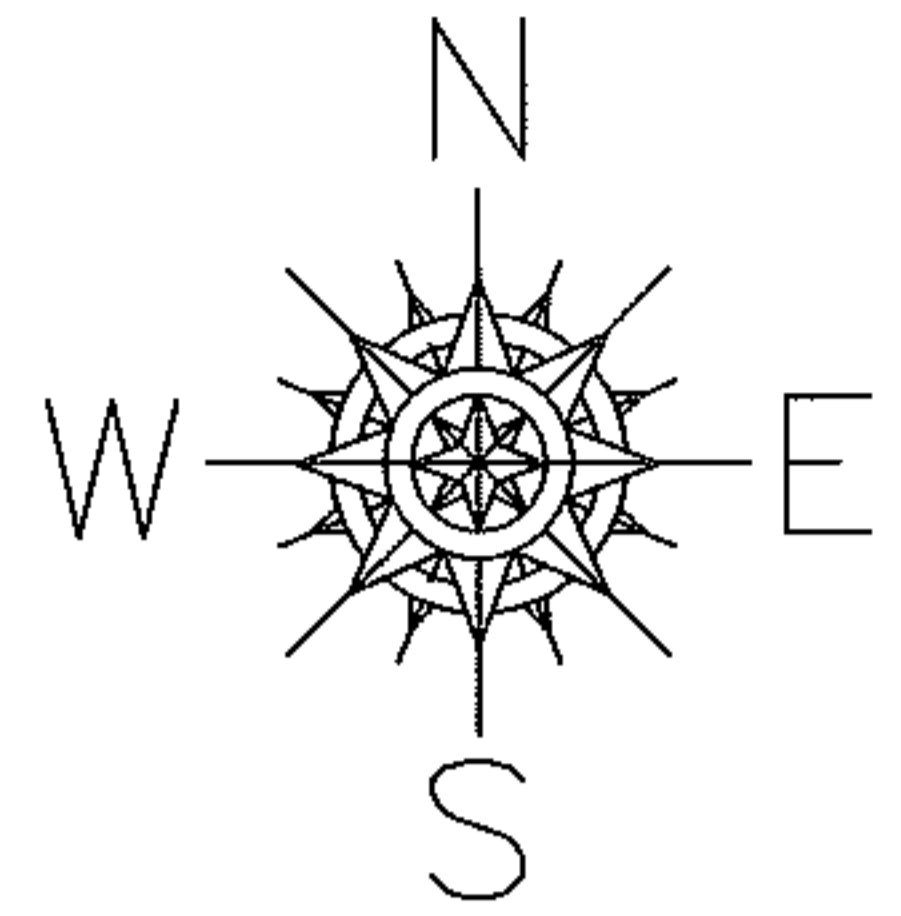


PARENT PARCEL: 11-00-099-000-230

CHILD PARCEL: 11-00-099-000-428, -429

14-00472

STARTING POINT: AT A MON BOX AT THE INTERSECTION OF C/L OF S.R.57 AND SOUTH LINE OF O.L.99

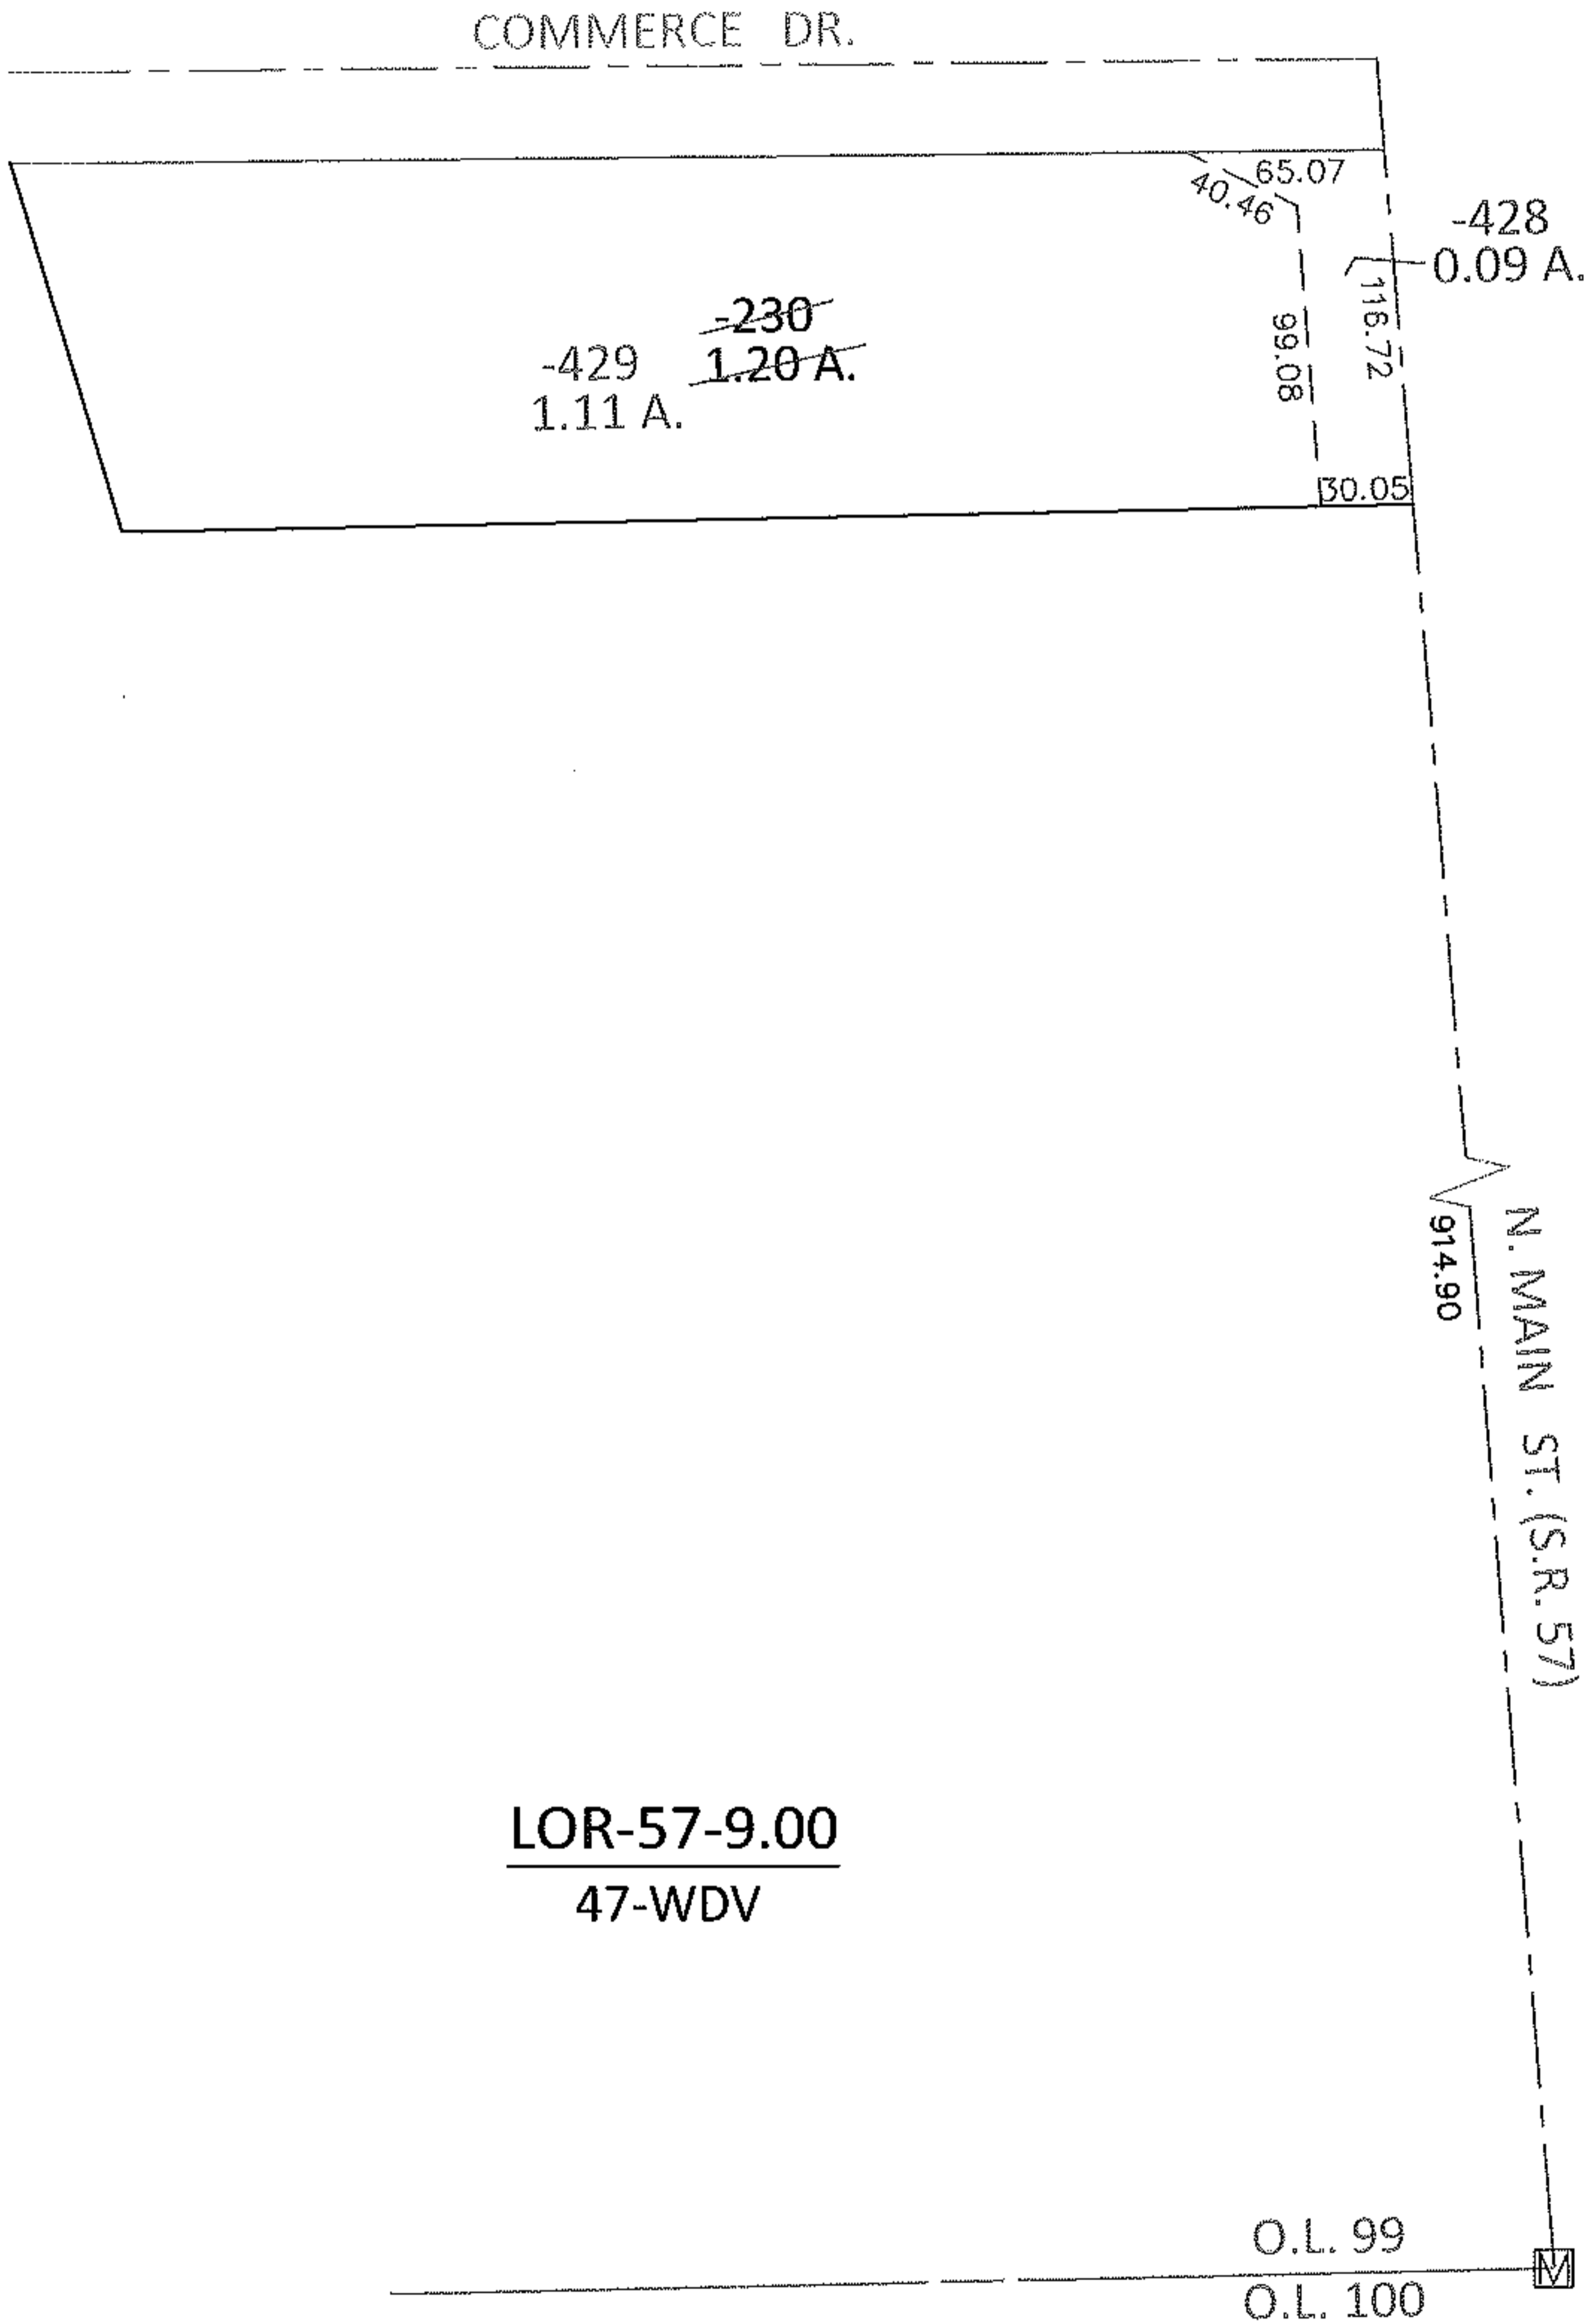

LOR-57-9.00  
47-WDV

**SPLITS/DEEDS PROCESSED**

LORAIN COUNTY TAX MAP DEPARTMENT  
226 MIDDLE AVE. ELYRIA, OHIO

SURVEYED BY: KENNETH C. DEAN JR.

CLOSURE: .01:10,000

MAP PAGE(S): 11-E SOUTH

APPROVED BY: RRM DATE: 3-19-14

SCALE: 1"= 100

PRIOR INST.: \_\_\_\_\_

