


PARENT PARCEL: 03-00-001-000-138

CHILD PARCEL: 03-00-001-000-196, -197

14-00480

STARTING POINT: AT A MON BOX AT THE INTERSECTION OF C/L OF S.R.254 AND C/L OF S.R.301

DETROIT RD. (S.R. 254)

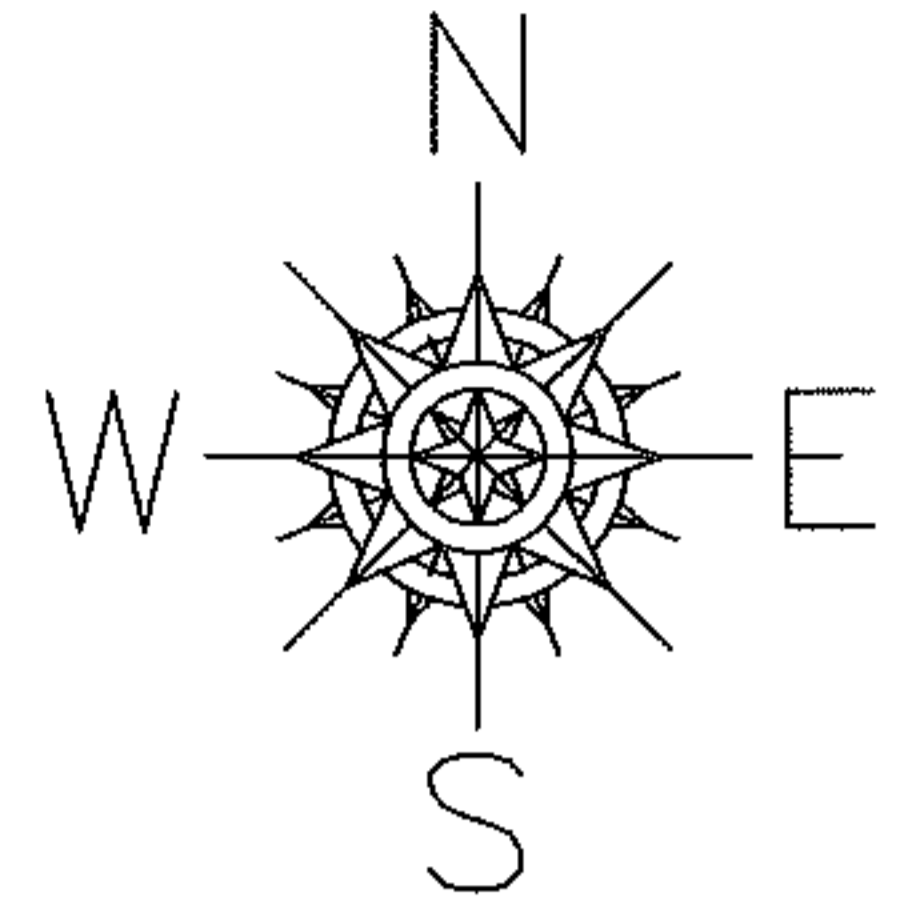

712.86

LOR-301-21.50
25-WD

ABBE RD. (S.R. 301)

40.00

12.25

88.14

230.00

-196
0.08 A.


141.91

15

~~-138~~
~~2.51 A.~~

-197
2.43 A.

WATERFORD DR.

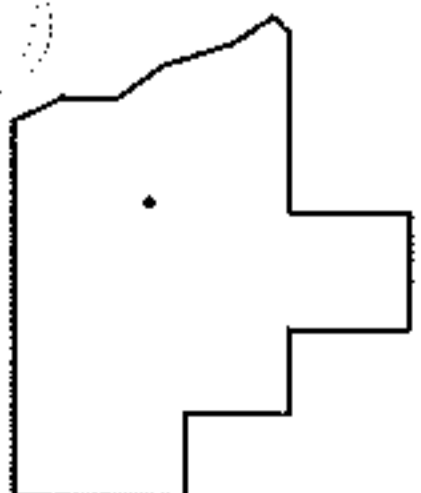

SPLITS/DEEDS PROCESSED

LORAIN COUNTY TAX MAP DEPARTMENT
226 MIDDLE AVE. ELYRIA, OHIO

SURVEYED BY: RICHARD JOHN SWAN

CLOSURE: .00:10,000

MAP PAGE(S): 3-00-001-A

APPROVED BY: RRM DATE: 4-30-14

SCALE: 1"= 100 PRIOR INST.: 20090303298