

PARENT PARCEL: 04-00-004-102-069 & 089



CHILD PARCEL: 04-00-004-102-195 THRU -098

STARTING POINT: CL OF COLORADO AVE. (S.R. 611) & CL OF RECREATION LANE

14-00483

LOR-CHESTER RD. R.O.W

9-WDV1 & 9-WDV2

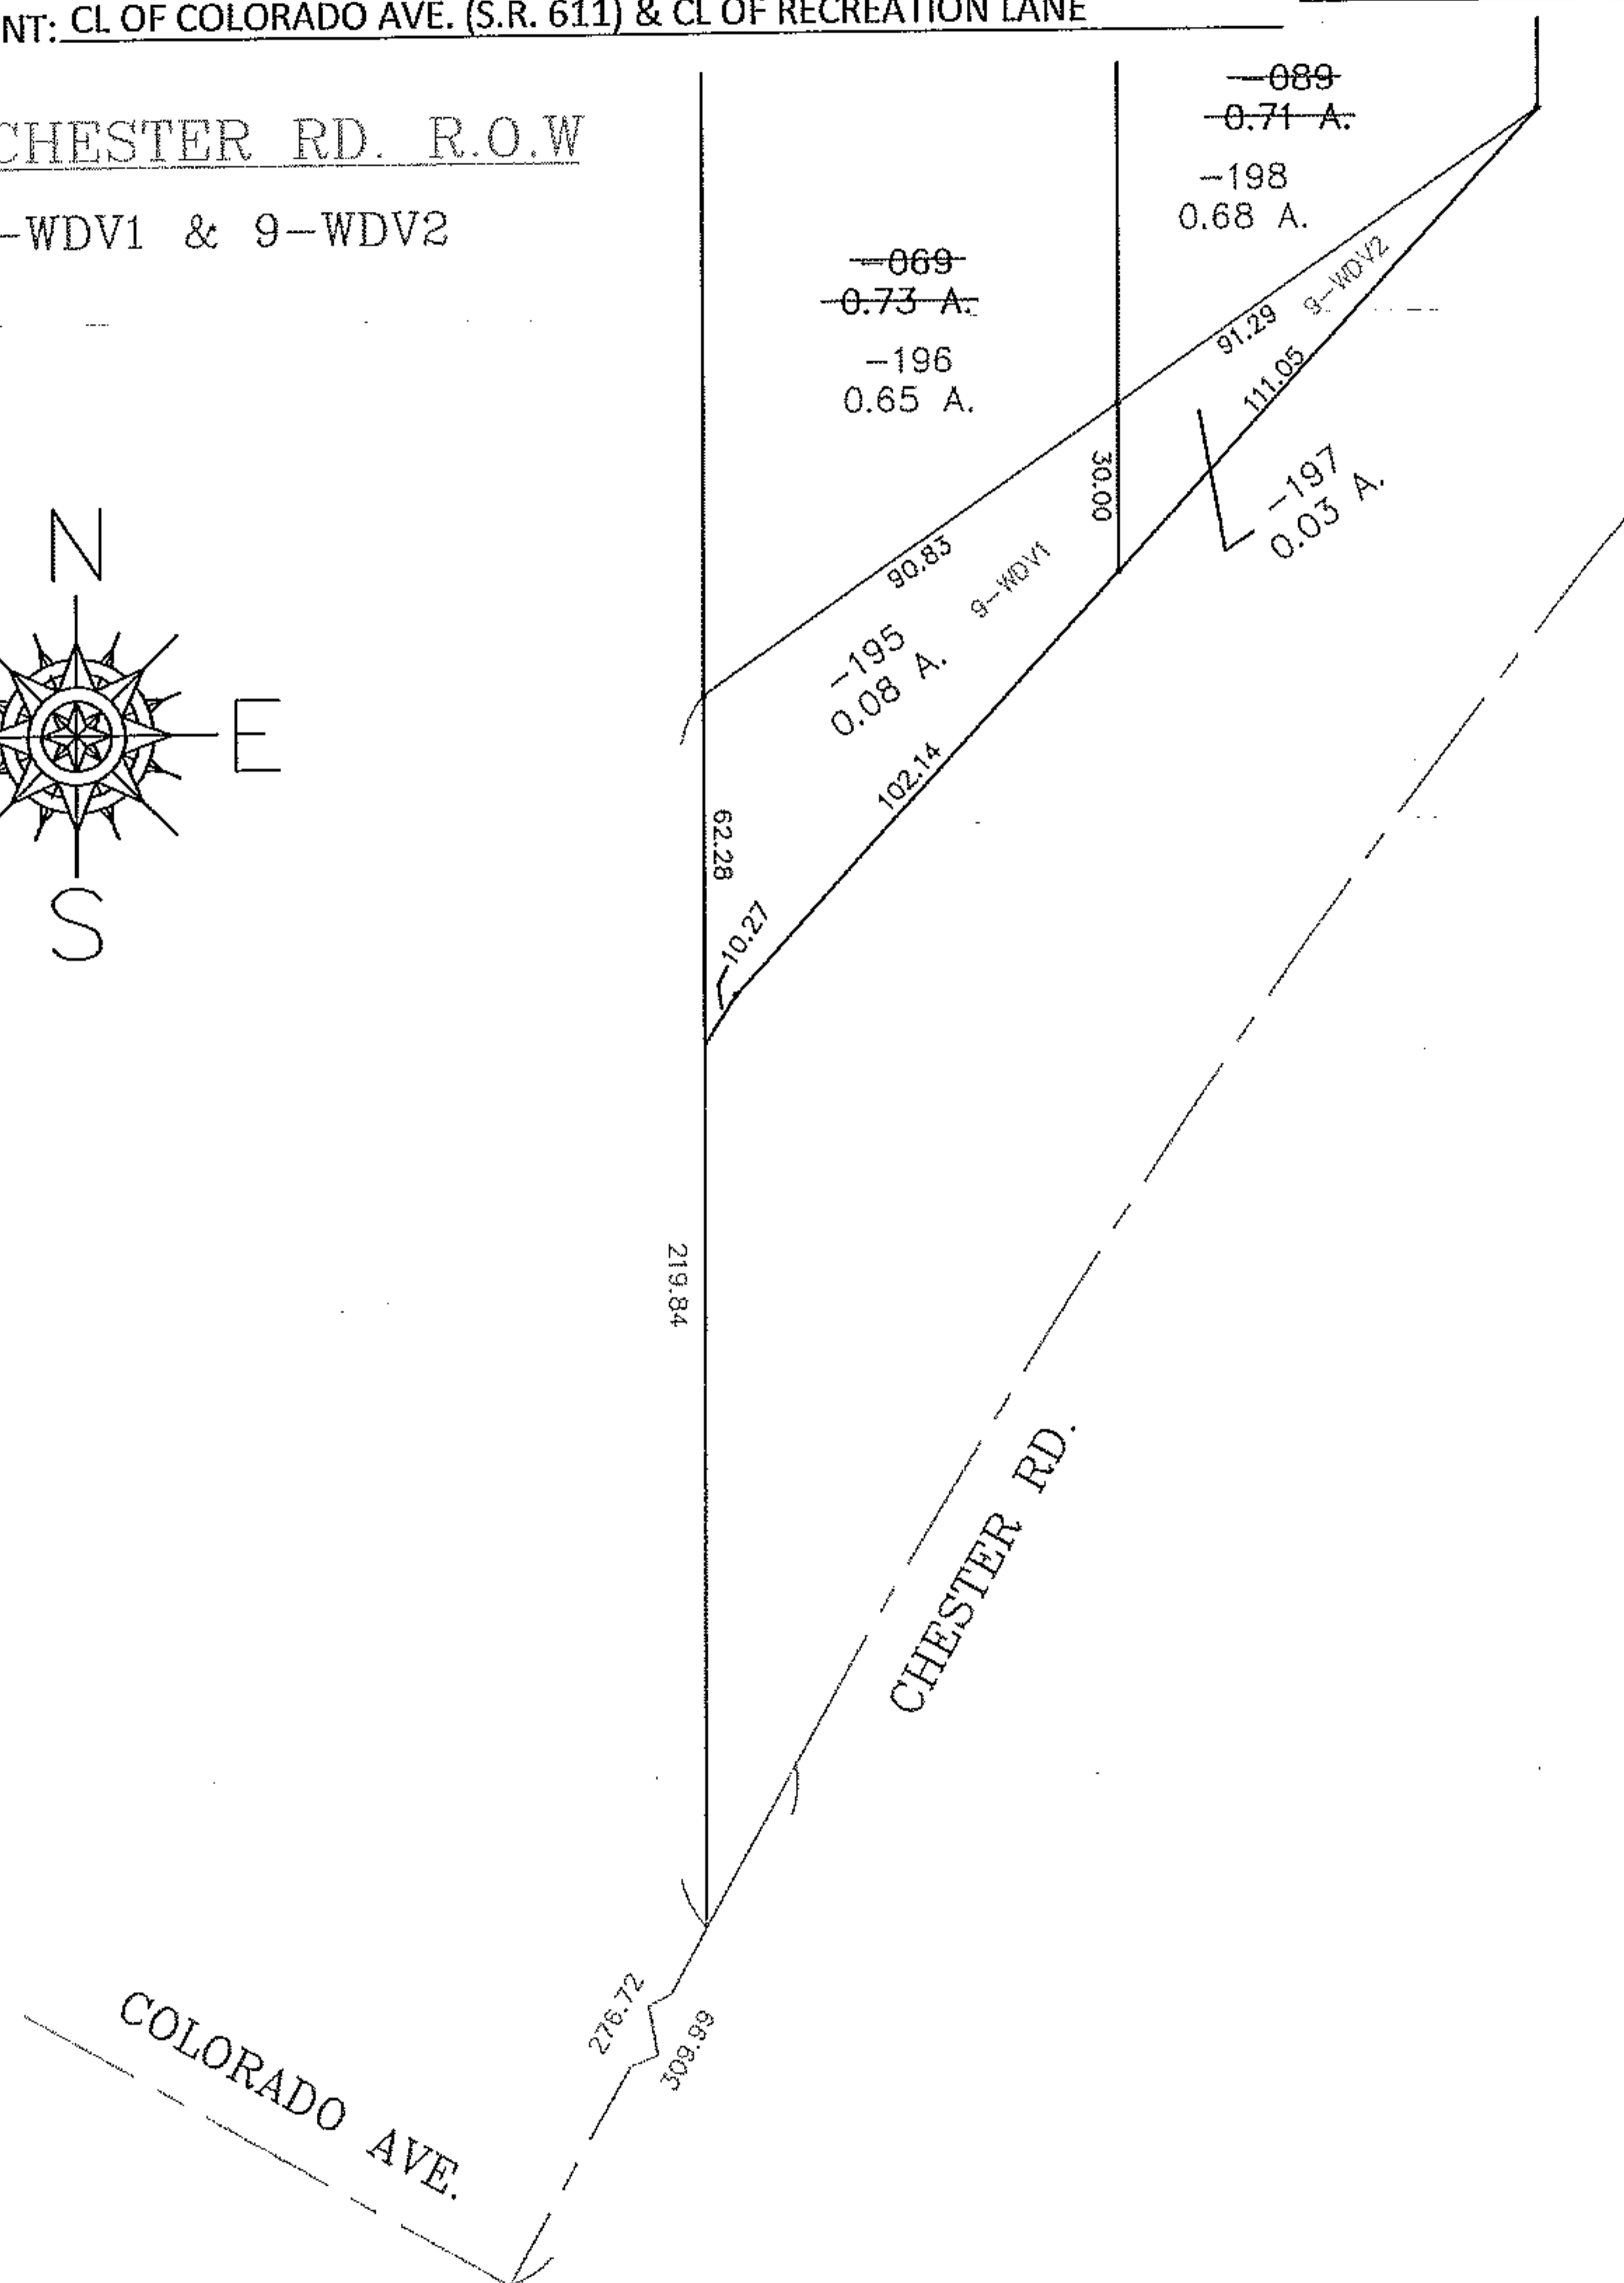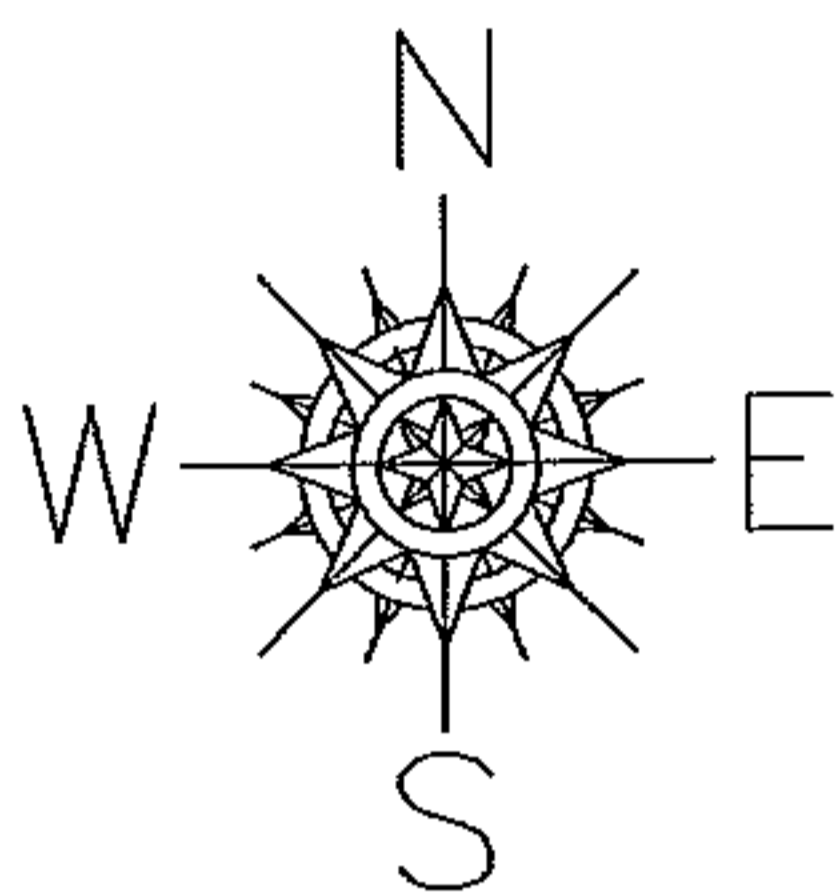

SPLITS/DEEDS PROCESSED

LORAIN COUNTY TAX MAP DEPARTMENT
226 MIDDLE AVE. ELYRIA, OHIO

SURVEYED BY: BRENT ANDERSON

CLOSURE: 0.01 : 10,000

MAP PAGE(S): 4-00-004

APPROVED BY: TJS DATE: 5/11/14

SCALE: 1"= 50' PRIOR INST.: 20100338932