

PARENT PARCEL: 04-00-004-102-117

CHILD PARCEL: 04-00-004-102-199 THRU -200

STARTING POINT: CL OF COLORADO AVE. (S.R. 611) & CL OF RECREATION LANE

14-00484

LOR-CHESTER RD. R.O.W

10-WDV




REM.  
-200  
14.05 A.

-199  
0.46 A.

REM.  
-200  
14.05 A.

-117  
~~14.51 A.~~

102

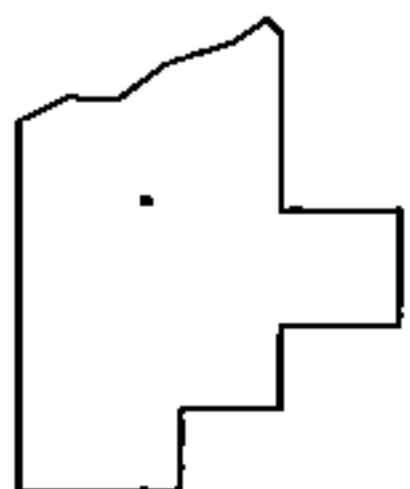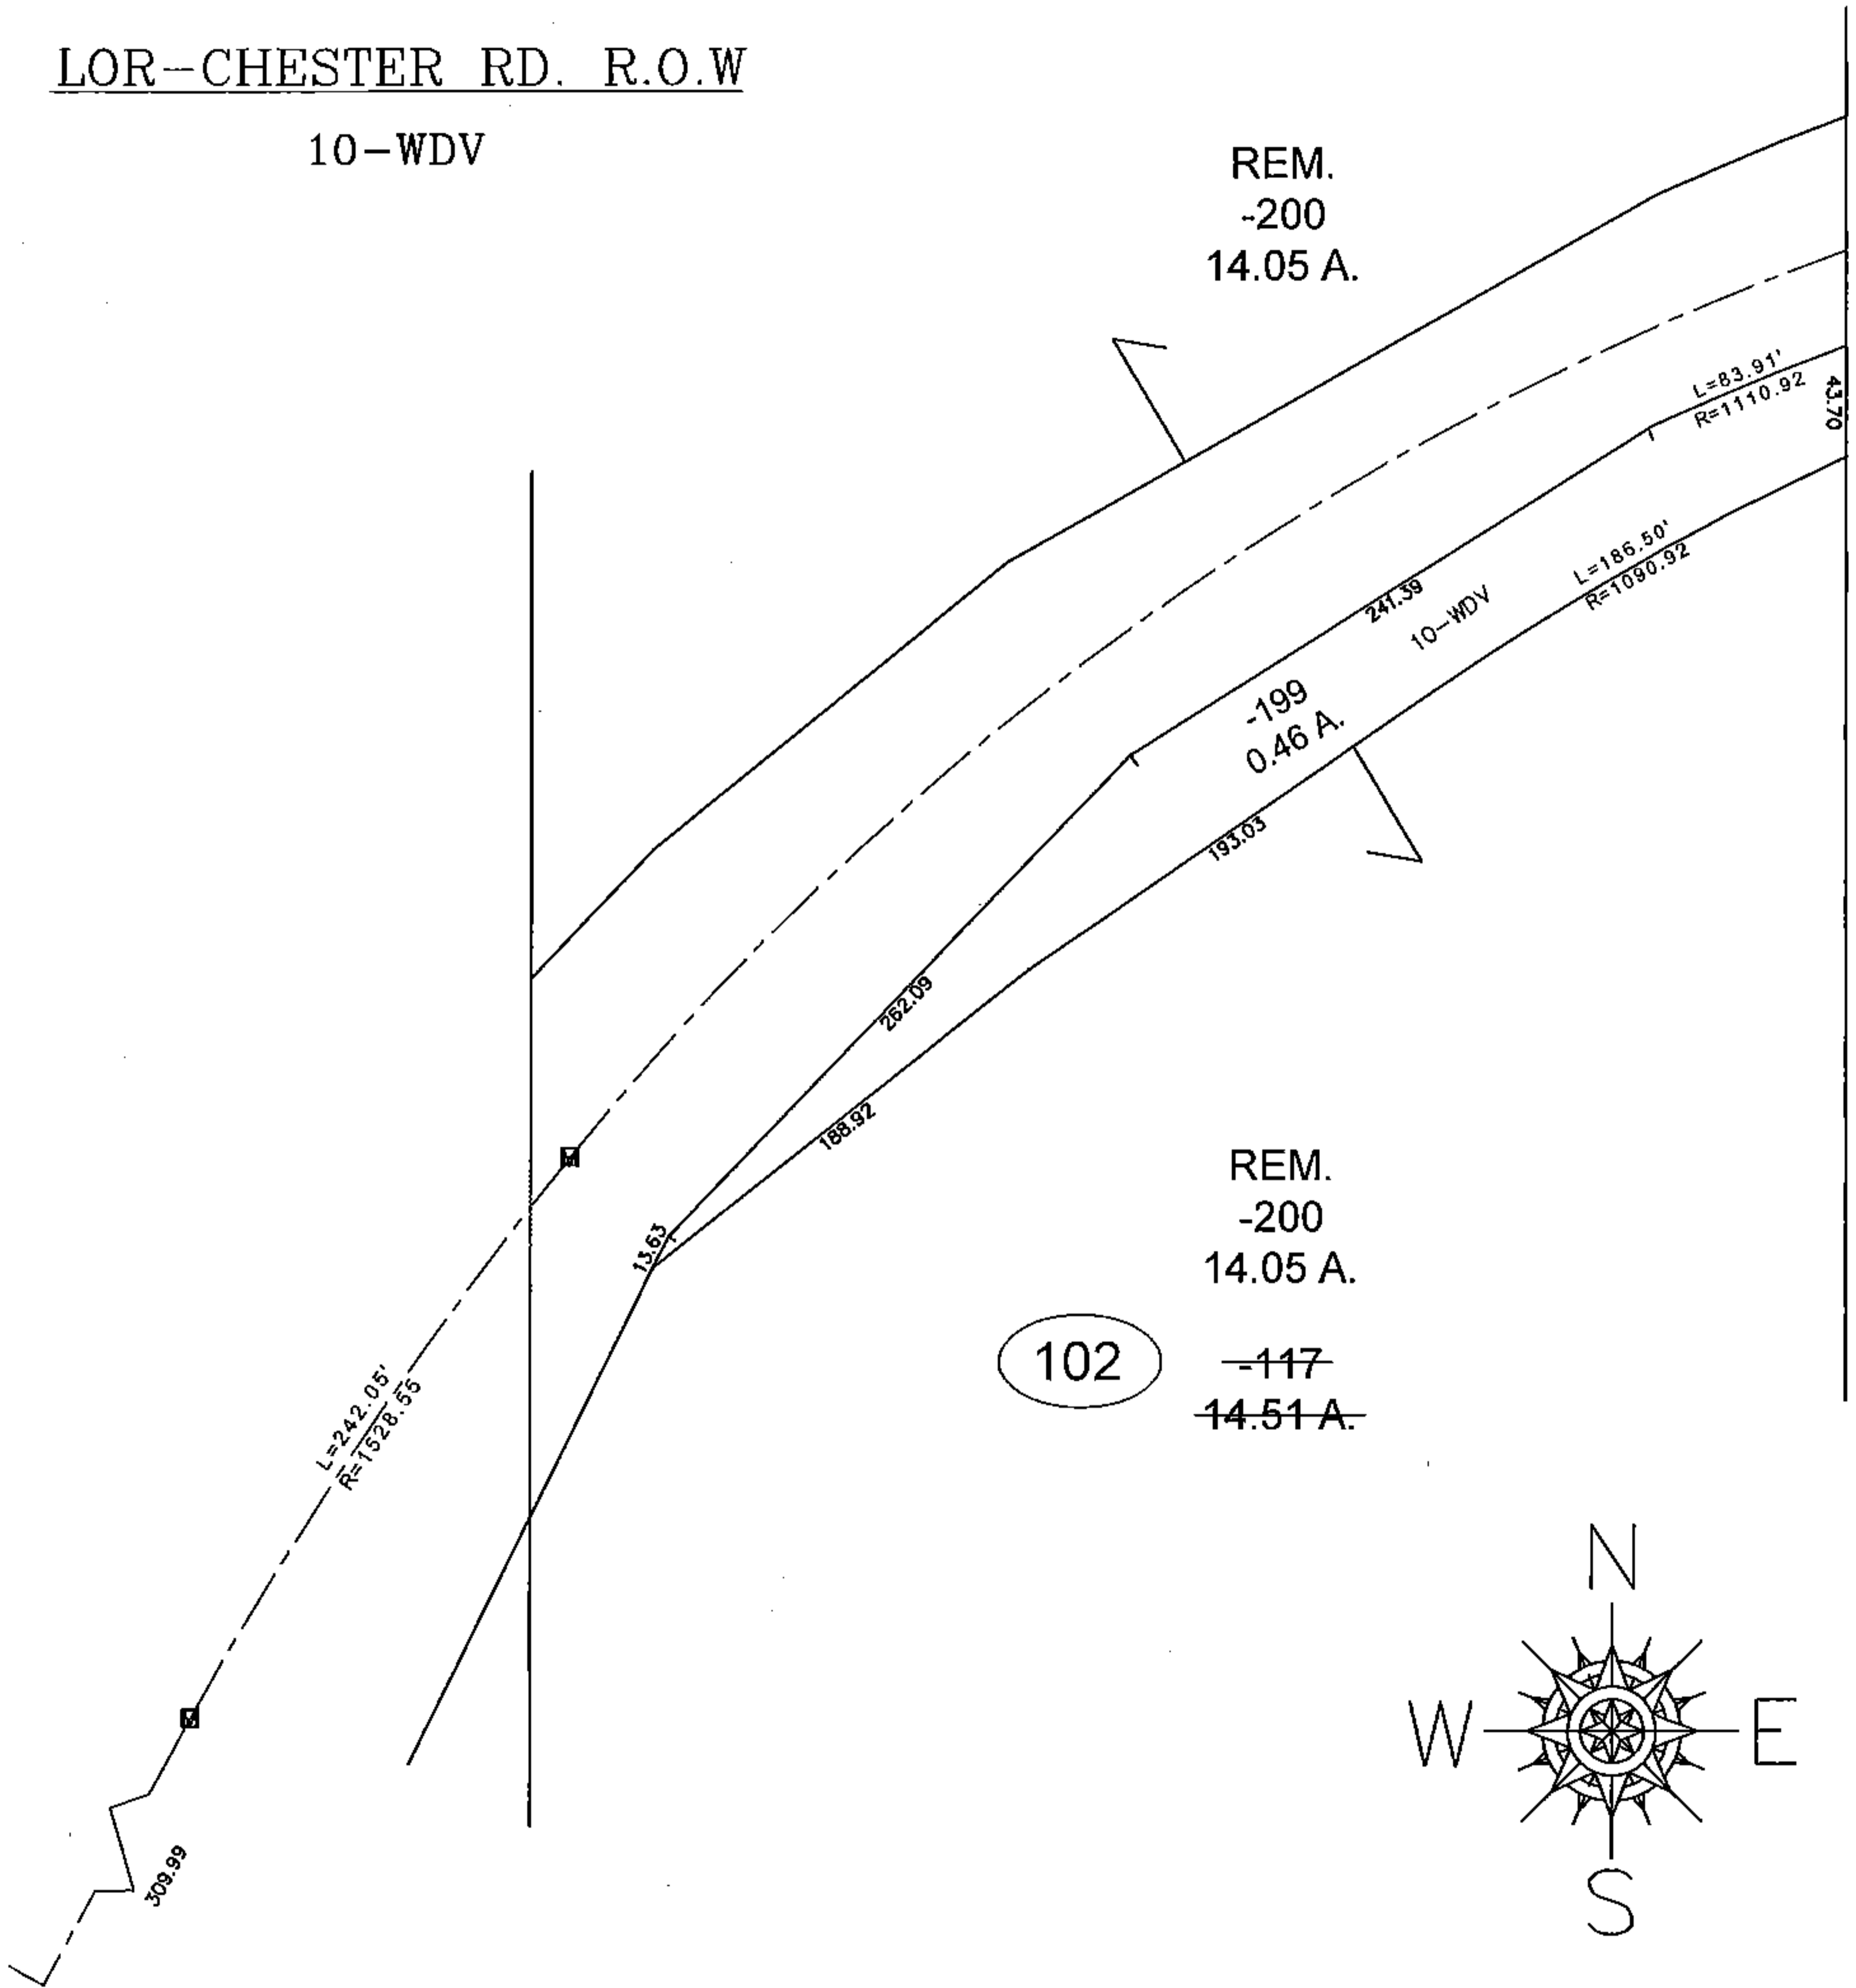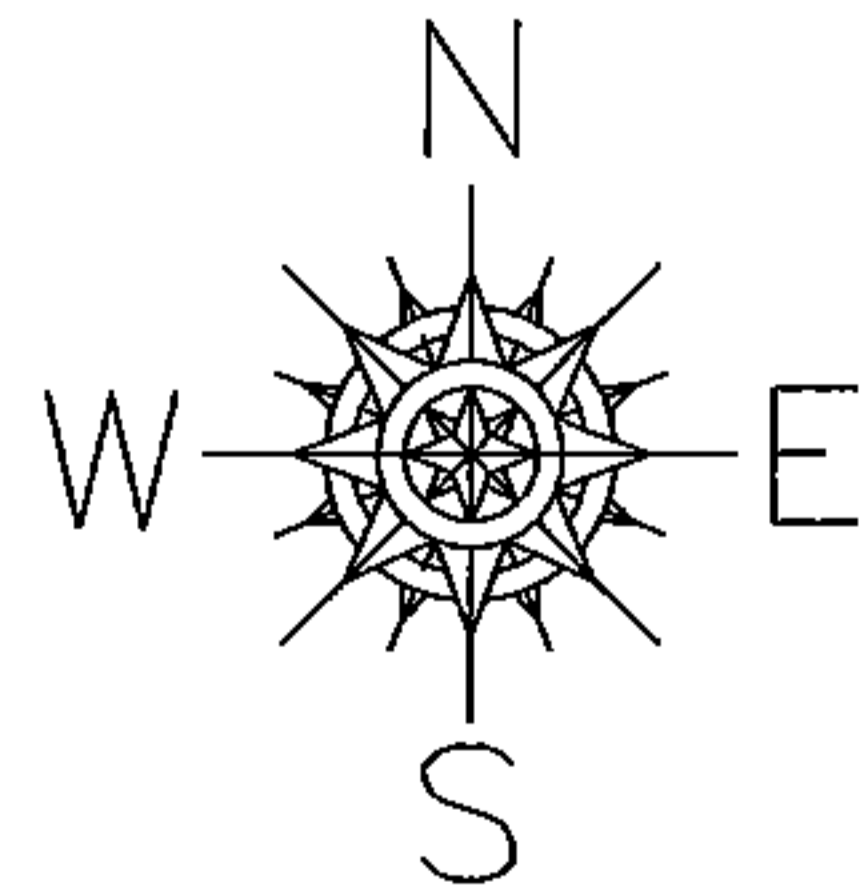

SPLITS/DEEDS PROCESSED

LORAIN COUNTY TAX MAP DEPARTMENT  
226 MIDDLE AVE. ELYRIA, OHIO

SURVEYED BY: BRENT ANDERSON

CLOSURE: 0.01 : 10,000

MAP PAGE(S): 4-00-004

APPROVED BY: TJS DATE: 5/22/14

SCALE: 1"=100' PRIOR INST.: 20050089213