

PARENT PARCEL: 04-00-004-102-175




CHILD PARCEL: 04-00-004-102-201 THRU -202

STARTING POINT: CL OF COLORADO AVE. (S.R. 611) & CL OF RECREATION LANE

14-00485

LOR-CHESTER RD. R.O.W

12-WDV

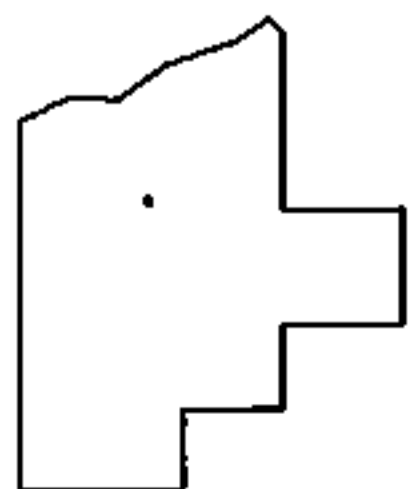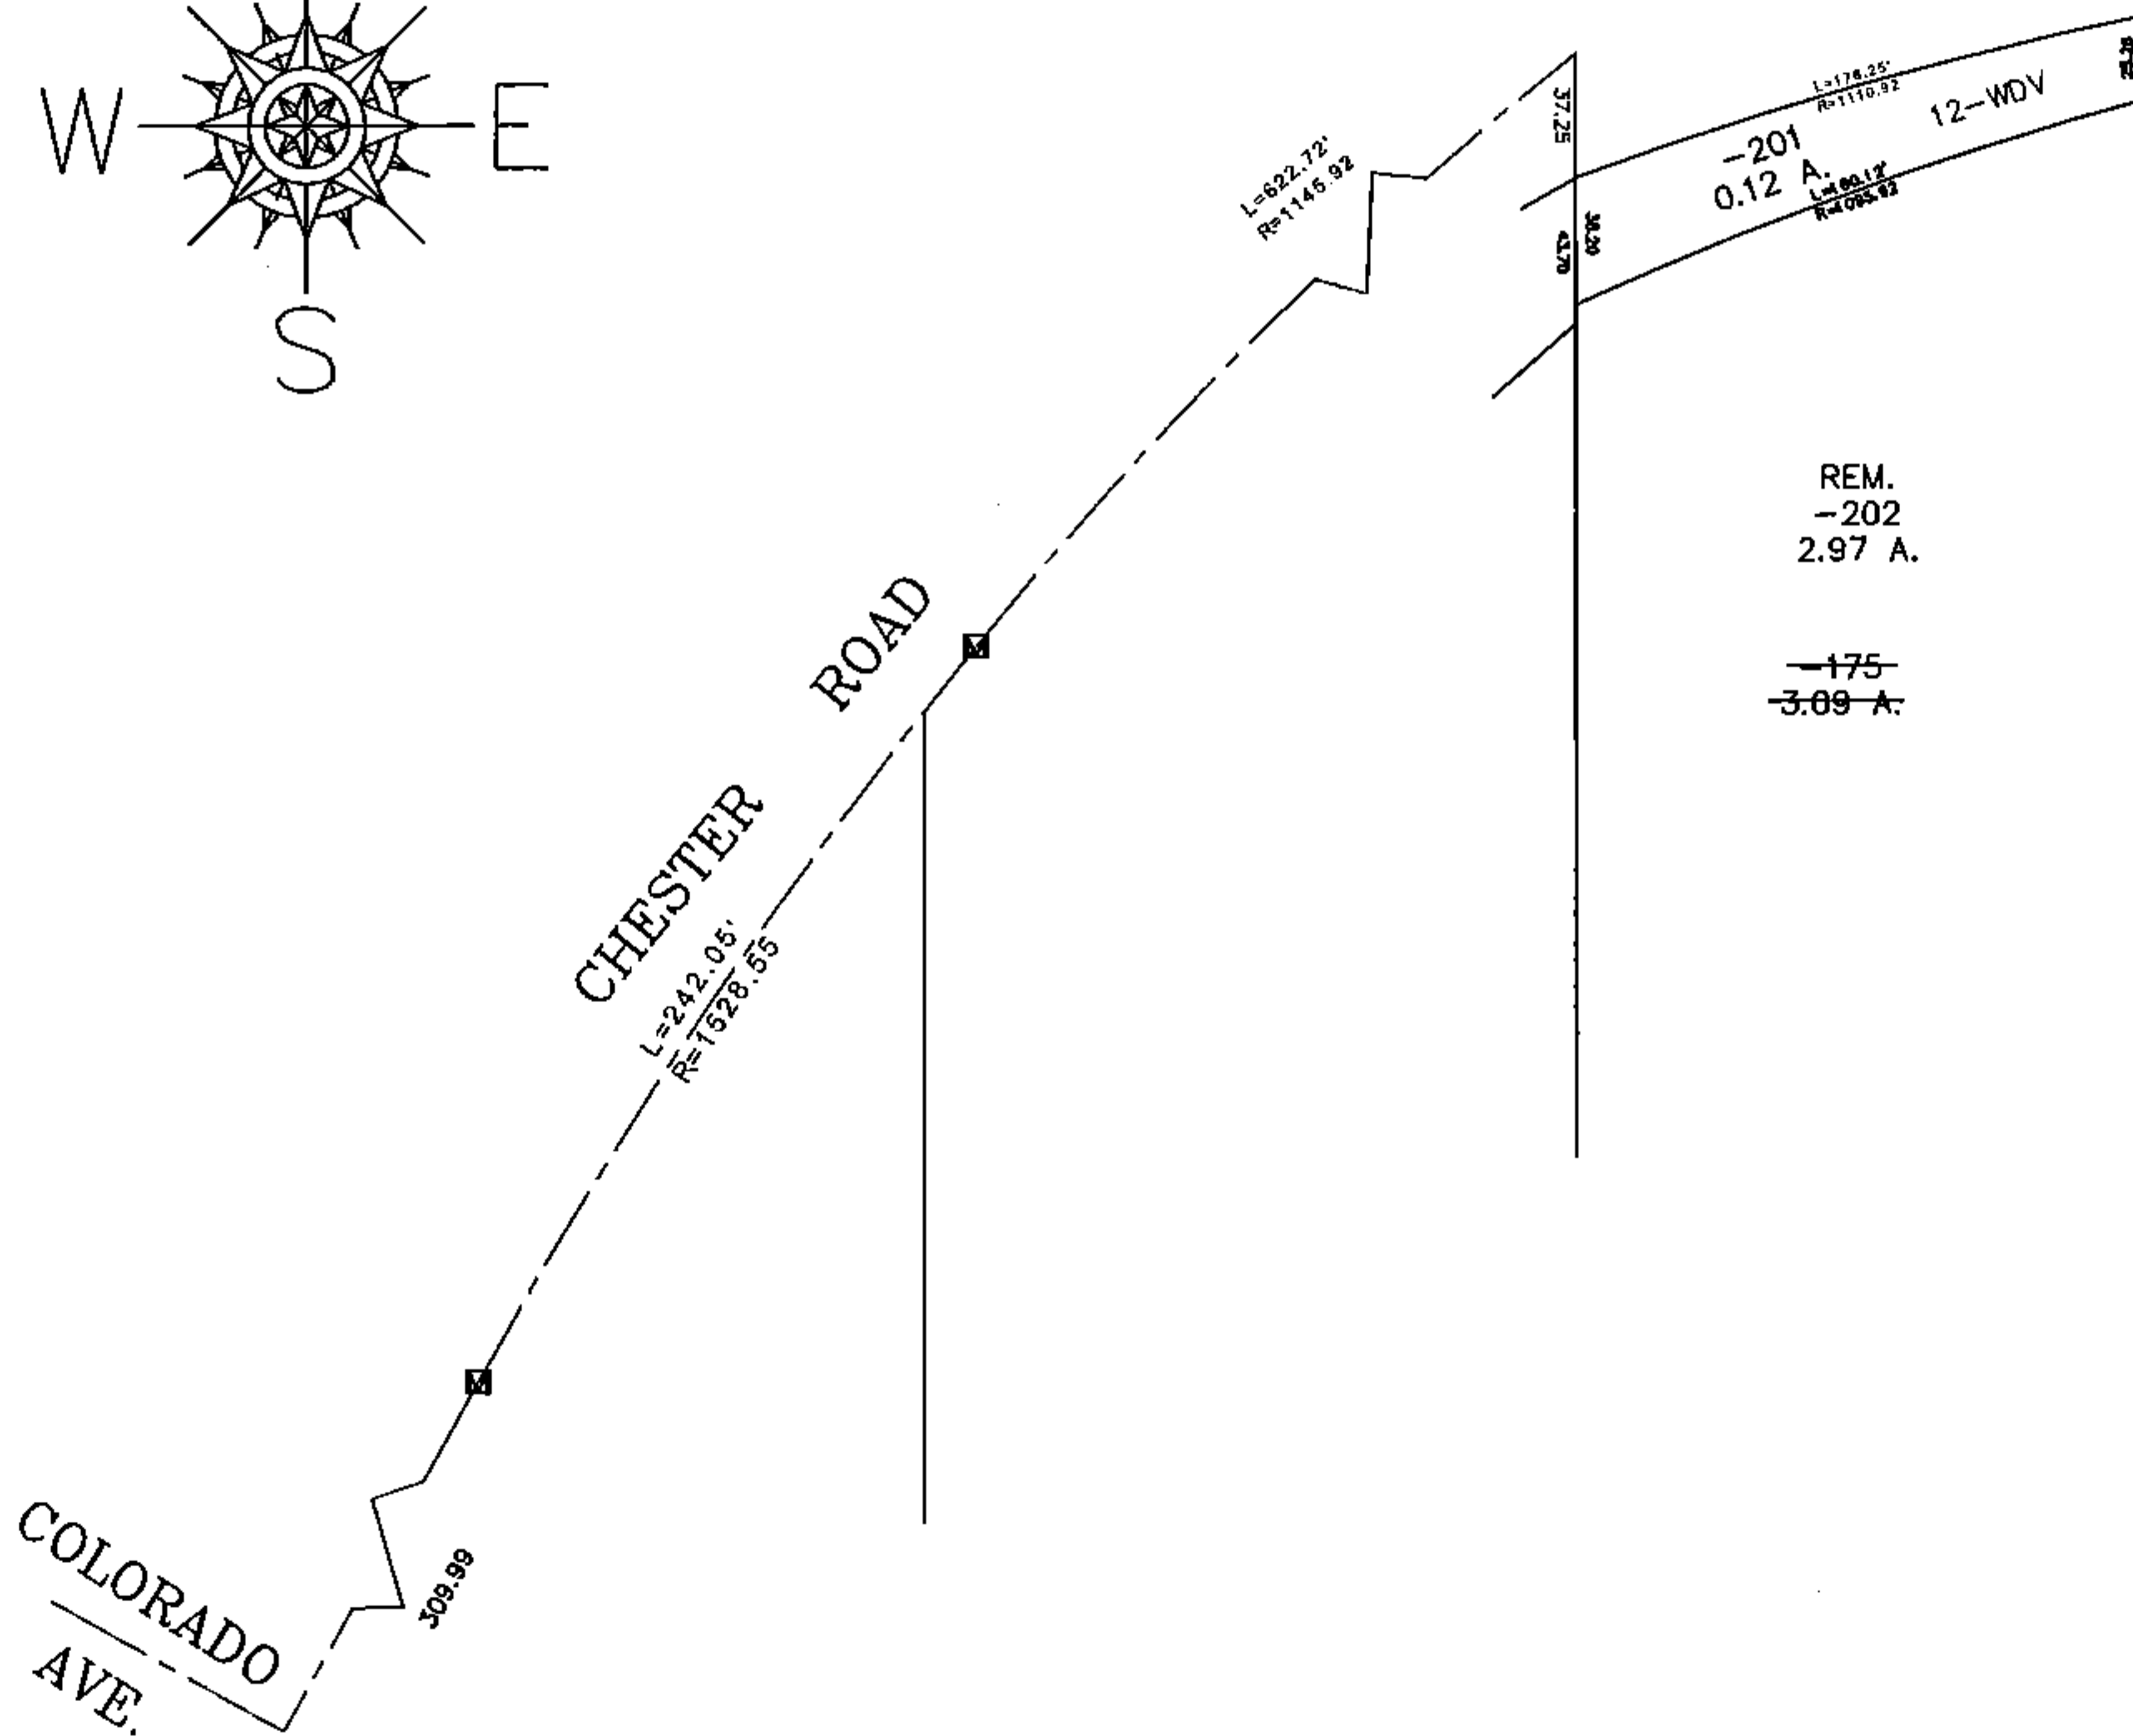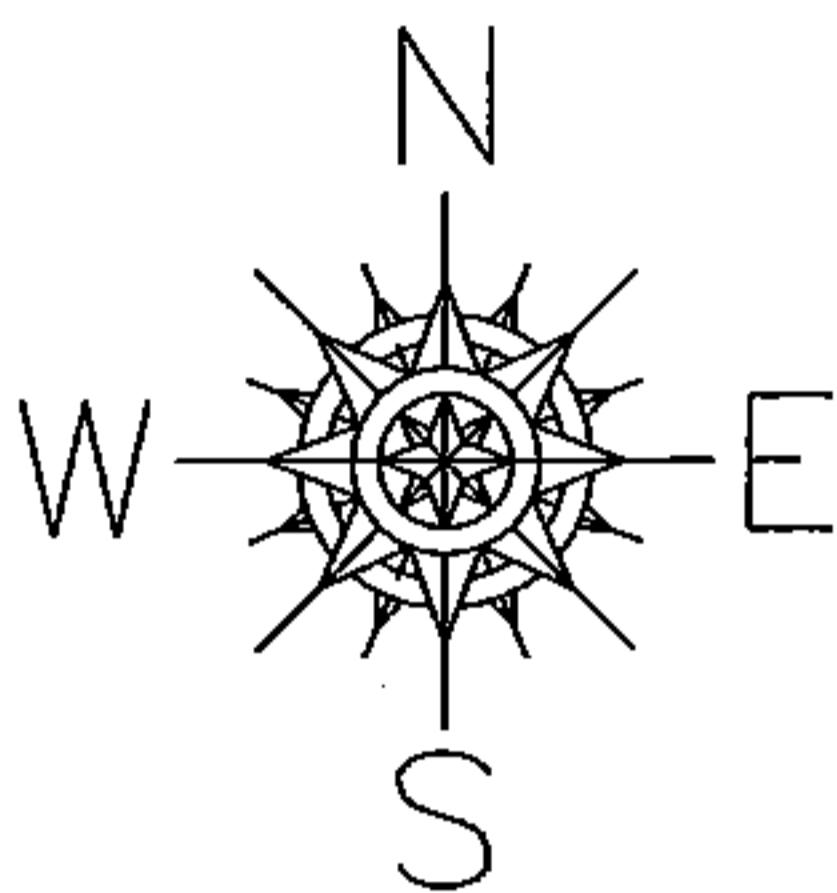

SPLITS/DEEDS PROCESSED

LORAIN COUNTY TAX MAP DEPARTMENT  
226 MIDDLE AVE. ELYRIA, OHIO

SURVEYED BY: BRENT ANDERSON

CLOSURE: 0.01 : 10,000

MAP PAGE(S): 4-00-004

APPROVED BY: TJS DATE: 5/23/14

SCALE: 1"= 100' PRIOR INST.: 20020857297