
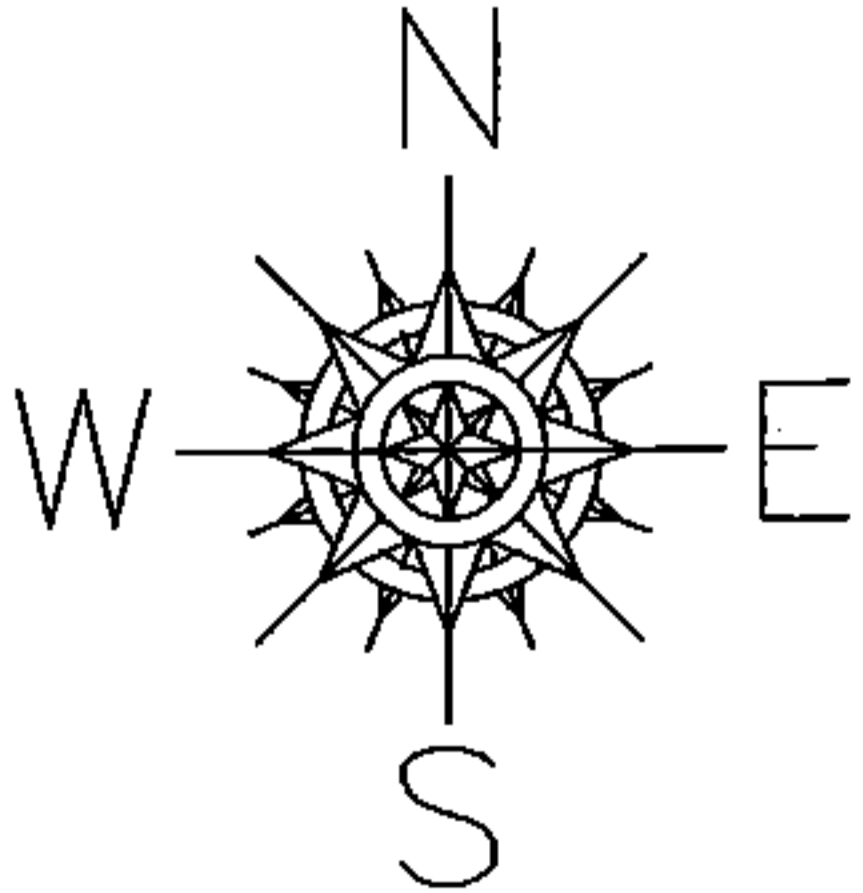


PARENT PARCEL: 07-00-028-103-016


CHILD PARCEL: 07-00-028-103-143, -144

STARTING POINT: AT A MON BOX AT THE INTERSECTION OF C/L OF CENTER RIDGE RD. AND C/L OF STONEY RIDGE RD.

14-00489

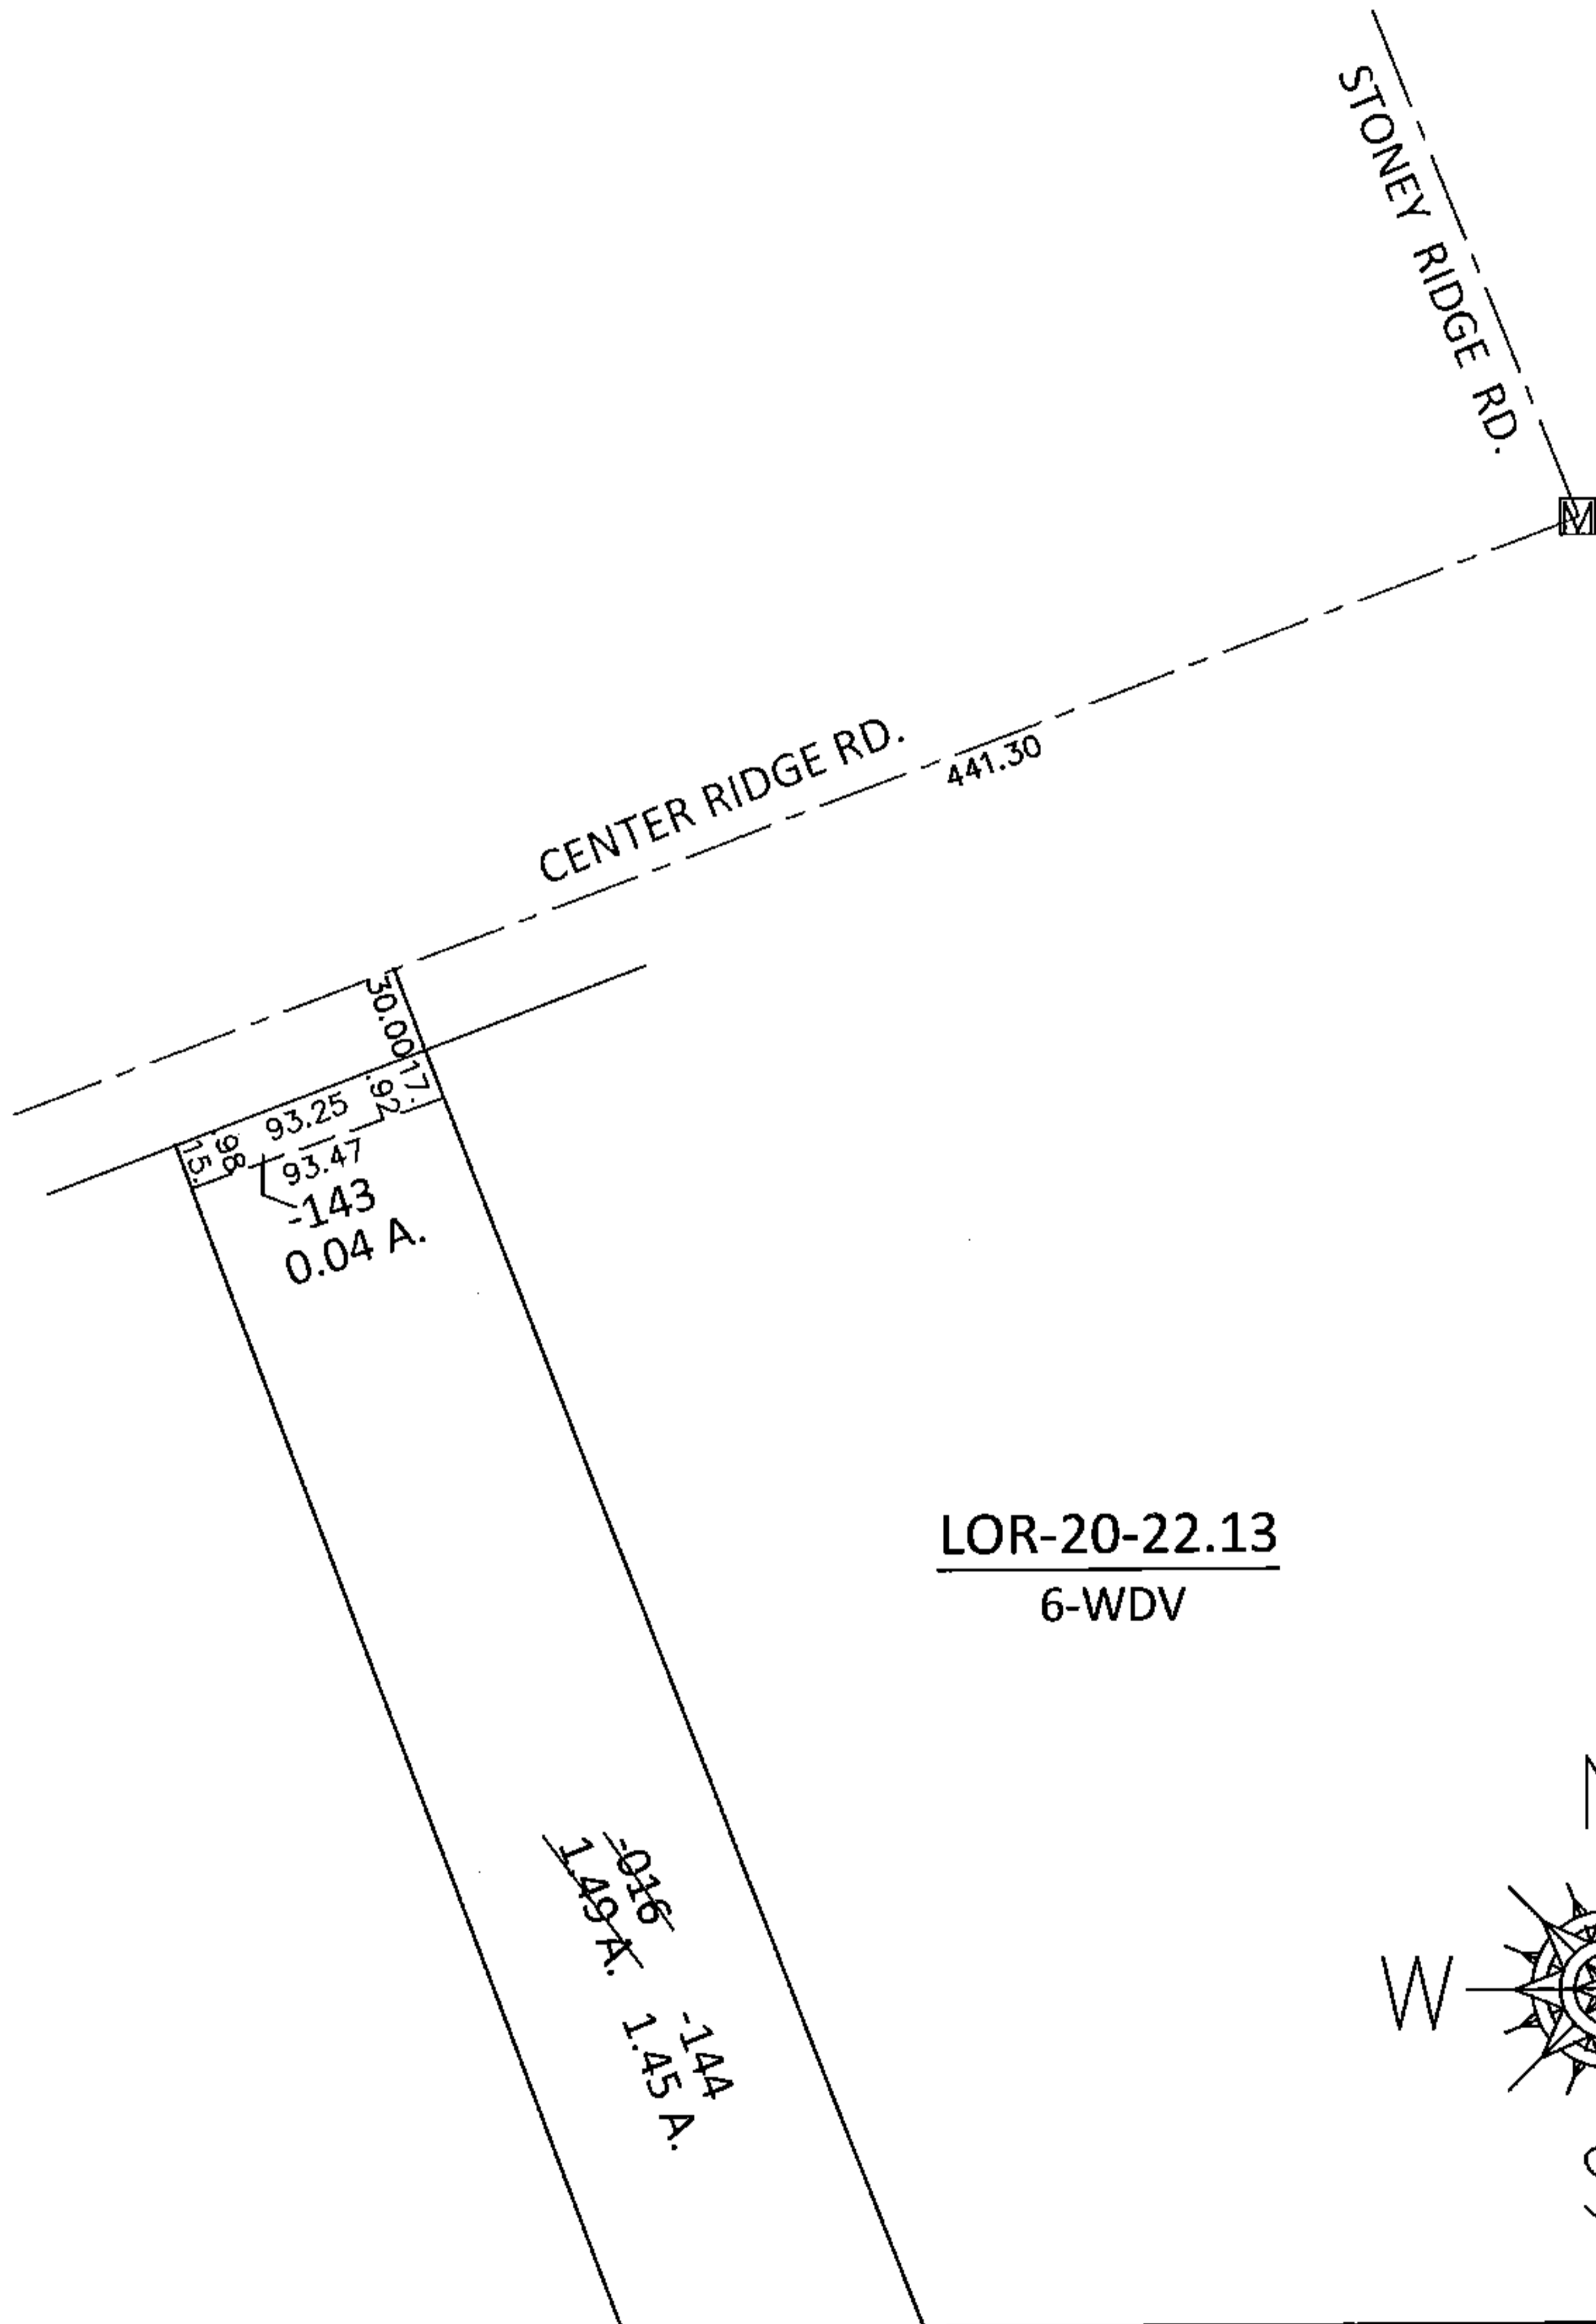

LOR-20-22.13
6-WDV

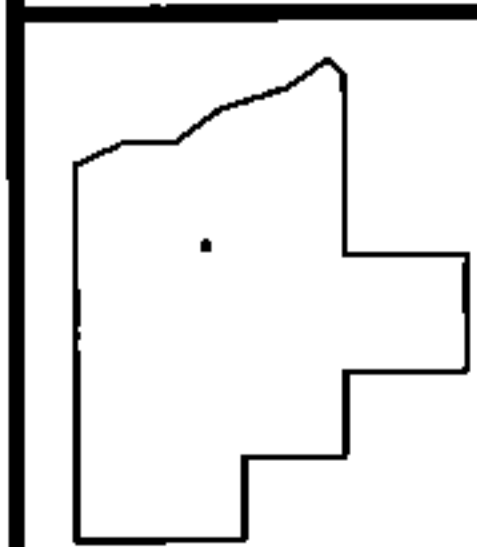

SPLITS/DEEDS PROCESSED

LORAIN COUNTY TAX MAP DEPARTMENT
226 MIDDLE AVE. ELYRIA, OHIO

SURVEYED BY: WILLIAM D. THOMAS
 CLOSURE: .01:10,000
 MAP PAGE(S): 7-00-028-D
 APPROVED BY: RRM DATE: 8-25-14
 SCALE: 1"= 100 PRIOR INST.: 19980516411