
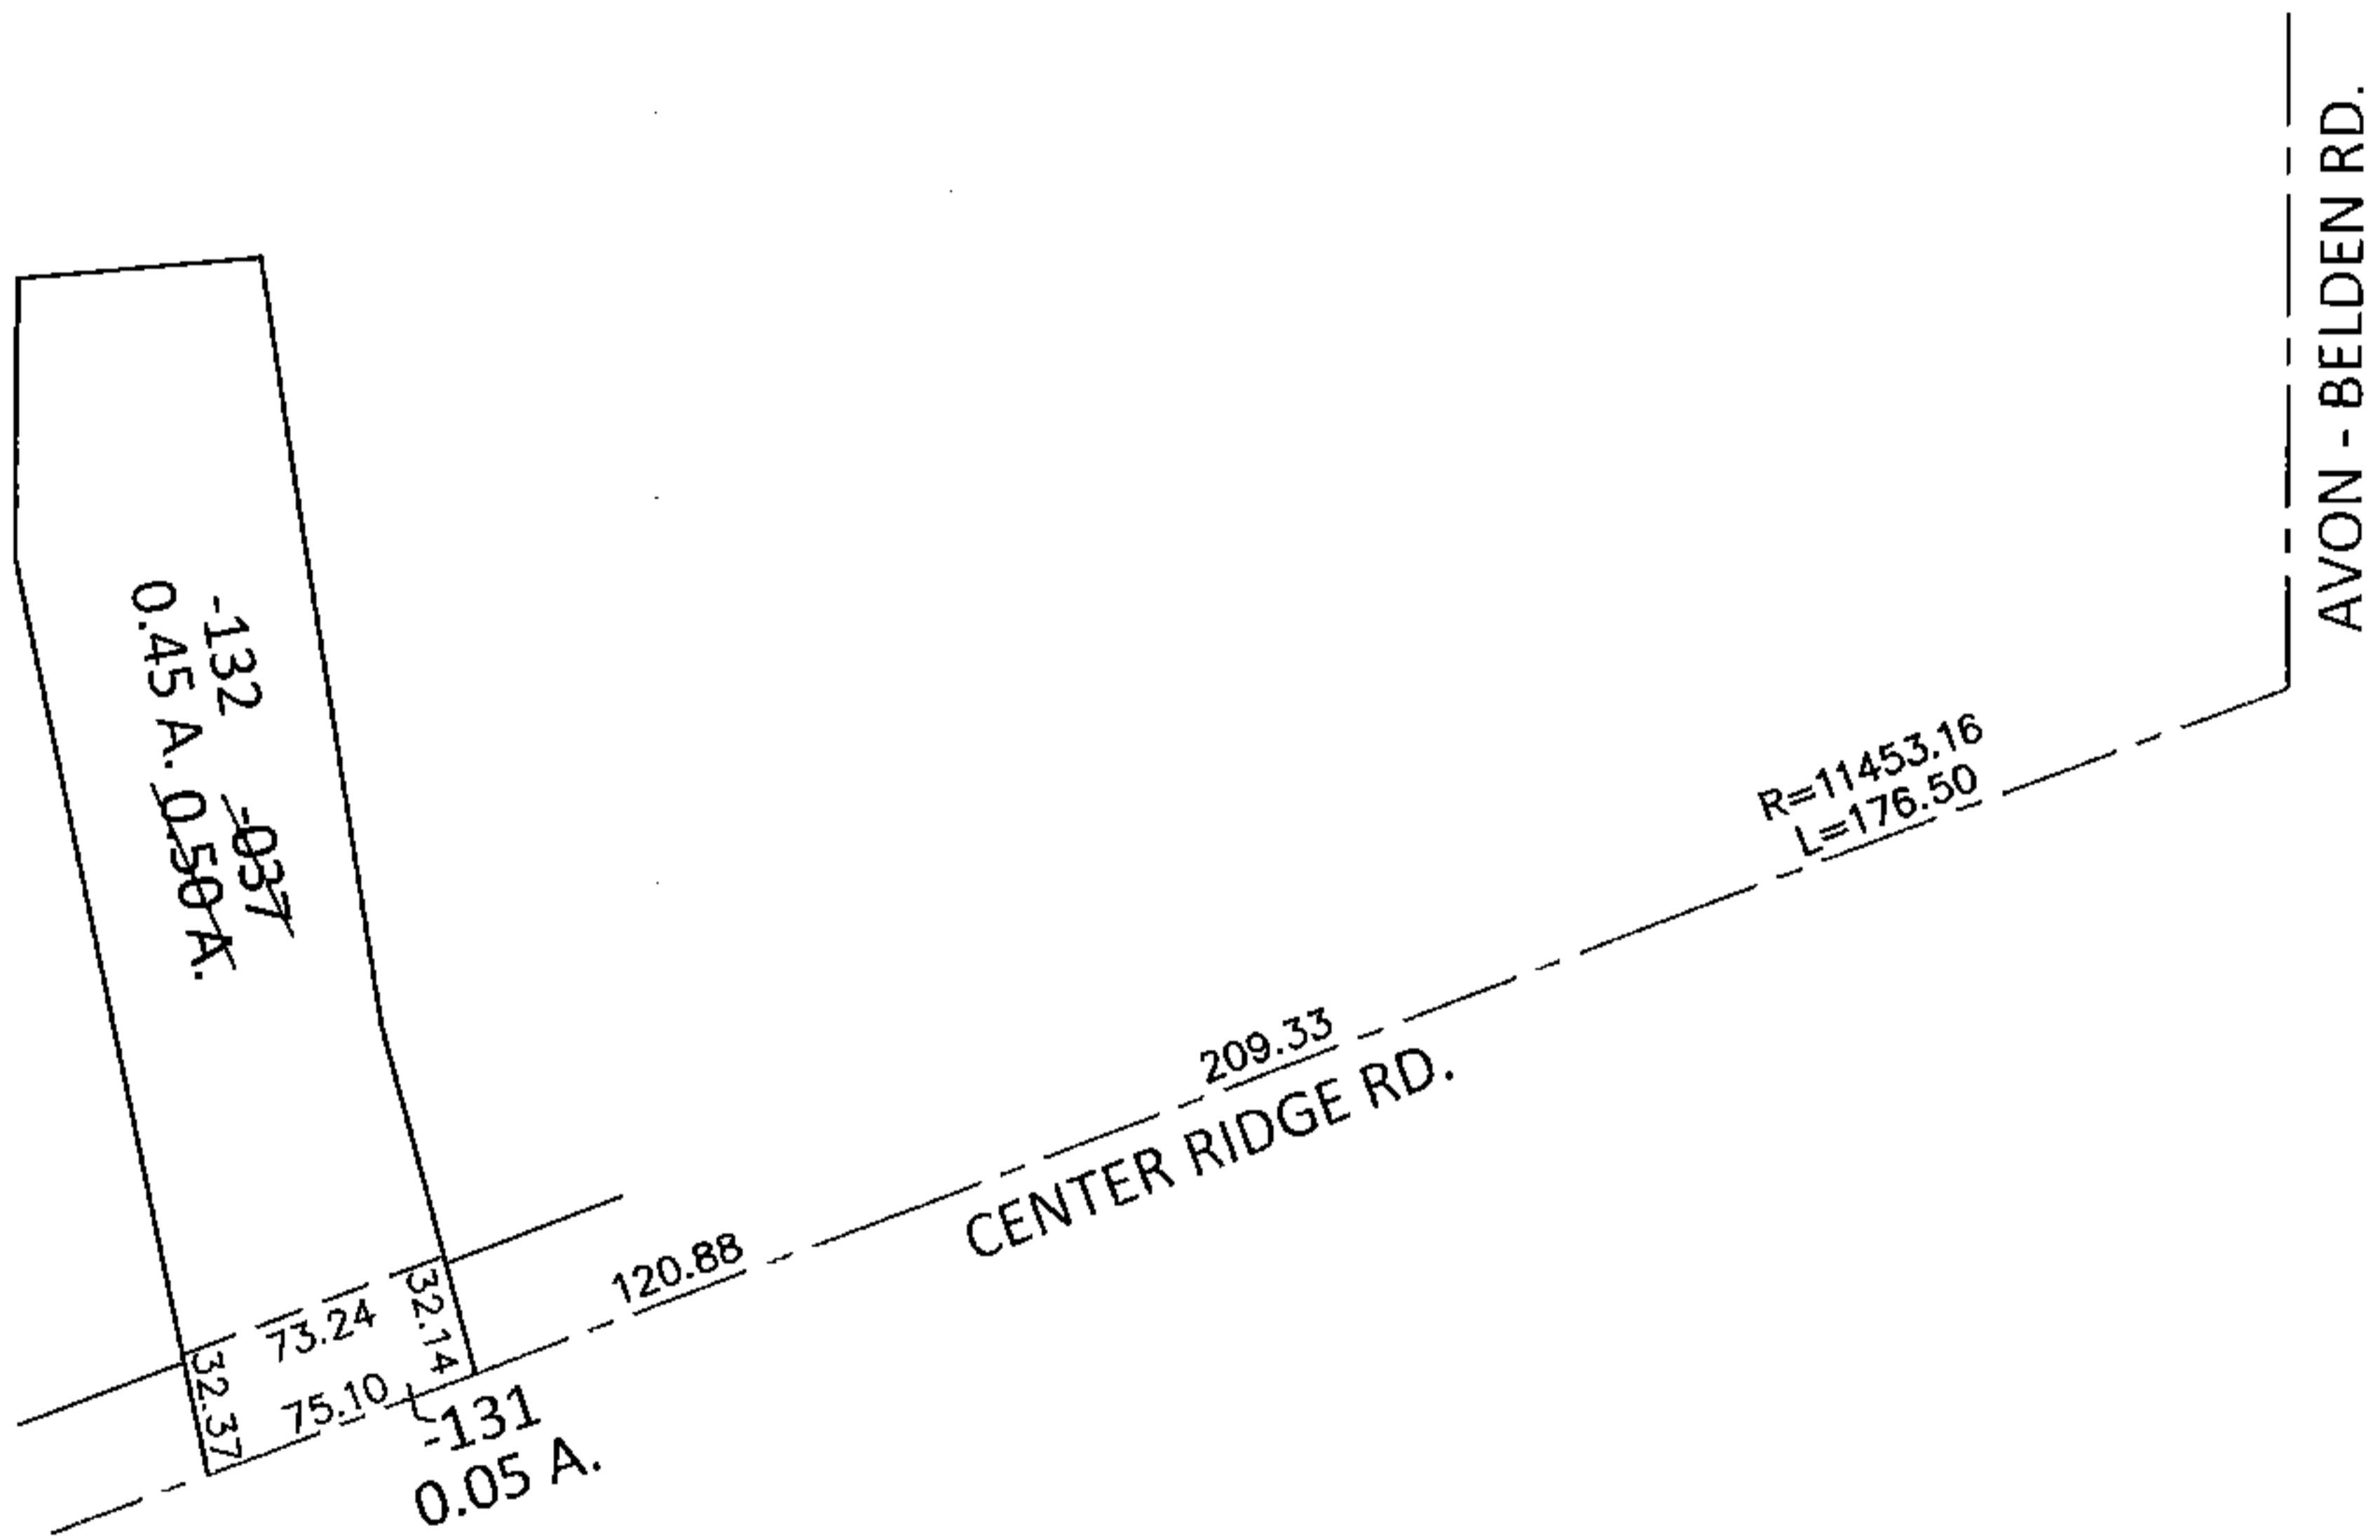


PARENT PARCEL: 07-00-028-102-037


CHILD PARCEL: 07-00-028-102-131, -132

STARTING POINT: INTERSECTION OF C/L OF CENTER RIDGE RD. AND C/L OF AVON - BELDEN RD.

**14-00508**

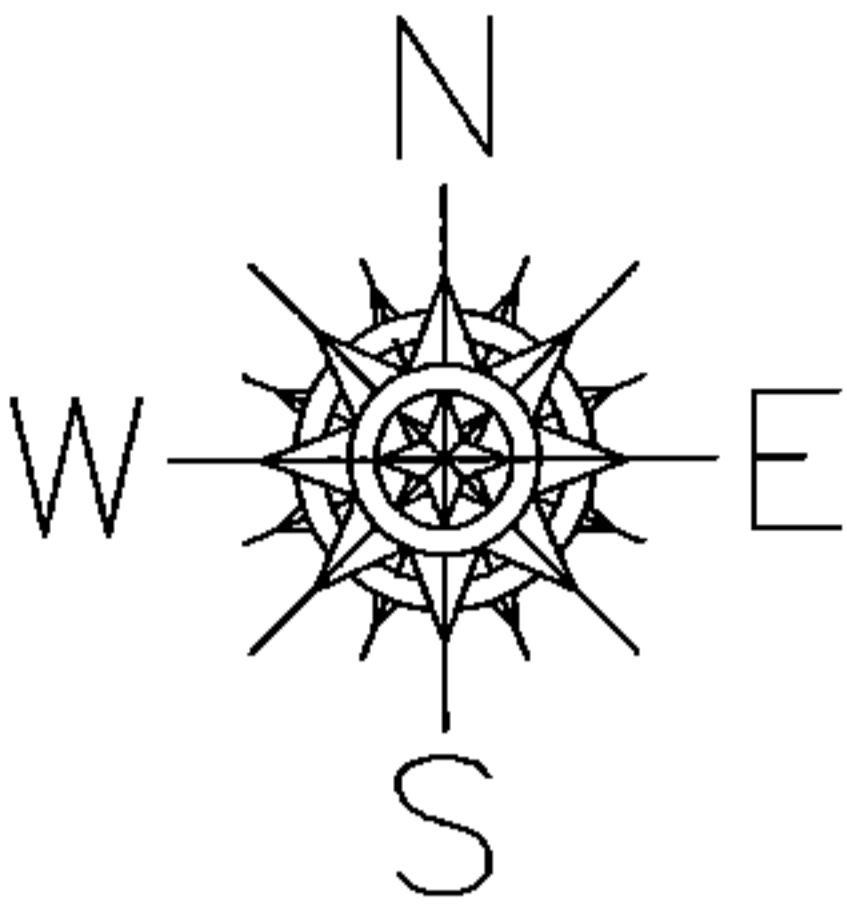

LOR-20-22.13  
28-WDV

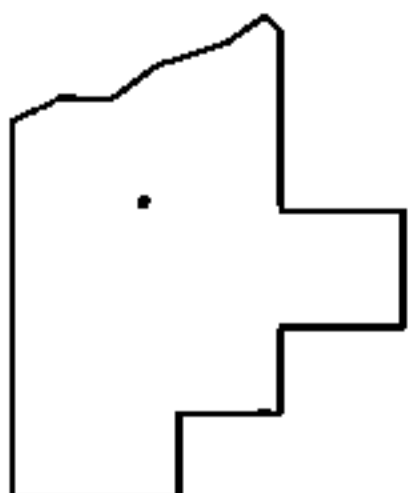

**SPLITS/DEEDS PROCESSED**

LORAIN COUNTY TAX MAP DEPARTMENT  
226 MIDDLE AVE. ELYRIA, OHIO

SURVEYED BY: WILLIAM D. THOMAS  
CLOSURE: .01:10,000  
MAP PAGE(S): 7-00-028-D  
APPROVED BY: RRM DATE: 8-26-14  
SCALE: 1"= 100 PRIOR INST.: DV 1310/152