


PARENT PARCEL: 07-00-021-117-056



CHILD PARCEL: 07-00-021-117-070, -071

14-00530

STARTING POINT: INTERSECTION OF C/L OF CENTER RIDGE RD. AND C/L OF AVON - BELDEN RD.

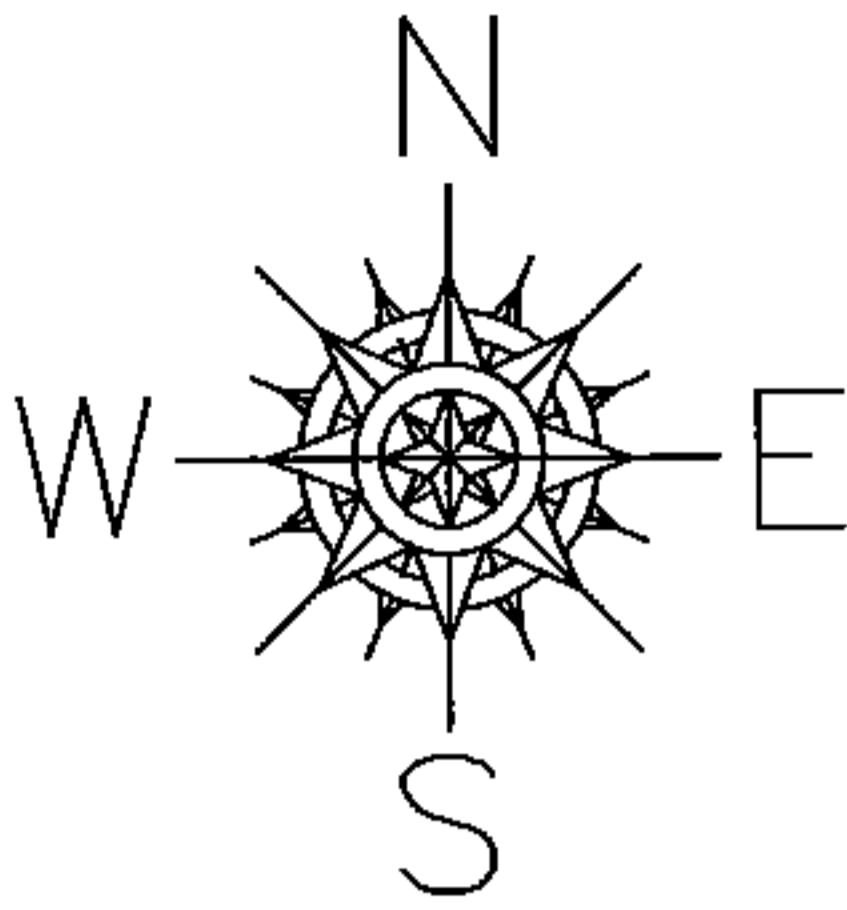

LOR-20-22.13
54-WDV

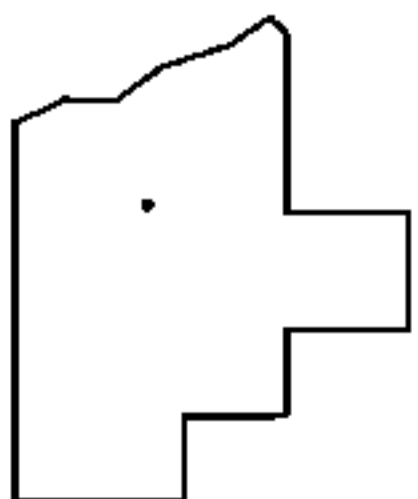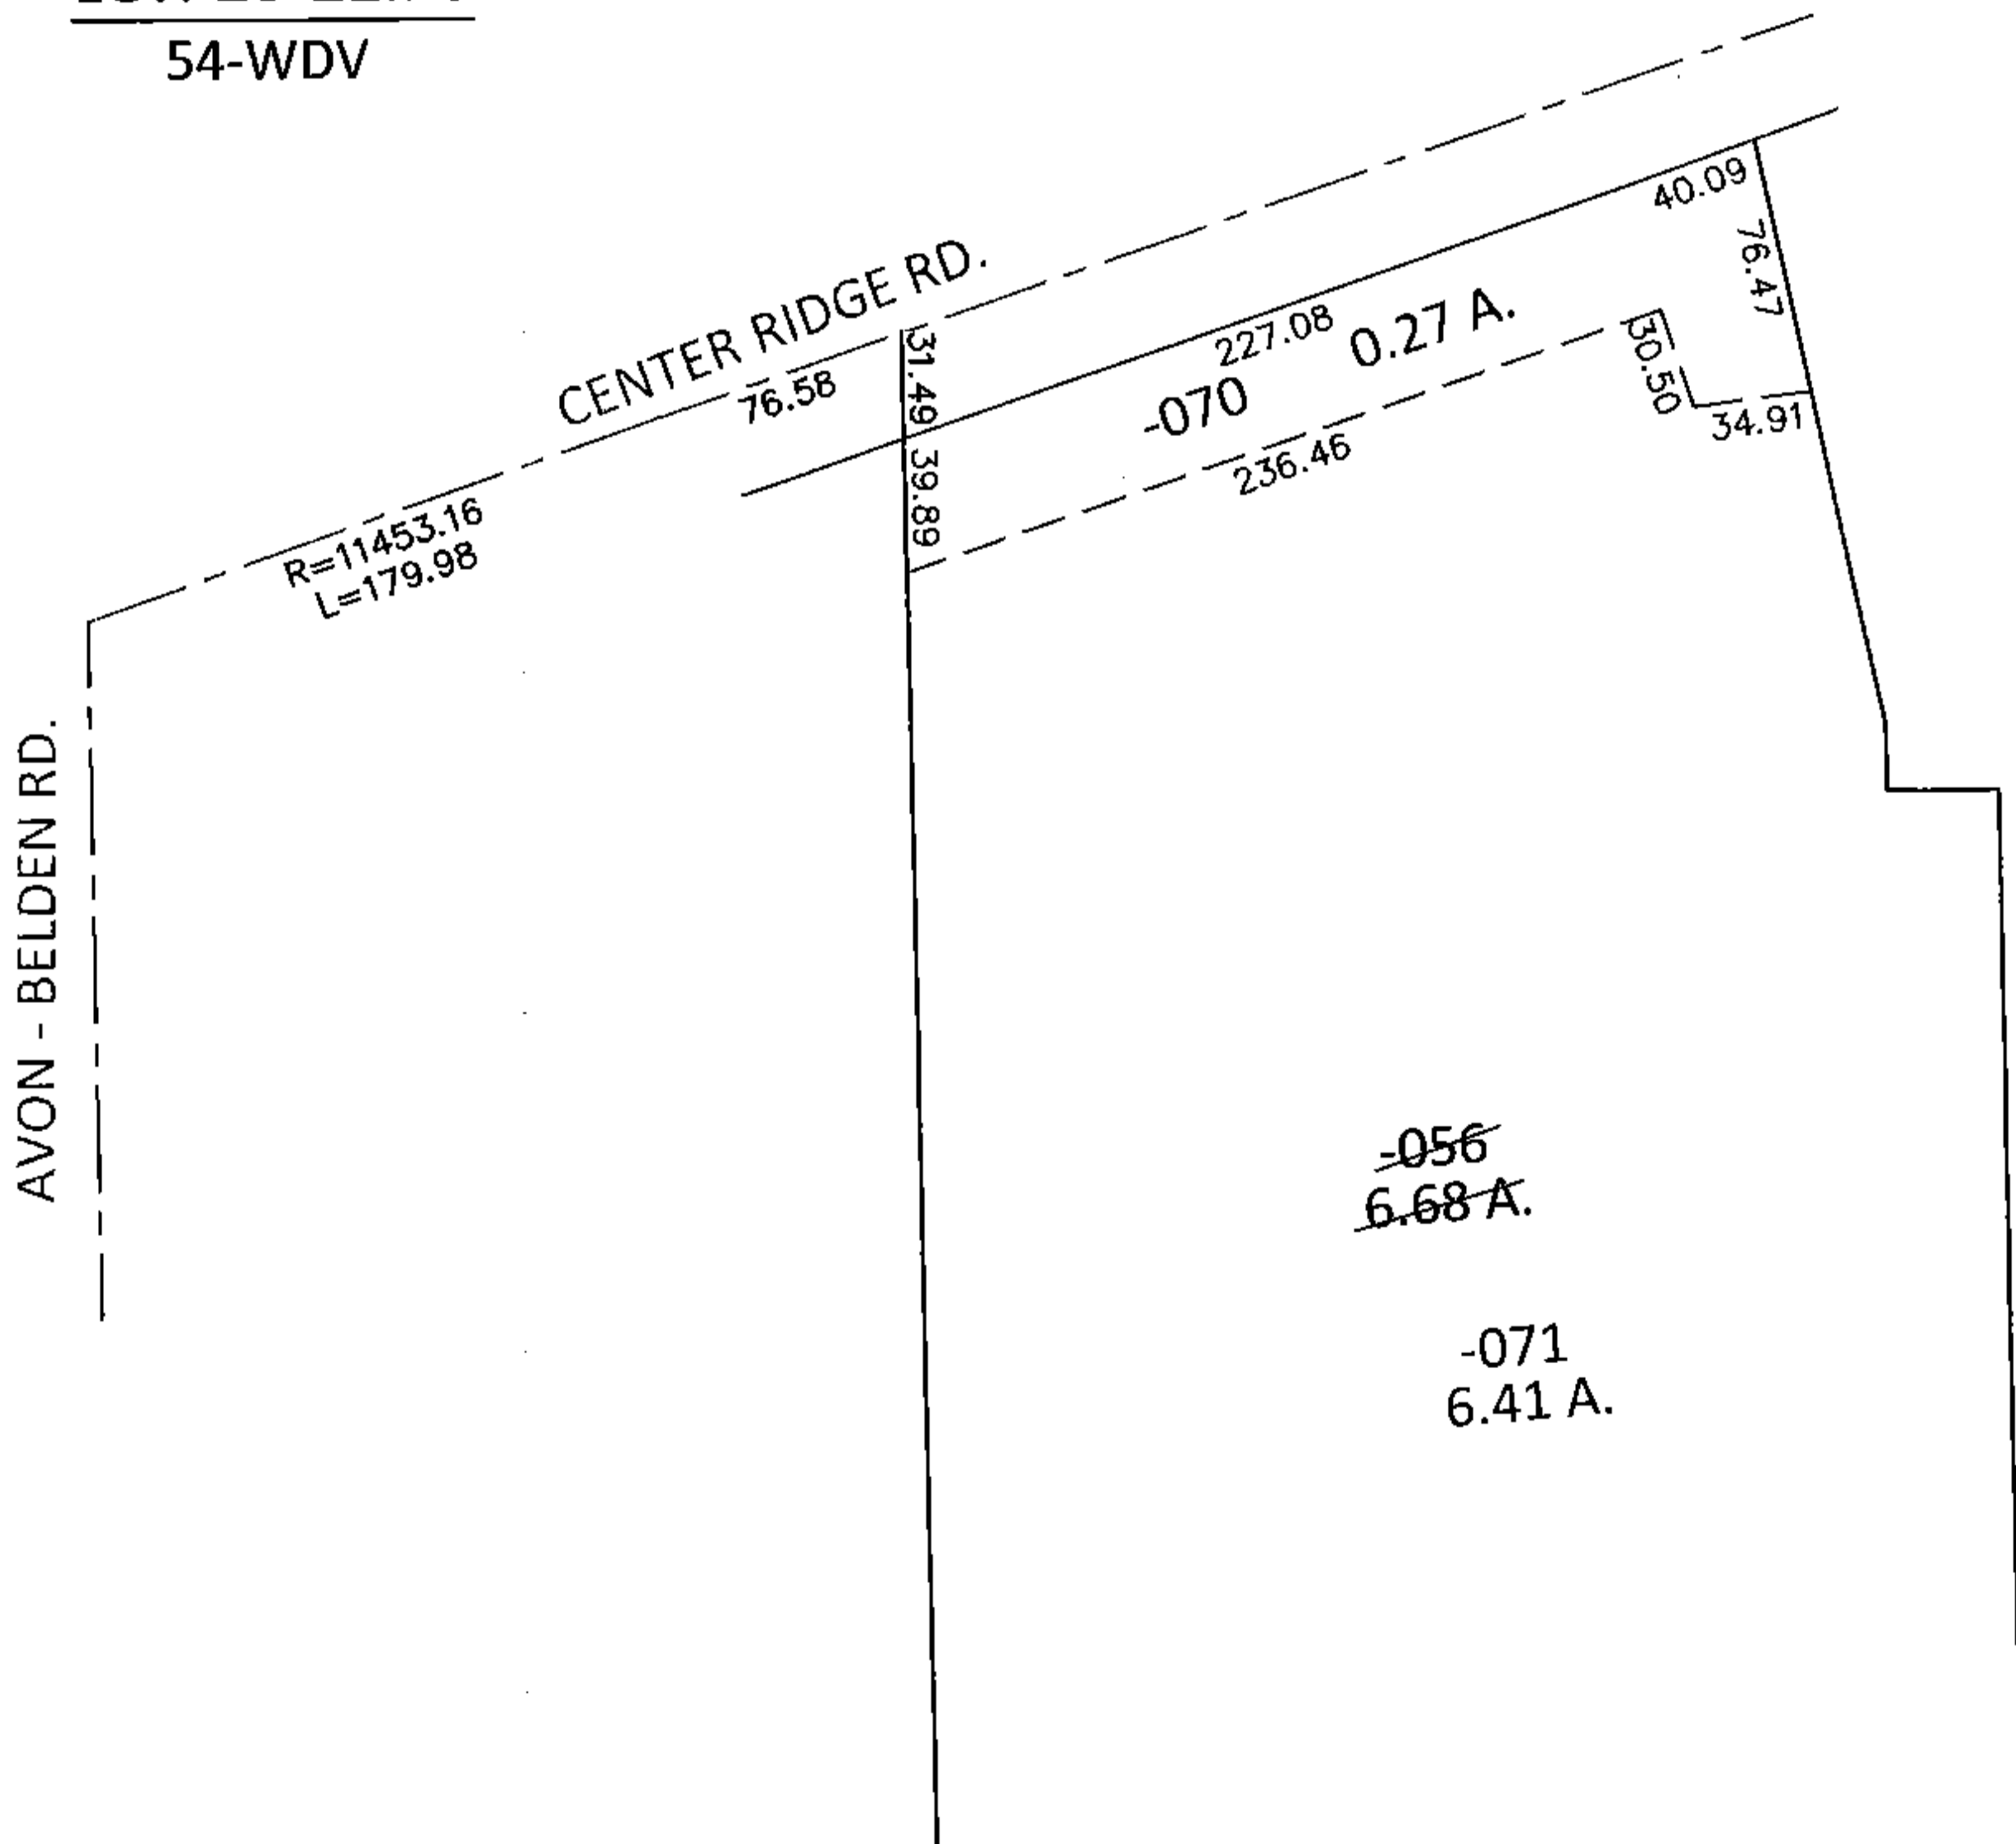

SPLITS/DEEDS PROCESSED

LORAIN COUNTY TAX MAP DEPARTMENT
226 MIDDLE AVE. ELYRIA, OHIO

SURVEYED BY: WILLIAM D. THOMAS

CLOSURE: .01:10,000

MAP PAGE(S): 7-00-021-C

APPROVED BY: RRM DATE: 8-29-14

SCALE: 1"= 100 PRIOR INST.: DV 196/414