


PARENT PARCEL: 07-00-021-117-042



CHILD PARCEL: 07-00-021-117-077, -078

STARTING POINT: INTERSECTION OF C/L OF CENTER RIDGE RD. AND C/L OF AVON - BELDEN RD.

14-00534

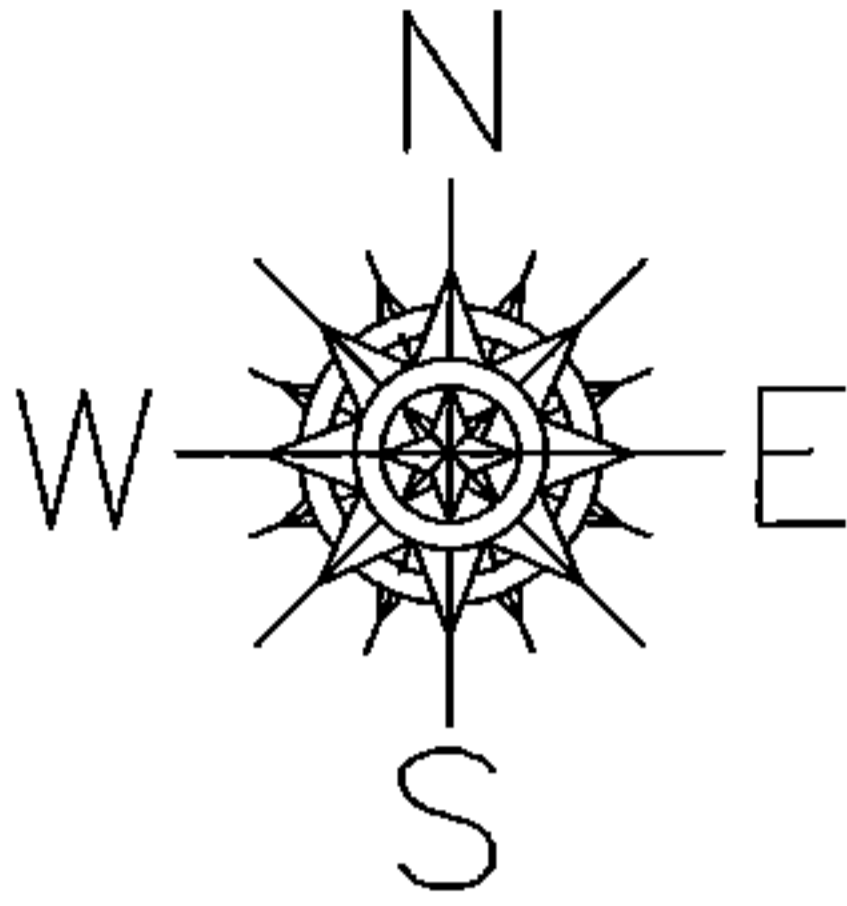

LOR-20-22.13
57-WDV

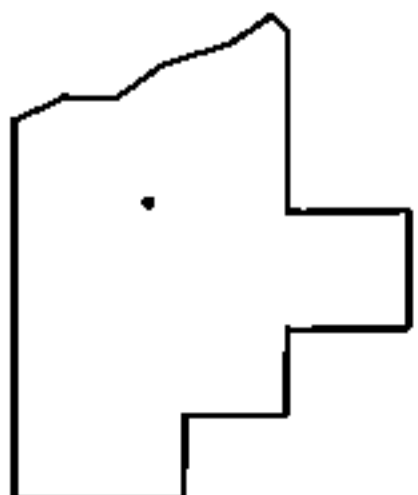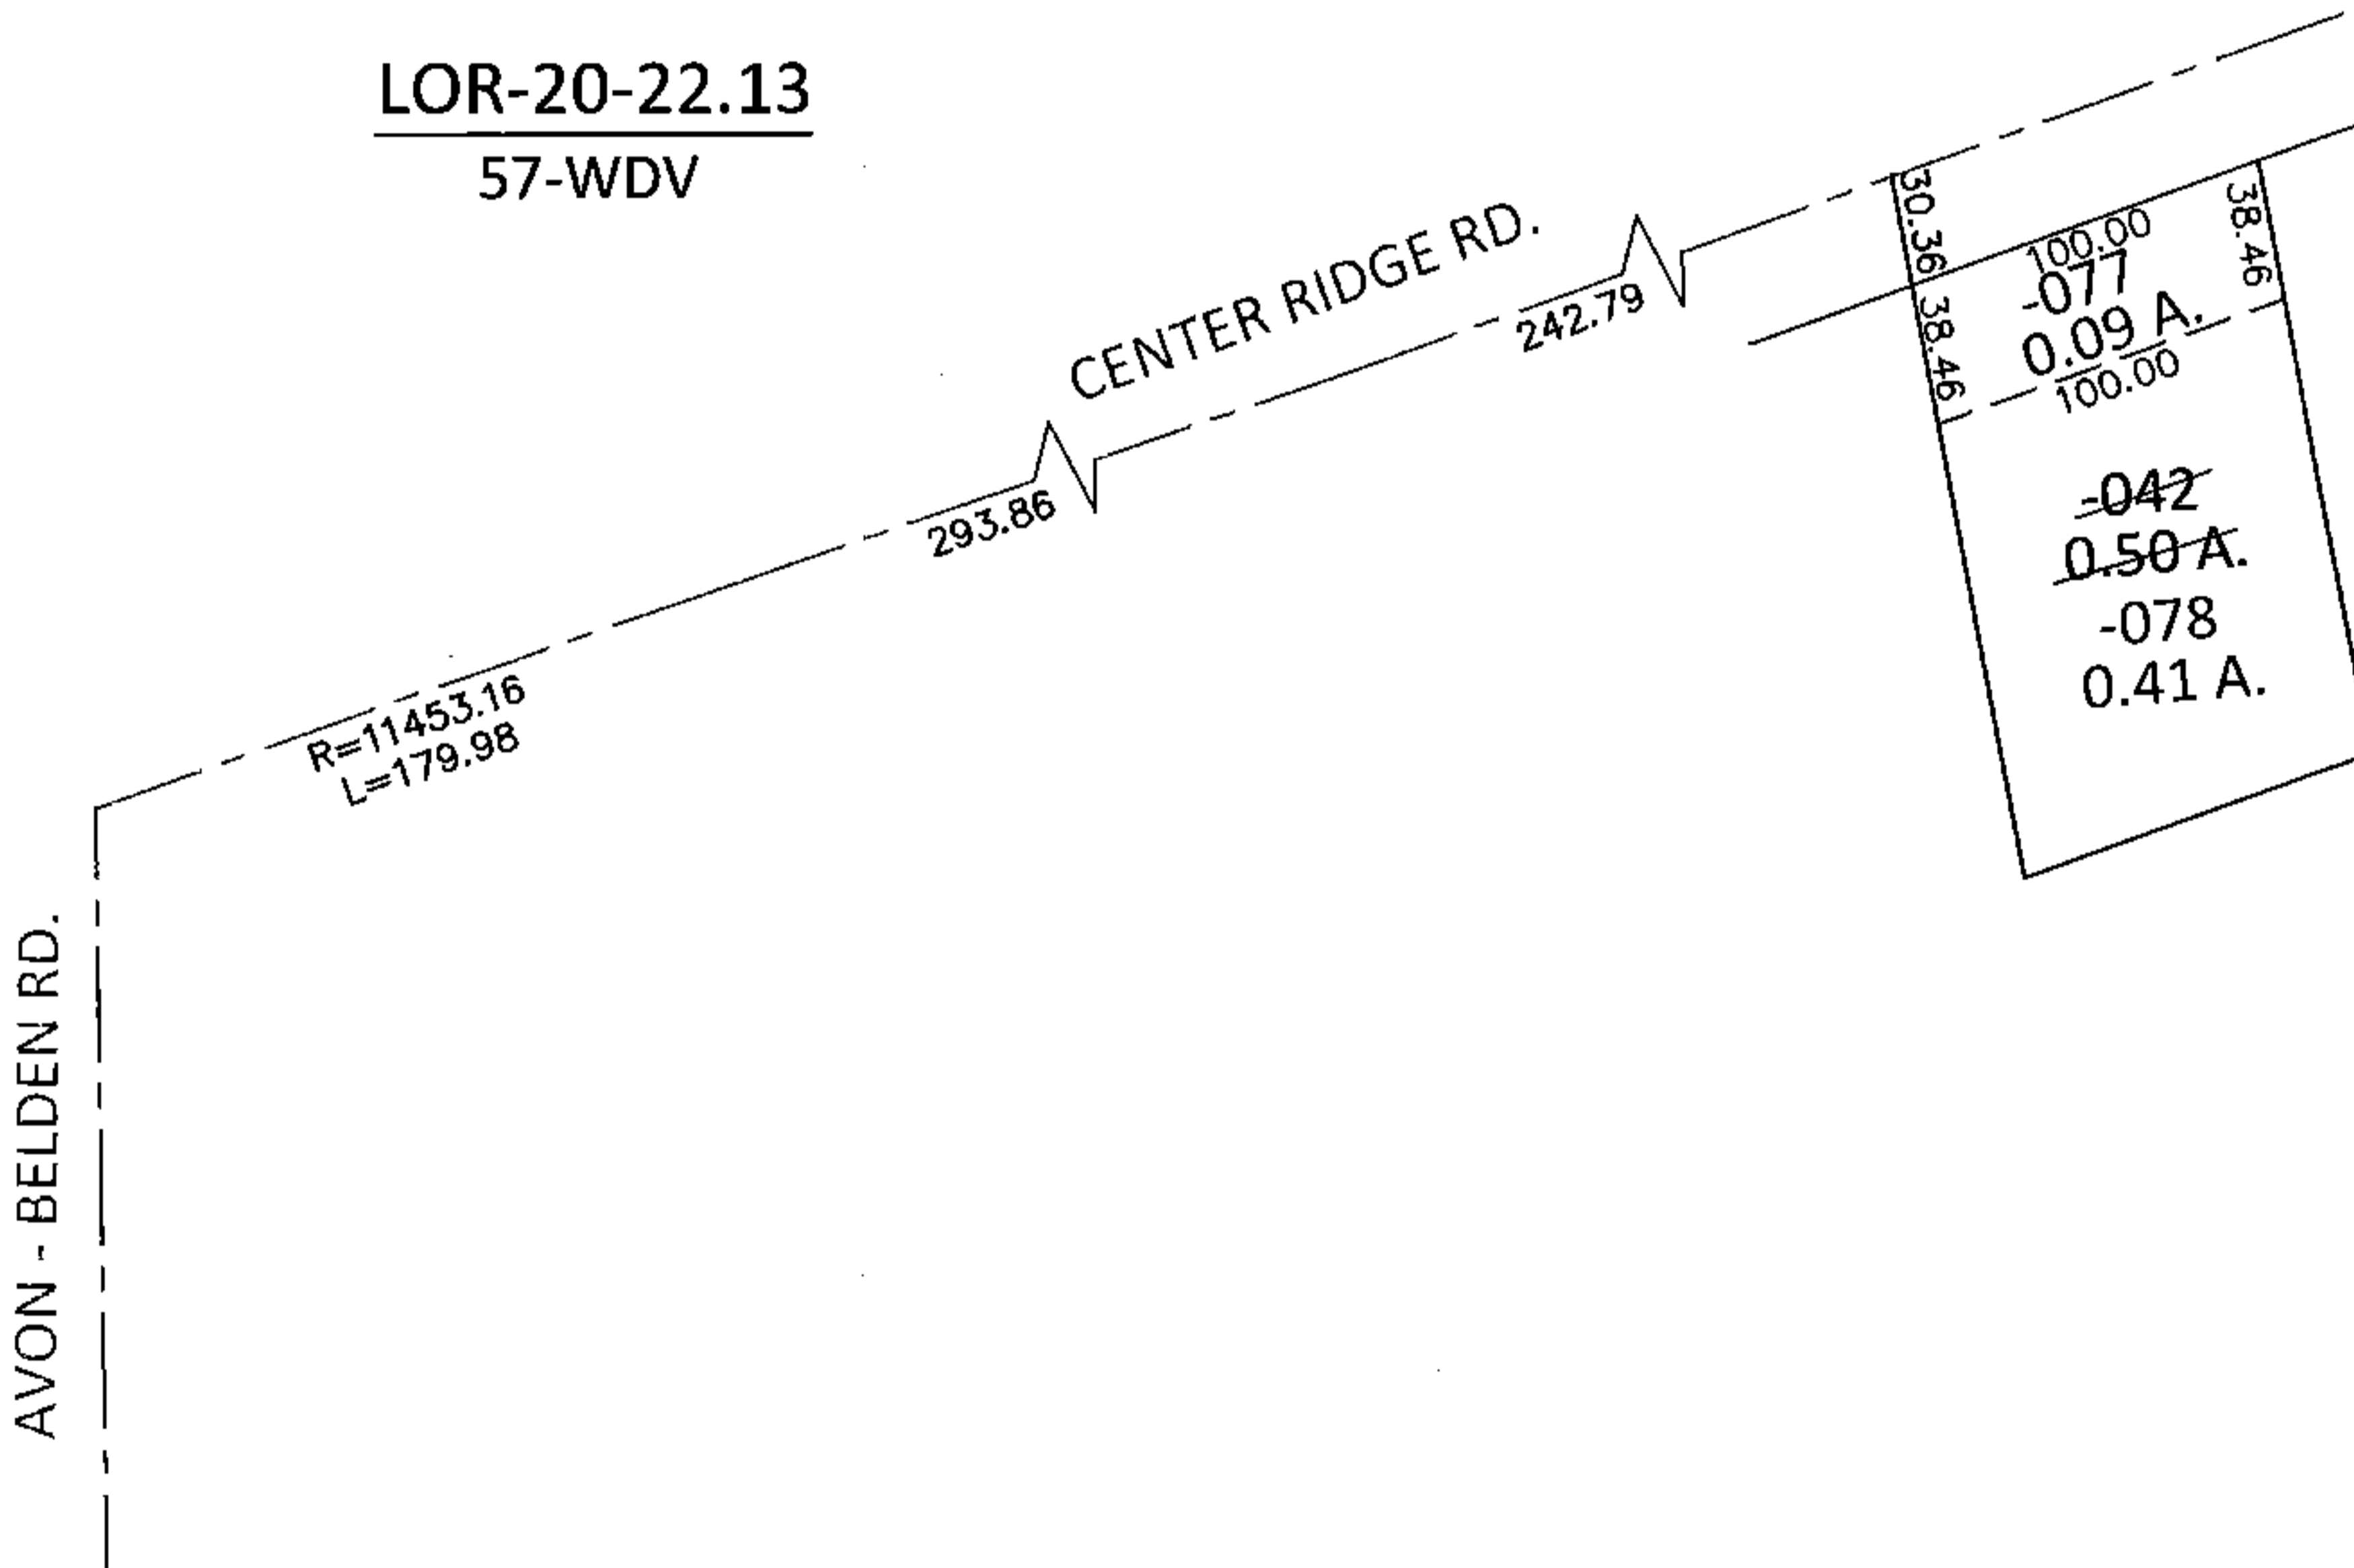

SPLITS/DEEDS PROCESSED

LORAIN COUNTY TAX MAP DEPARTMENT
226 MIDDLE AVE. ELYRIA, OHIO

SURVEYED BY: WILLIAM D. THOMAS

CLOSURE: .01:10,000

MAP PAGE(S): 7-00-021-C

APPROVED BY: RRM DATE: 9-2-14

SCALE: 1"= 100 PRIOR INST.: DV 244/391