


PARENT PARCEL: 07-00-021-101-034

CHILD PARCEL: 07-00-021-101-067, -068

STARTING POINT: INTERSECTION OF C/L OF AVON - BELDEN RD. AND C/L OF CENTER RIDGE RD.

14-00545

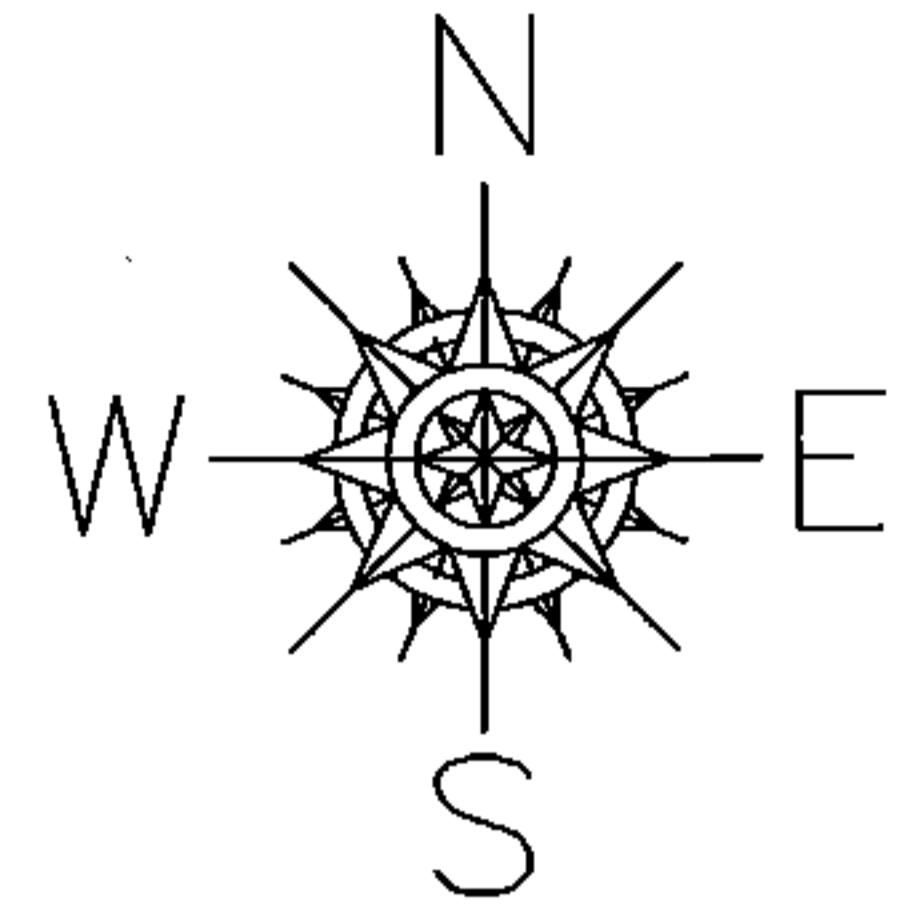

~~-034~~ -068
~~3.71 A.~~ 3.68 A.


42.64
33.87
32.62
37.88
-067
0.03 A.

499.54
CENTER RIDGE RD.

RIDGE PLAZA DR.

97.11

LOR-20-22.13
69-WDV

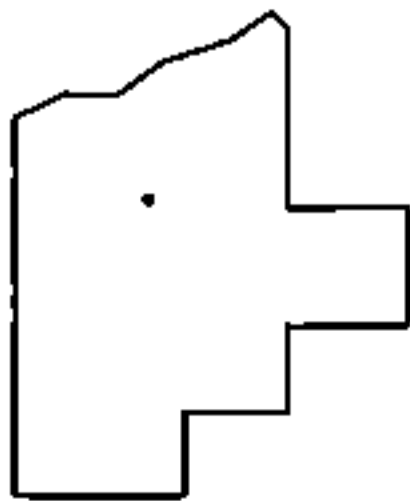

SPLITS/DEEDS PROCESSED

LORAIN COUNTY TAX MAP DEPARTMENT
226 MIDDLE AVE. ELYRIA, OHIO

SURVEYED BY: WILLIAM D. THOMAS
CLOSURE: .01:10,000
MAP PAGE(S): 7-00-021-C
APPROVED BY: RRM DATE: 9-3-14
SCALE: 1"= 100 PRIOR INST.: 20090302442