


PARENT PARCEL: 07-00-021-113-004

CHILD PARCEL: 07-00-021-113-015, -016



STARTING POINT: INTERSECTION OF C/L OF CENTER RIDGE RD. AND C/L OF ROOT RD.

14-00556

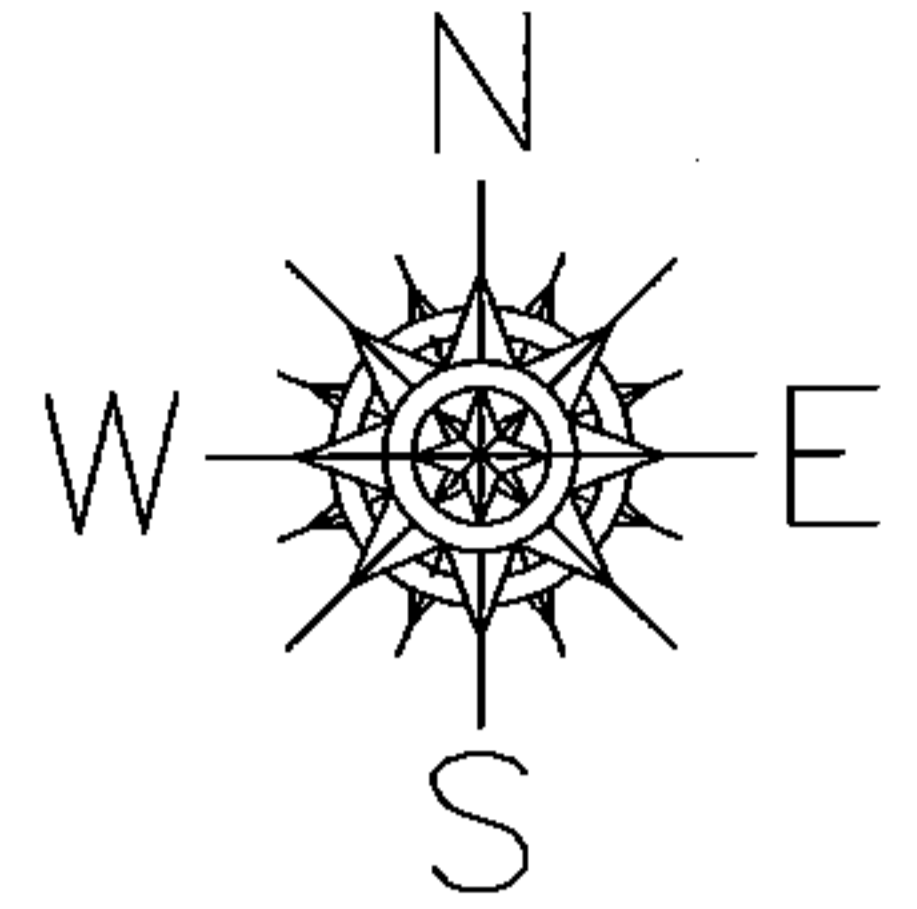

LOR-20-22.13

80-WDV

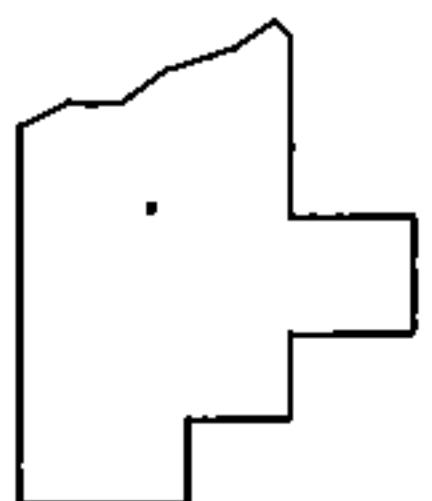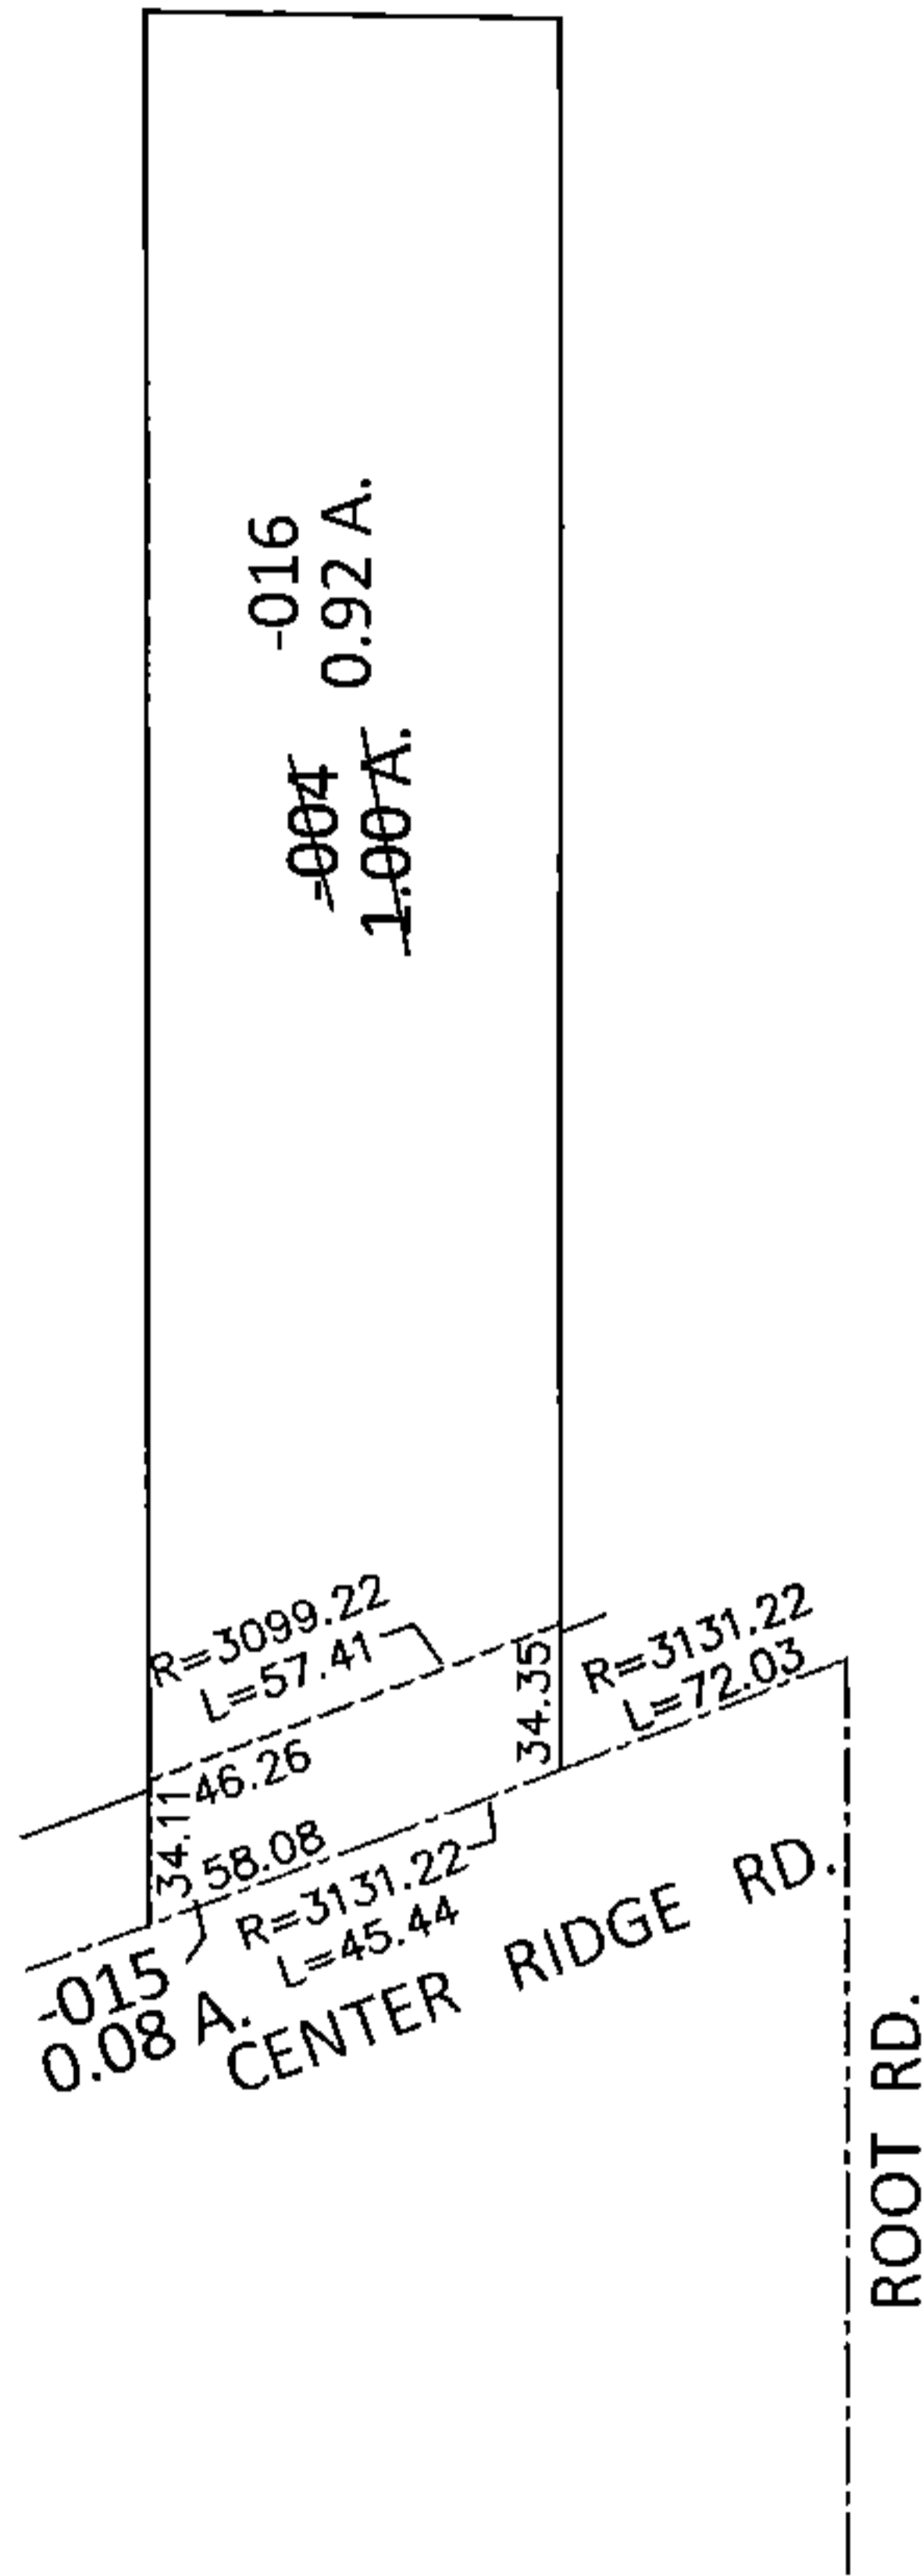

SPLITS/DEEDS PROCESSED

LORAIN COUNTY TAX MAP DEPARTMENT
226 MIDDLE AVE. ELYRIA, OHIO

SURVEYED BY: WILLIAM D. THOMAS

CLOSURE: .01:10,000

MAP PAGE(S): 7-00-021-A

APPROVED BY: RRM DATE: 9-5-14

SCALE: 1"= 100 PRIOR INST.: 20060134343