

PARENT PARCEL: 07-00-021-117-052


CHILD PARCEL: 07-00-021-117-089, -090

STARTING POINT: INTERSECTION OF C/L OF CENTER RIDGE RD. AND C/L OF RIDGE PLAZA DR.

14-00565

RIDGE PLAZA DR.

CENTER RIDGE RD.

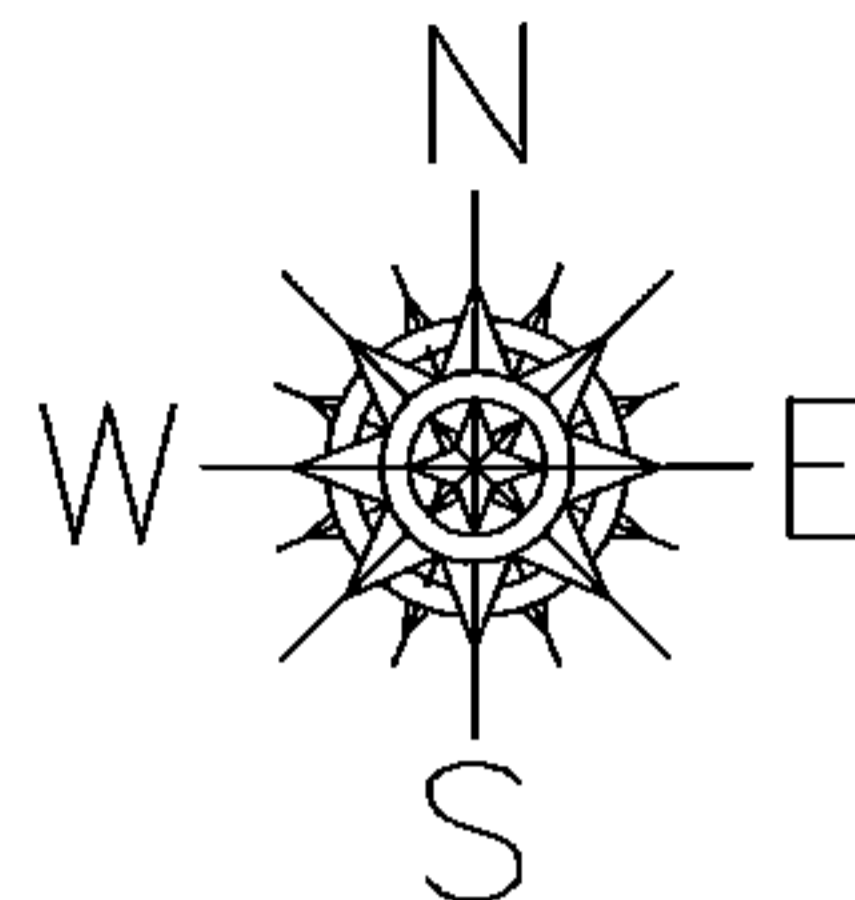

129.92

109.24

100.55

72.08

~~-089~~  
0.15 A.


70.17

93.98

LOR-20-22.13

96-WDV

~~-052~~  
~~0.78 A.~~ 0.63 A.  
-090

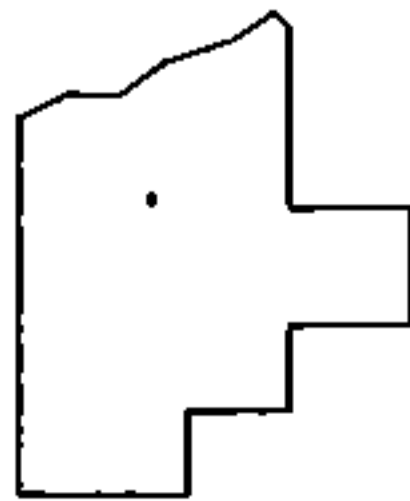

SPLITS/DEEDS PROCESSED

LORAIN COUNTY TAX MAP DEPARTMENT  
226 MIDDLE AVE. ELYRIA, OHIO

SURVEYED BY: WILLIAM D. THOMAS

CLOSURE: .01:10,000

MAP PAGE(S): 7-00-021-C

APPROVED BY: RRM DATE: 9-16-14

SCALE: 1"= 100 PRIOR INST.: 20060157862