

PARENT PARCEL: 07-00-021-118-033




CHILD PARCEL: 07-00-021-118-042, -043

STARTING POINT: INTERSECTION OF C/L OF CENTER RIDGE RD. AND C/L OF ROOT RD.

14-00567

LOR-20-22.13

98-WDV

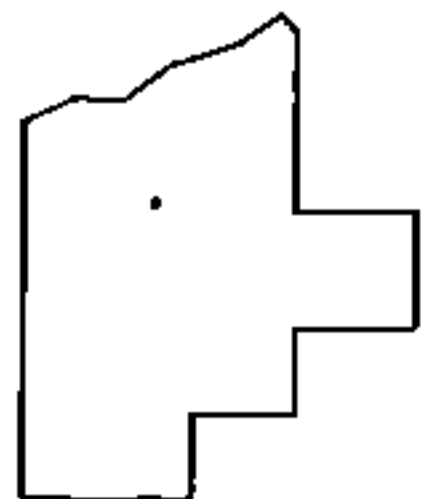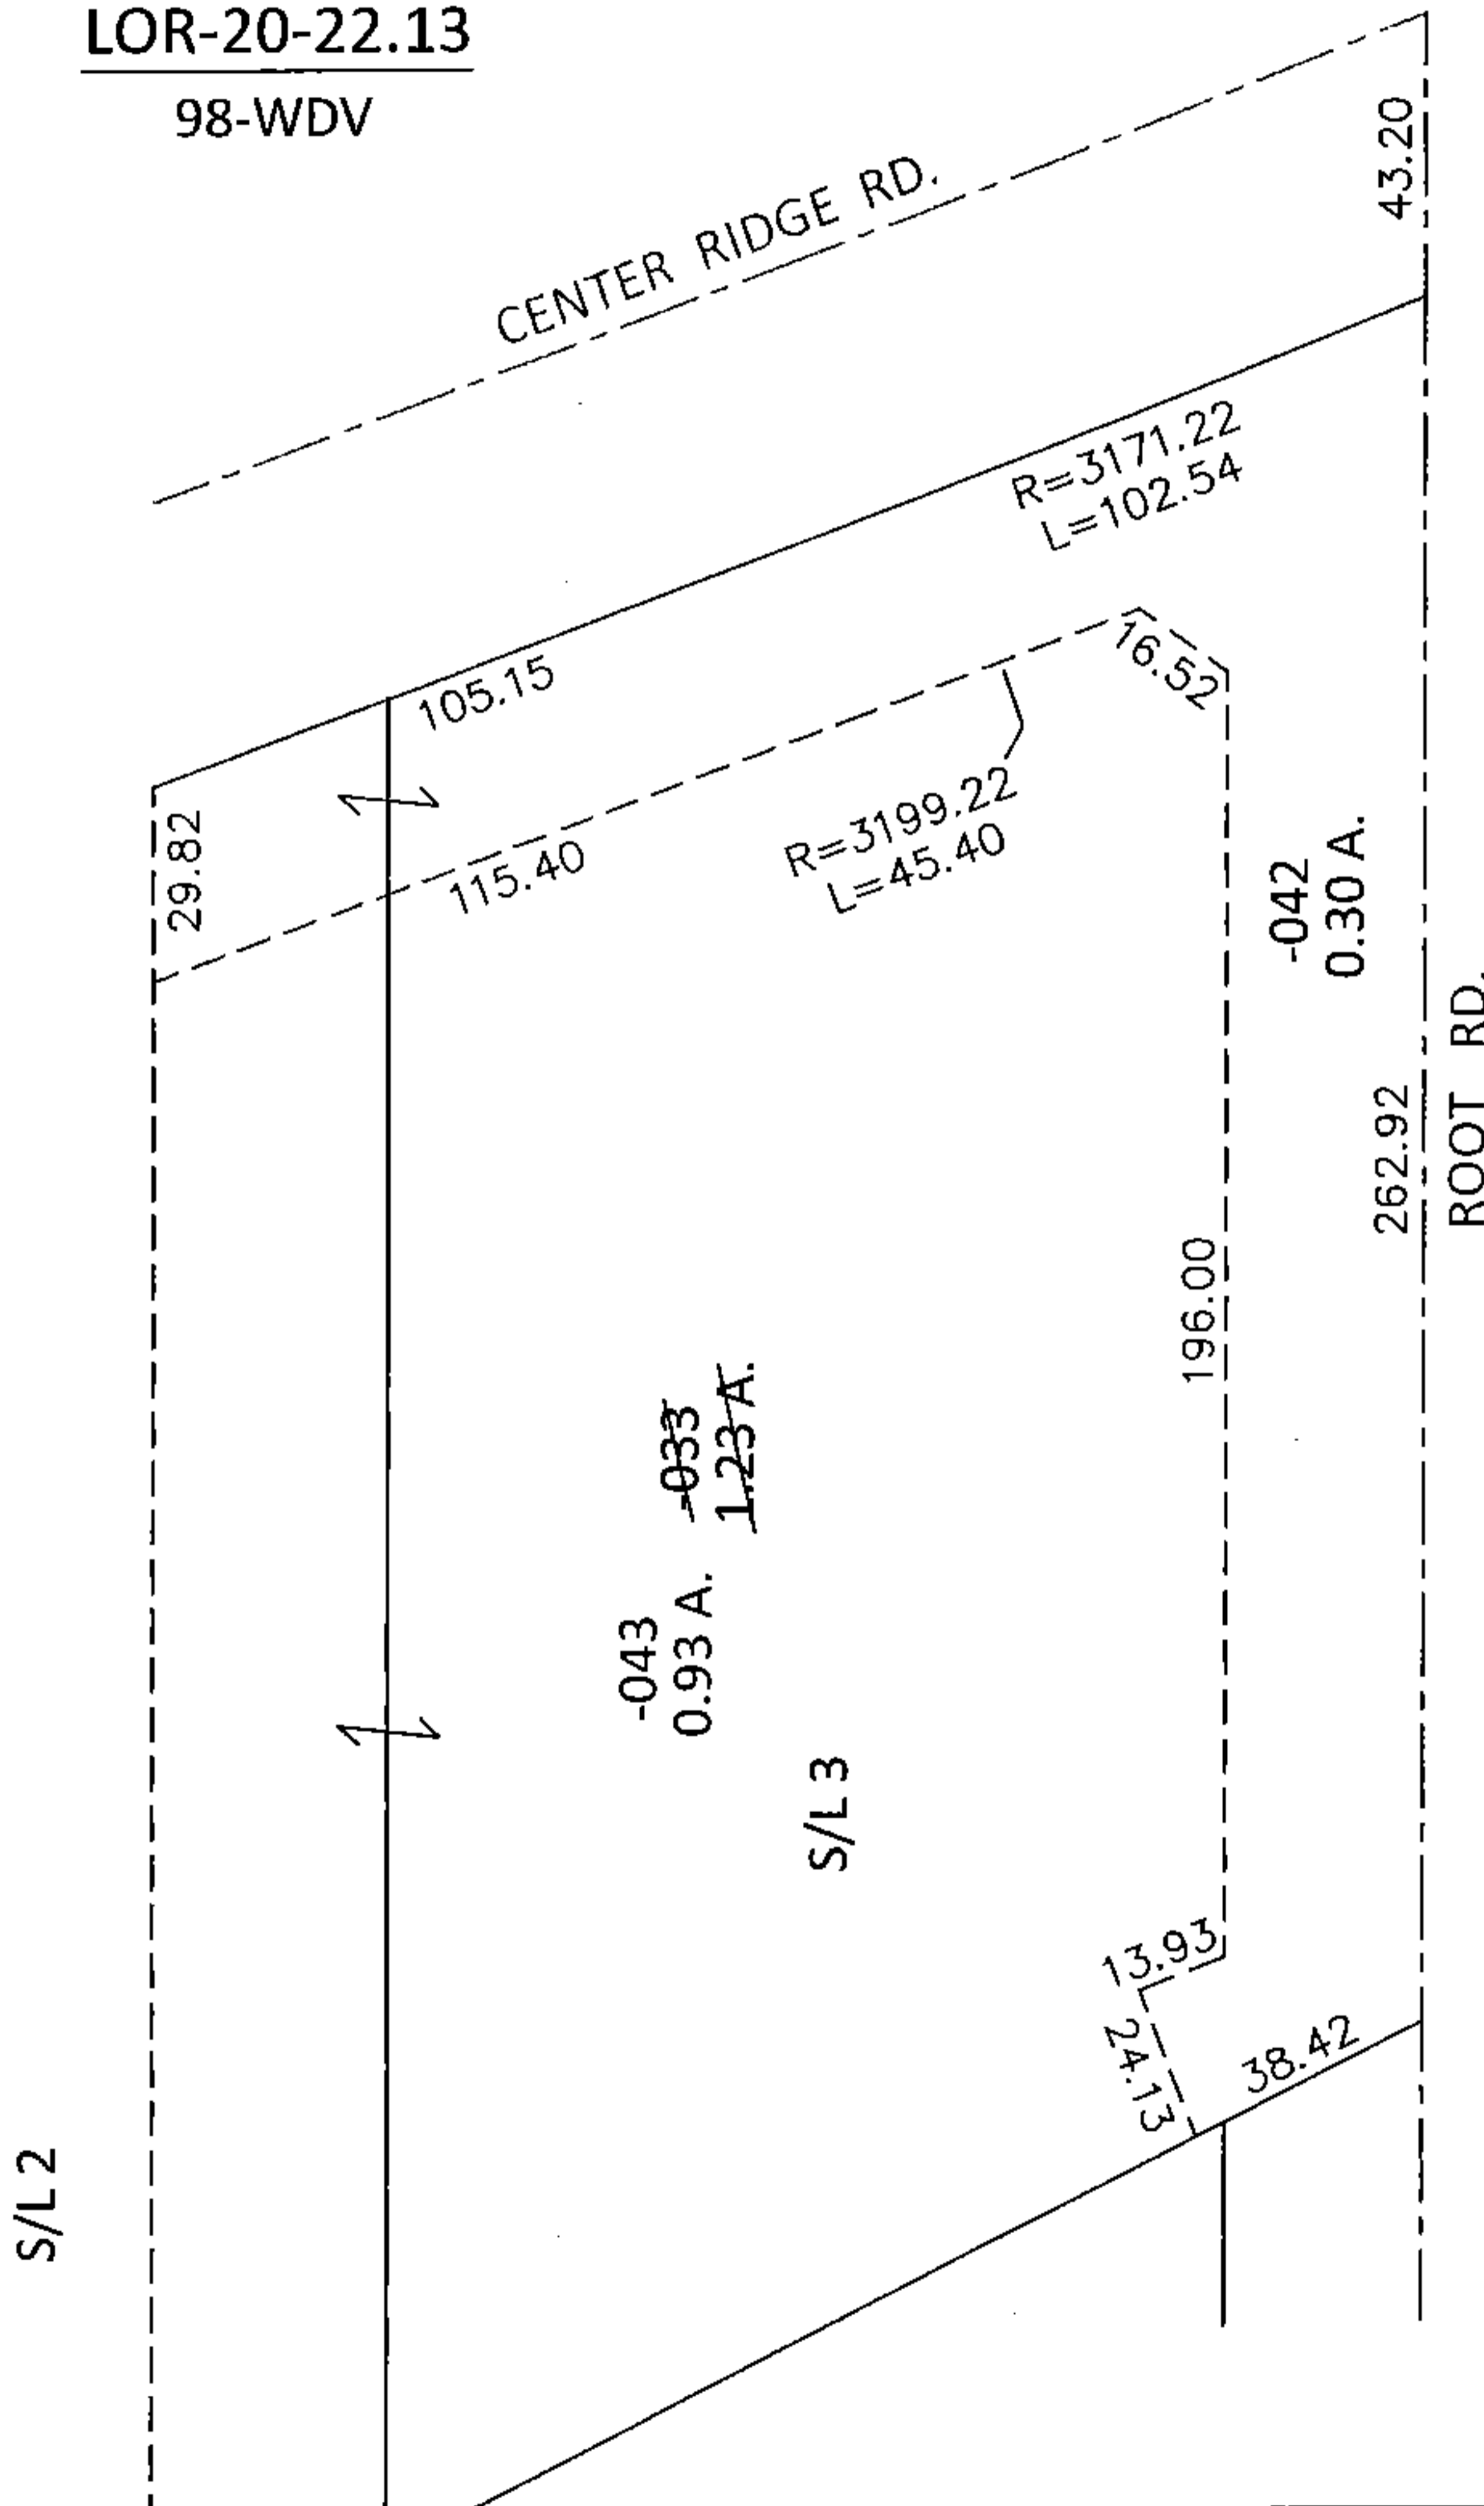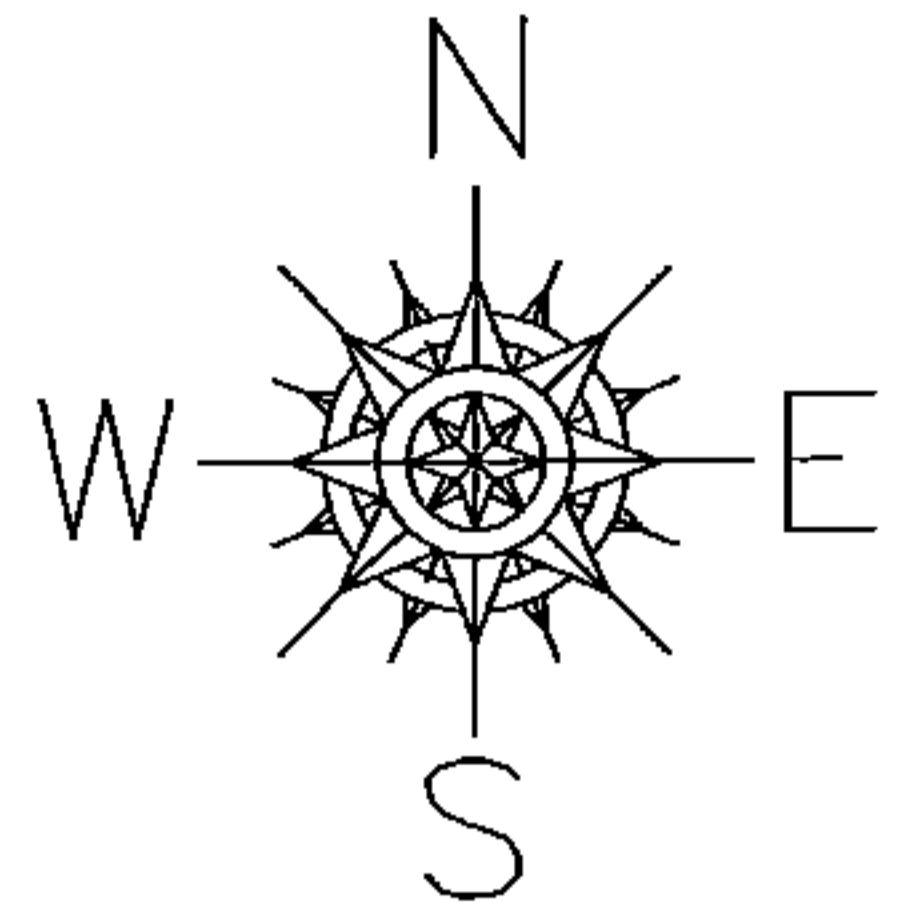

SPLITS/DEEDS PROCESSED

LORAIN COUNTY TAX MAP DEPARTMENT
226 MIDDLE AVE. ELYRIA, OHIO

SURVEYED BY: WILLIAM D. THOMAS

CLOSURE: .01:10,000

MAP PAGE(S): 7-00-021-D

APPROVED BY: RRM DATE: 9-16-14

SCALE: 1"=50' PRIOR INST.: DV 1012/287