

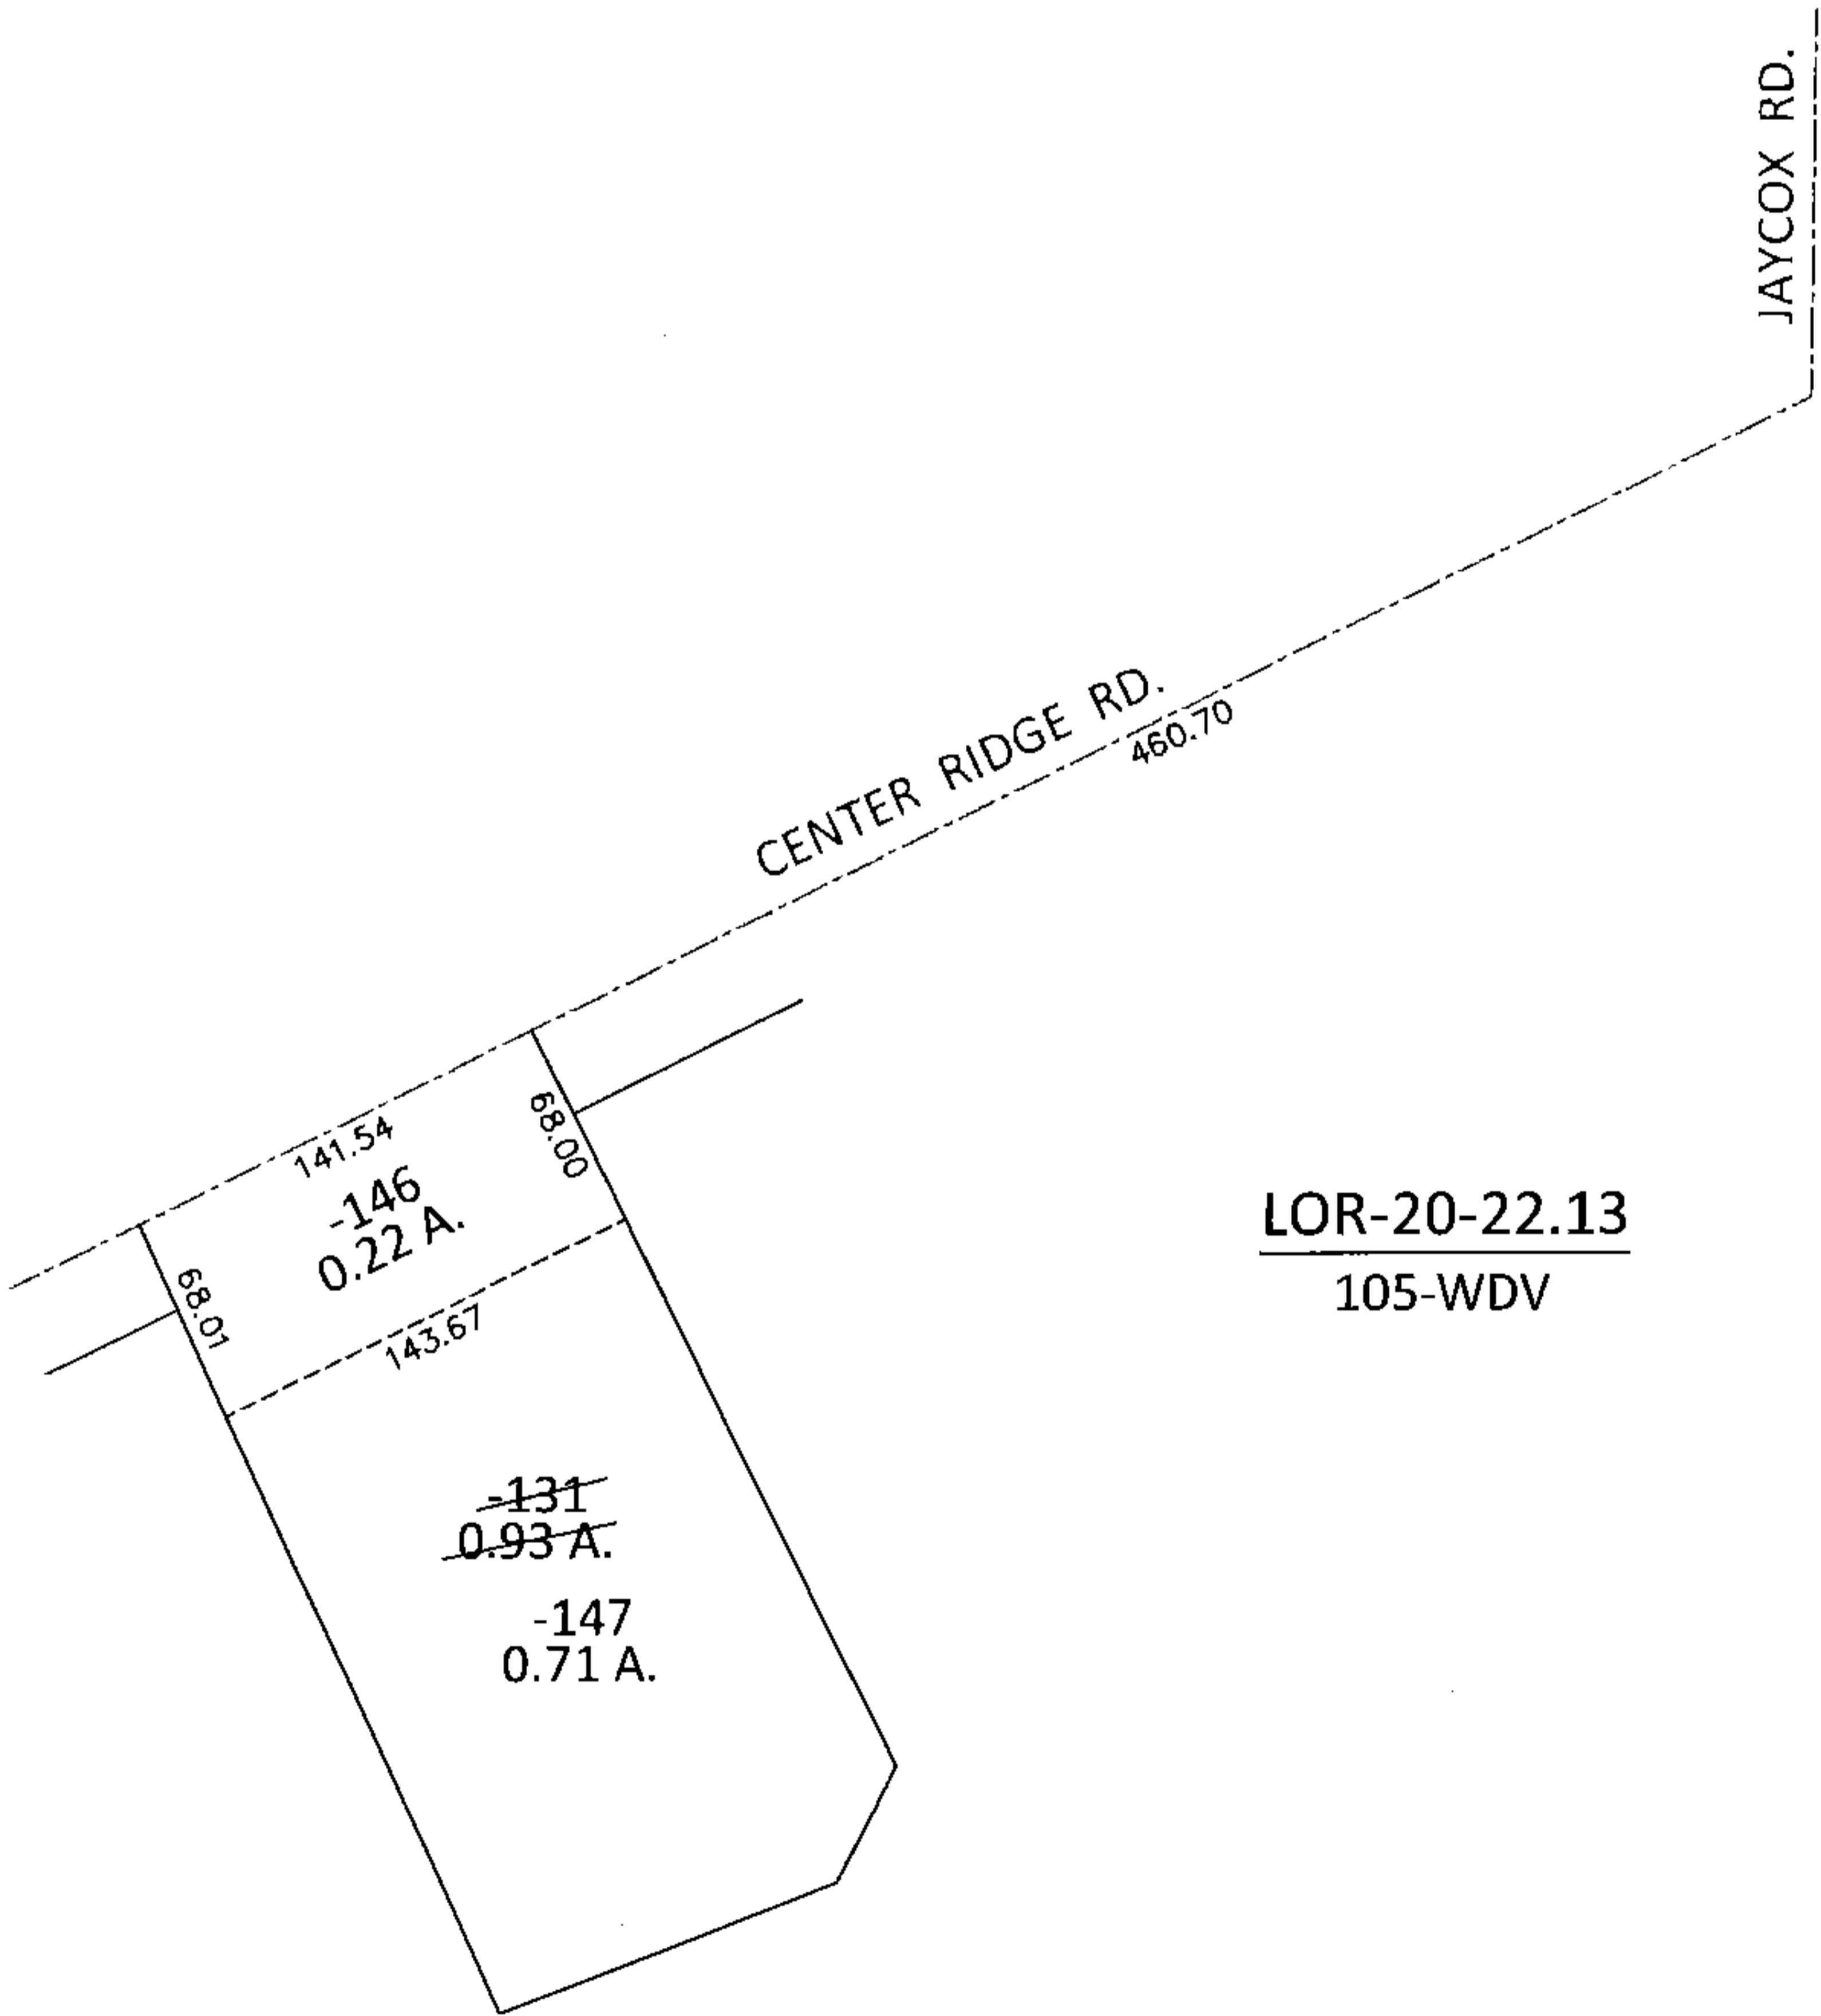


PARENT PARCEL: 07-00-021-119-131
CHILD PARCEL: 07-00-021-119-146, -147
STARTING POINT: INTERSECTION OF C/L OF CENTER RIDGE RD. AND C/L OF JAYCOX RD.

14-00574

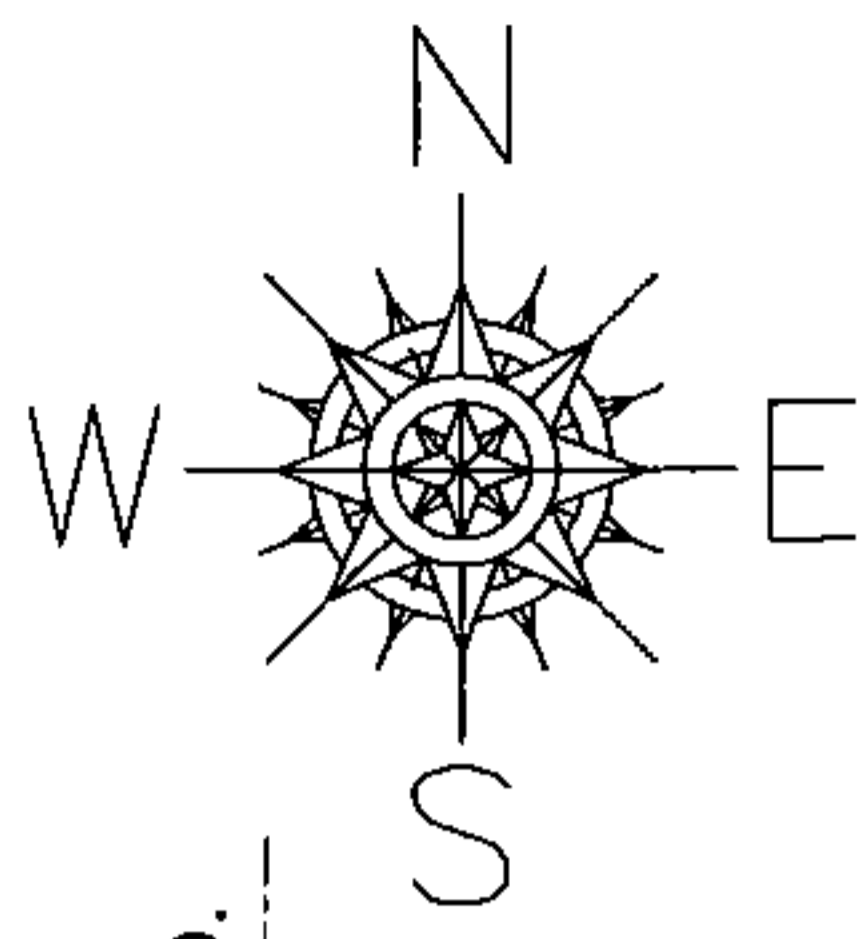

LOR-20-22.13
105-WDV

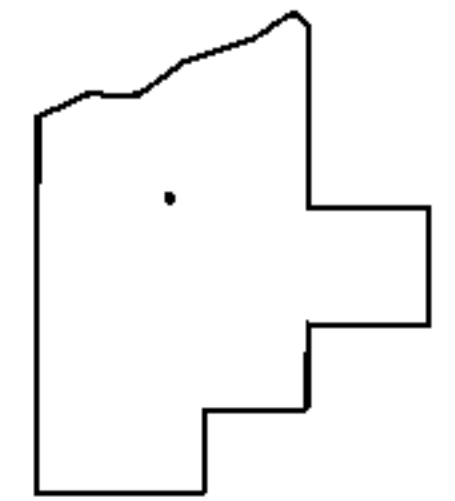

SPLITS/DEEDS PROCESSED
LORAIN COUNTY TAX MAP DEPARTMENT
226 MIDDLE AVE. ELYRIA, OHIO

SURVEYED BY: WILLIAM D. THOMAS
CLOSURE: .01:10,000
MAP PAGE(S): 7-00-021-B
APPROVED BY: RRM DATE: 9-18-14
SCALE: 1"= 100 PRIOR INST.: 20090300181