
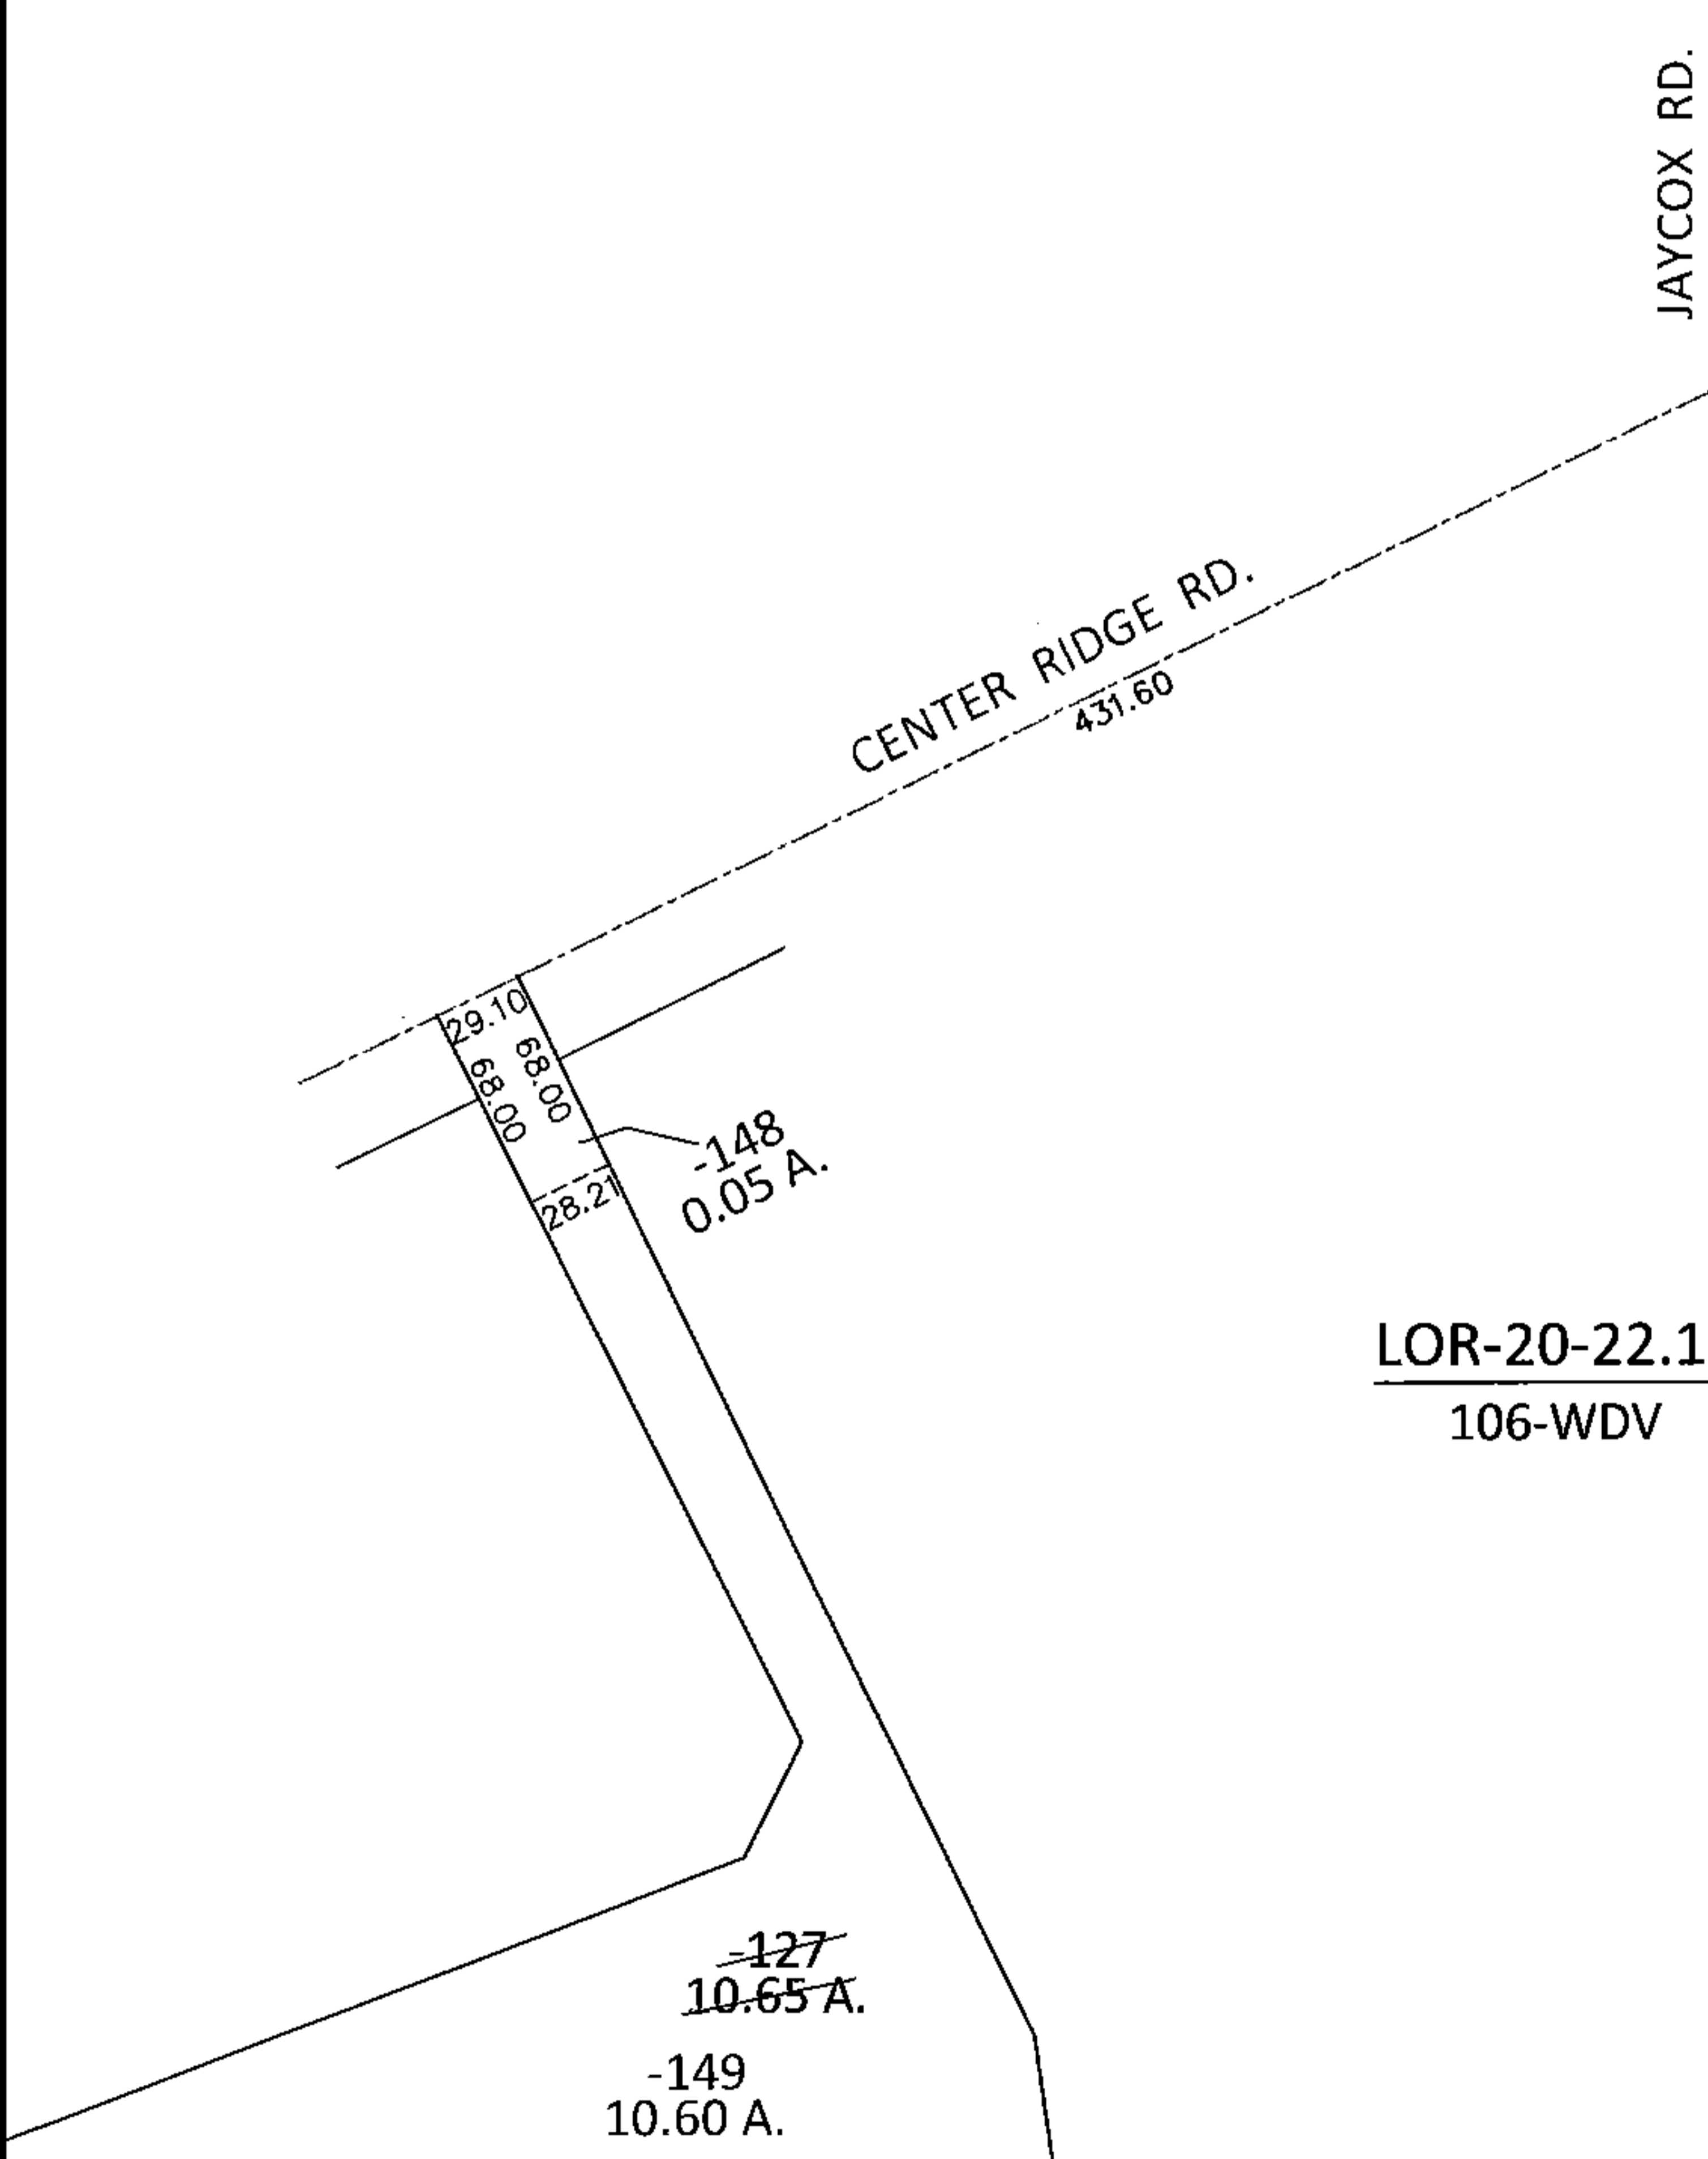


PARENT PARCEL: 07-00-021-119-127


CHILD PARCEL: 07-00-021-119-148, -149

STARTING POINT: INTERSECTION OF C/L OF CENTER RIDGE RD. AND C/L OF JAYCOX RD.

14-00575

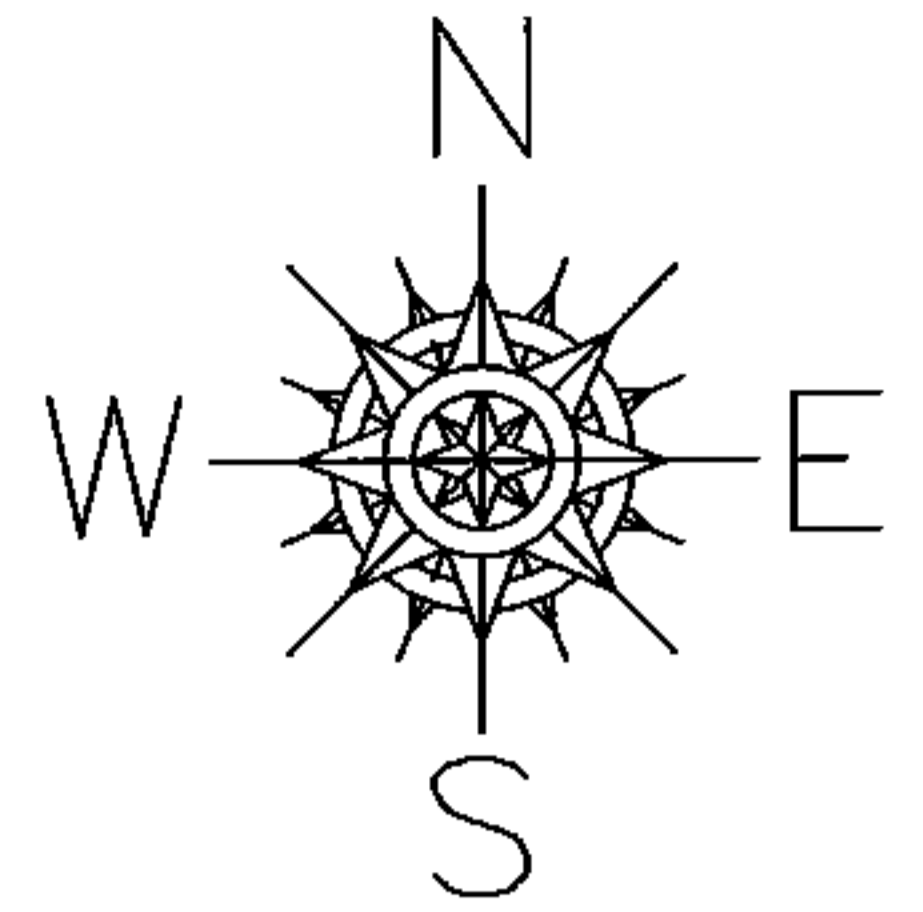

LOR-20-22.13
106-WDV

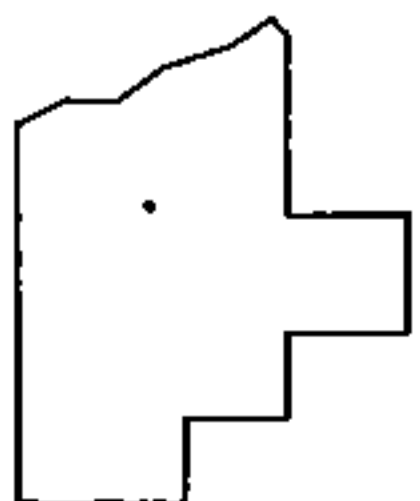

SPLITS/DEEDS PROCESSED

LORAIN COUNTY TAX MAP DEPARTMENT
226 MIDDLE AVE. ELYRIA, OHIO

SURVEYED BY: WILLIAM D. THOMAS

CLOSURE: .01:10,000

MAP PAGE(S): 7-00-021-B

APPROVED BY: RRM DATE: 9-18-14

SCALE: 1"=100 PRIOR INST.: 20090288912