


PARENT PARCEL: 07-00-016-104-003

CHILD PARCEL: 07-00-016-104-191, -192


STARTING POINT: INTERSECTION OF C/L OF CENTER RIDGE RD. AND C/L OF JAYCOX RD.

14-00578

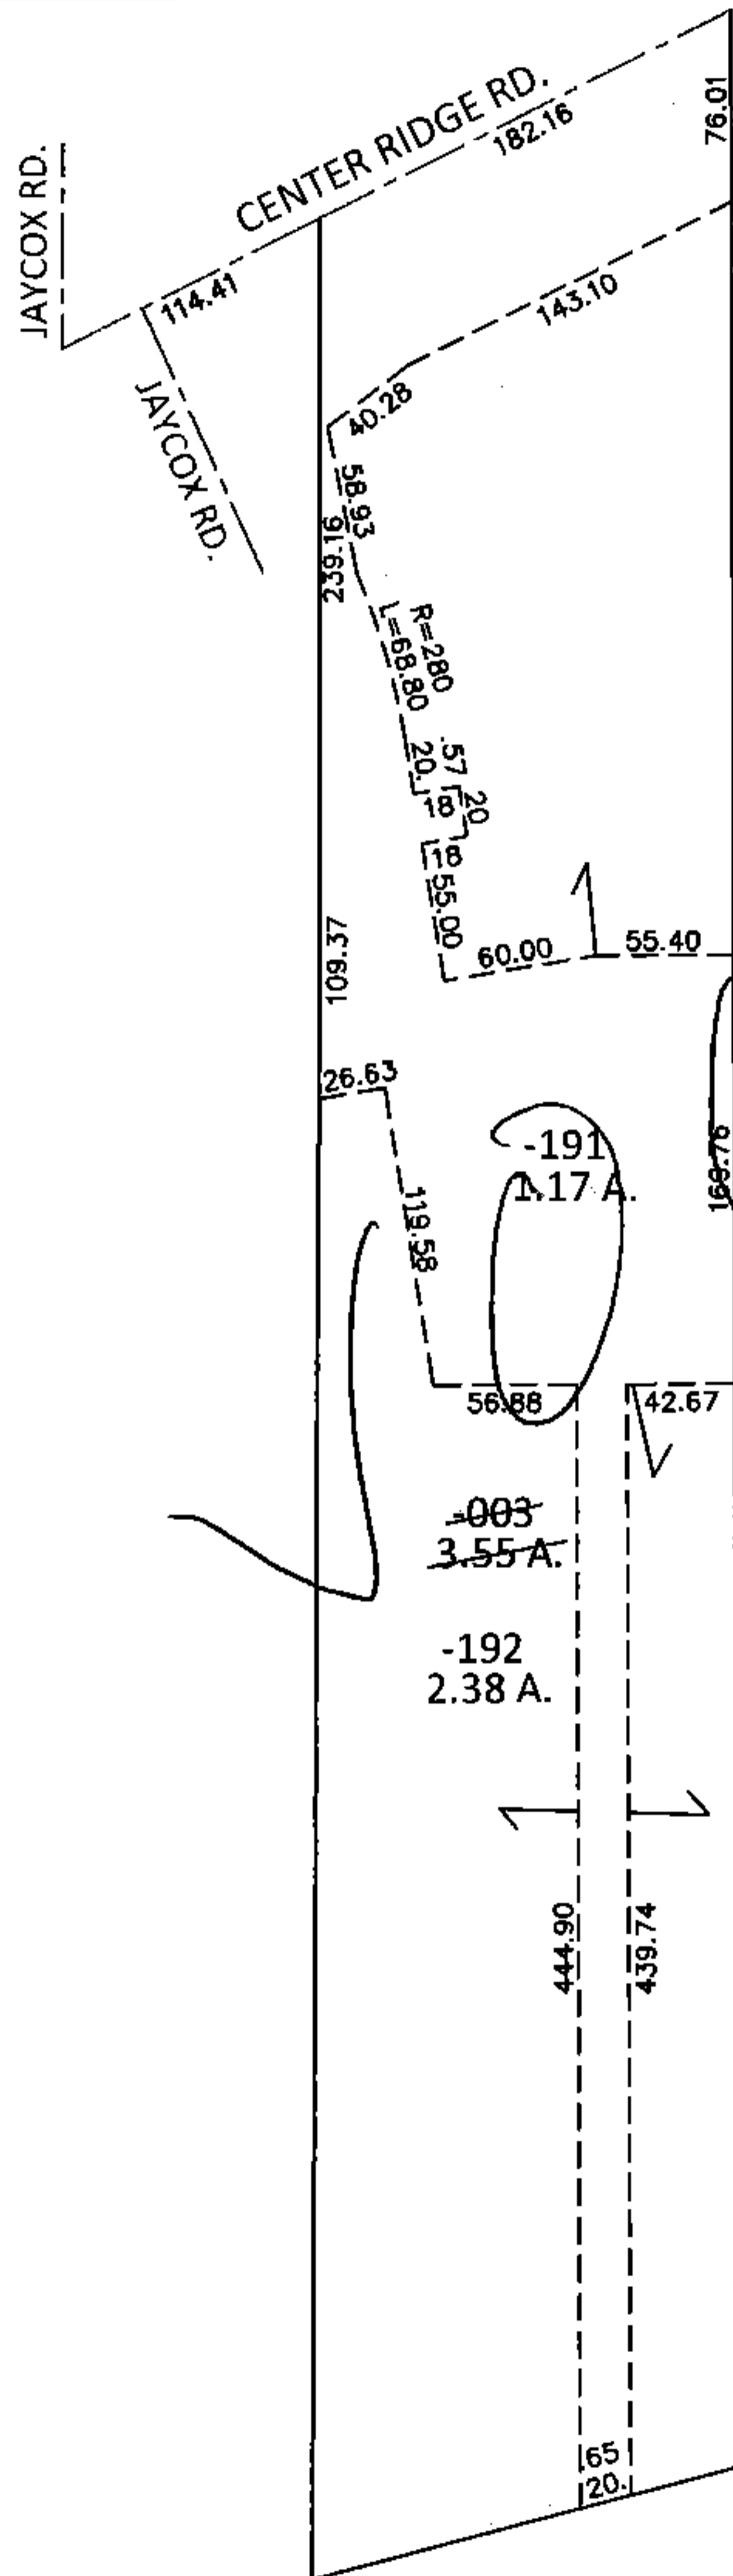

LOR-20-22.13

109-WDV

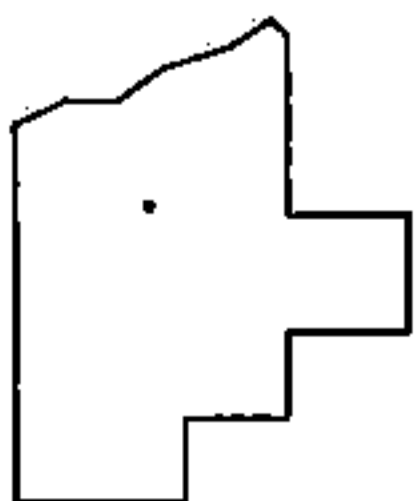

SPLITS/DEEDS PROCESSED

LORAIN COUNTY TAX MAP DEPARTMENT
226 MIDDLE AVE. ELYRIA, OHIO

SURVEYED BY: WILLIAM D. THOMAS

CLOSURE: .01:10,000

MAP PAGE(S): 7-00-016-A

APPROVED BY: RRM DATE: 2-17-15

SCALE: 1"= 125 PRIOR INST.: 20130470091