
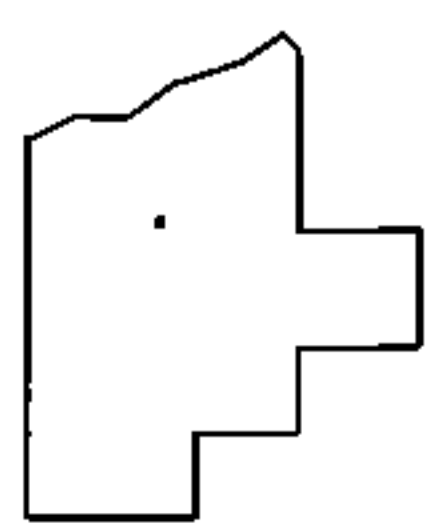


PARENT PARCEL: 07-00-016-104-142  
CHILD PARCEL: 07-00-016-104-195, -196  
STARTING POINT: INTERSECTION OF C/L OF CENTER RIDGE RD. AND C/L OF JAYCOX RD.

**14-00579**

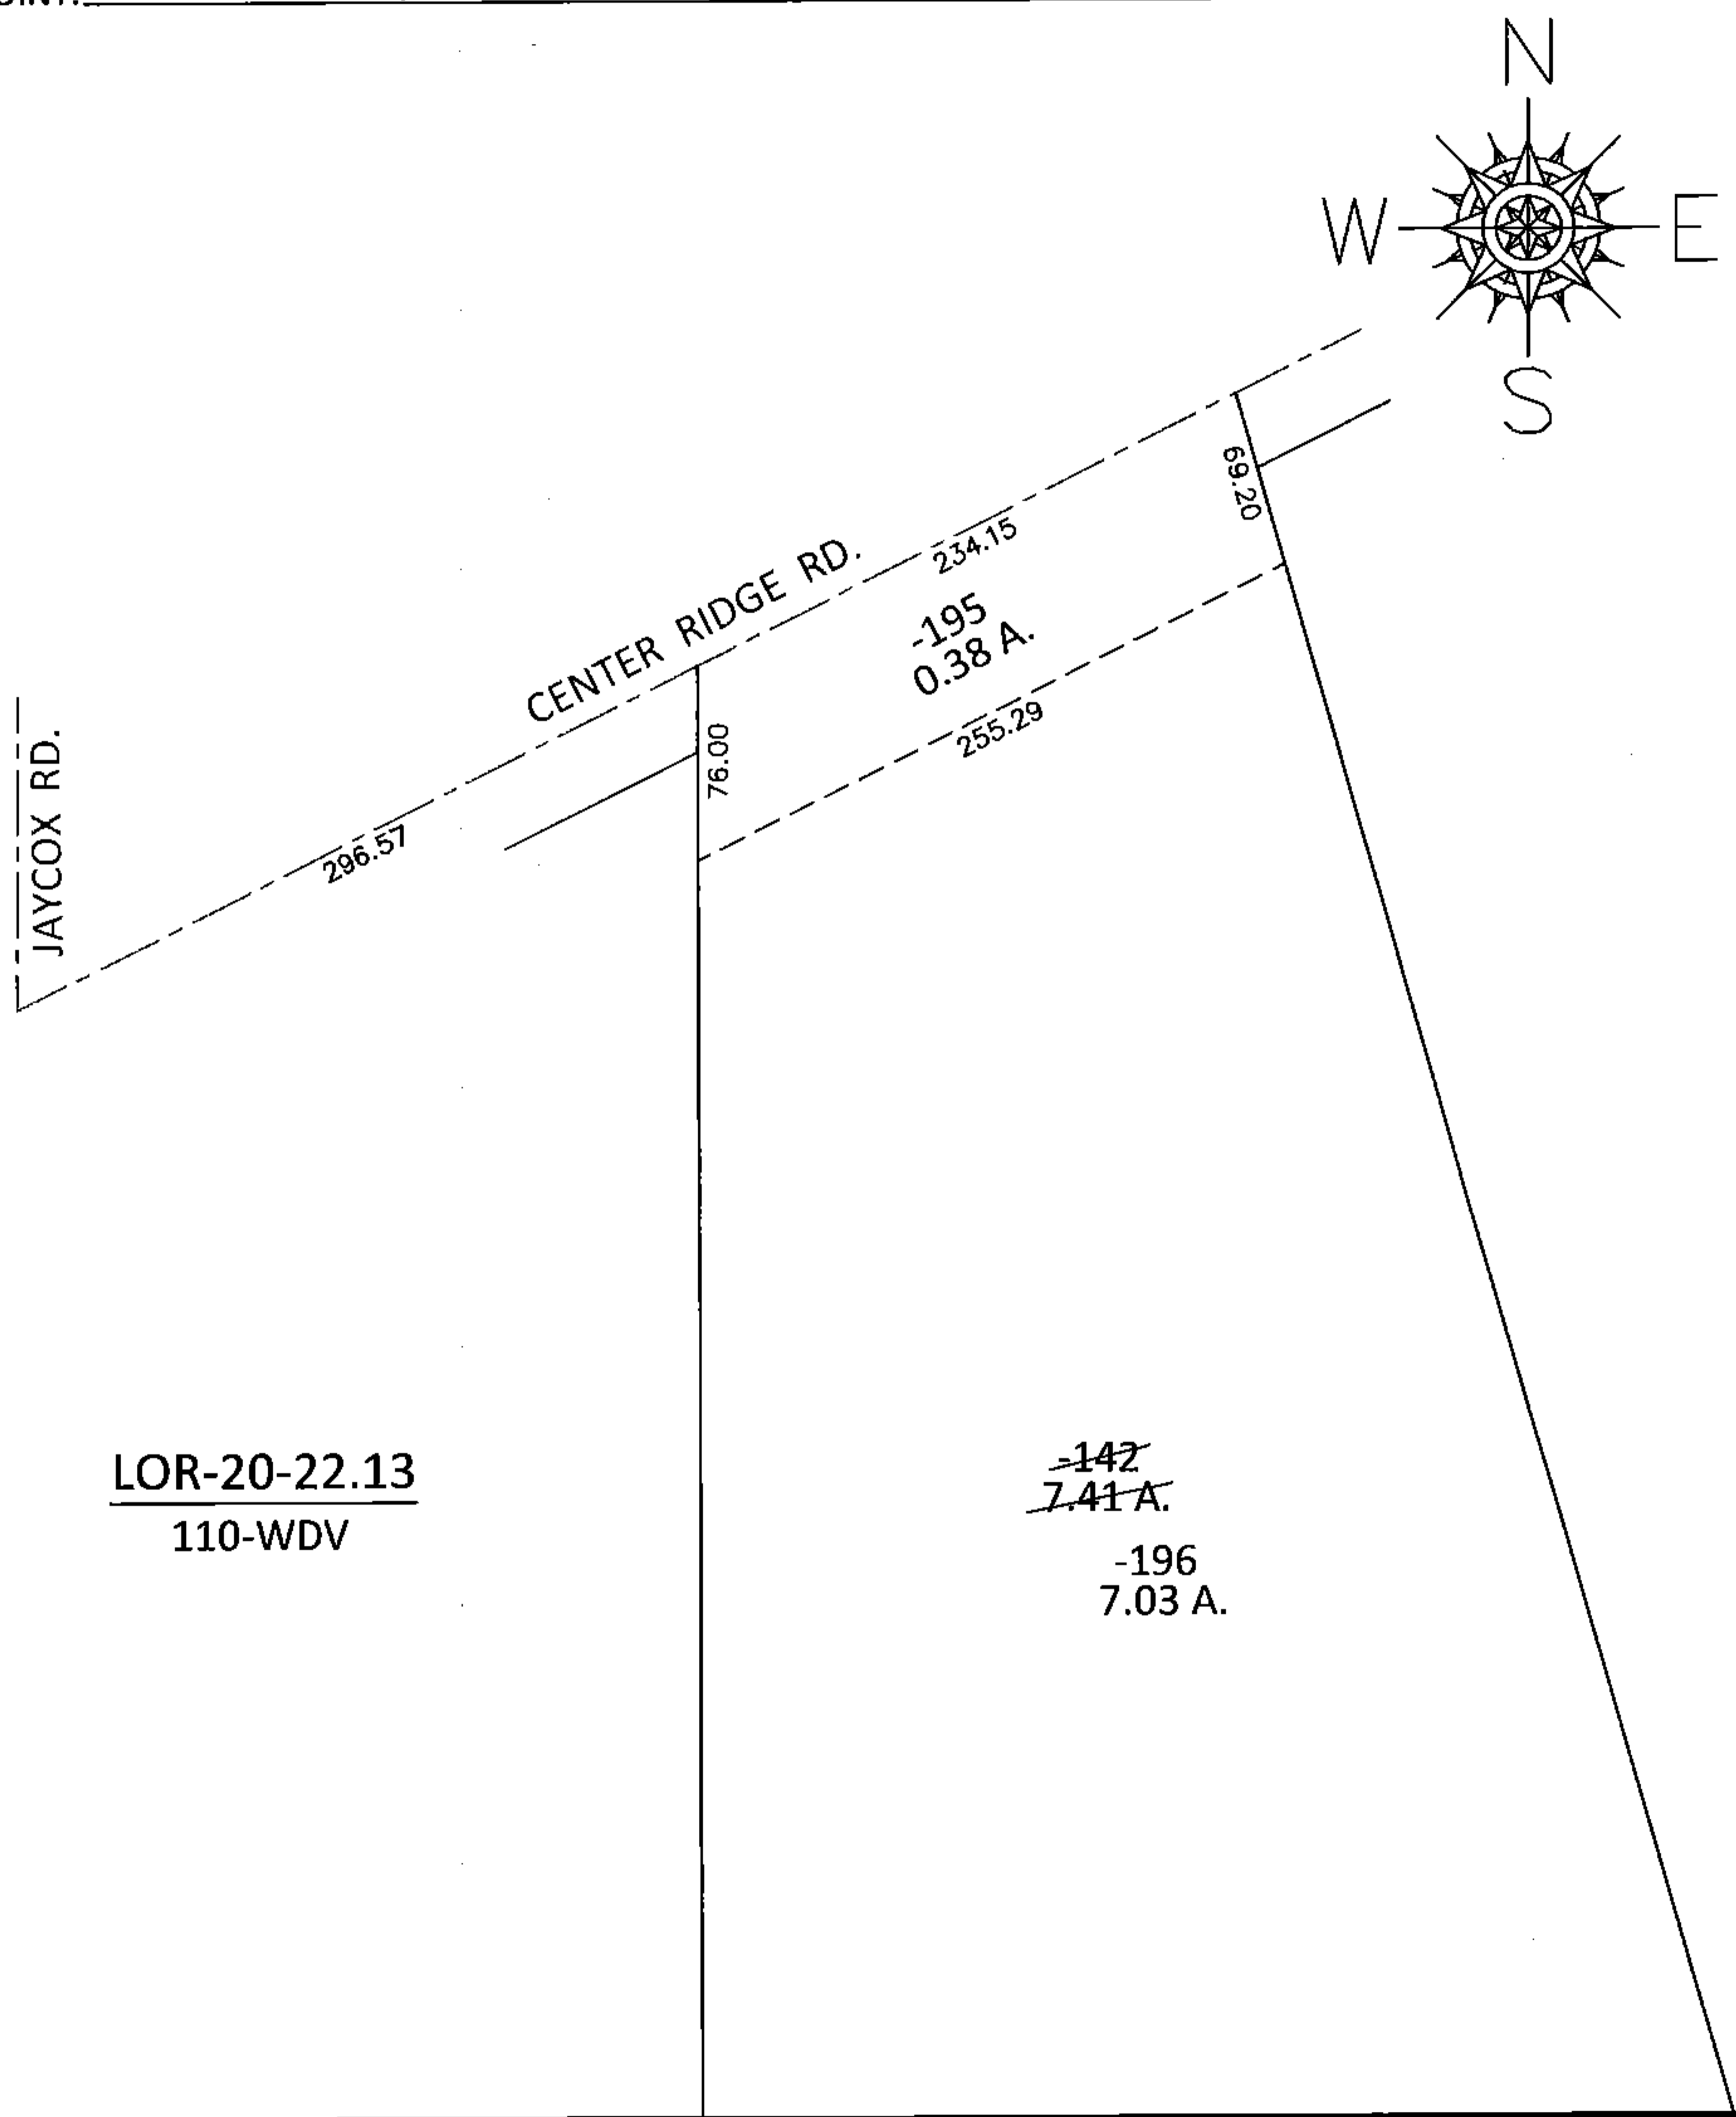

**SPLITS/DEEDS PROCESSED**  
LORAIN COUNTY TAX MAP DEPARTMENT  
226 MIDDLE AVE. ELYRIA, OHIO

SURVEYED BY: WILLIAM D. THOMAS  
CLOSURE: .00:10,000  
MAP PAGE(S): 7-00-016-A  
APPROVED BY: RRM DATE: 11-4-14  
SCALE: 1"= 100 PRIOR INST.: 20120404353