


PARENT PARCEL: 07-00-021-116-021


CHILD PARCEL: 07-00-021-116-052, -053

STARTING POINT: INTERSECTION OF C/L OF CENTER RIDGE RD. AND C/L OF JAYCOX RD.

14-00581

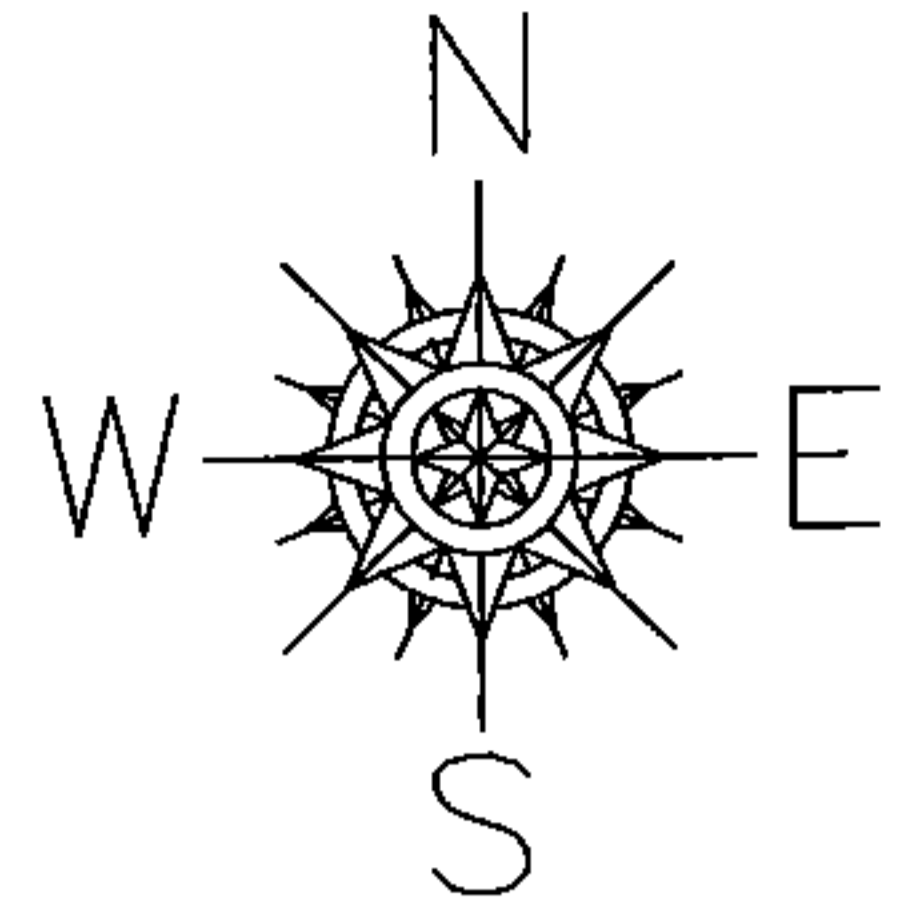

FOREST WOOD DR.

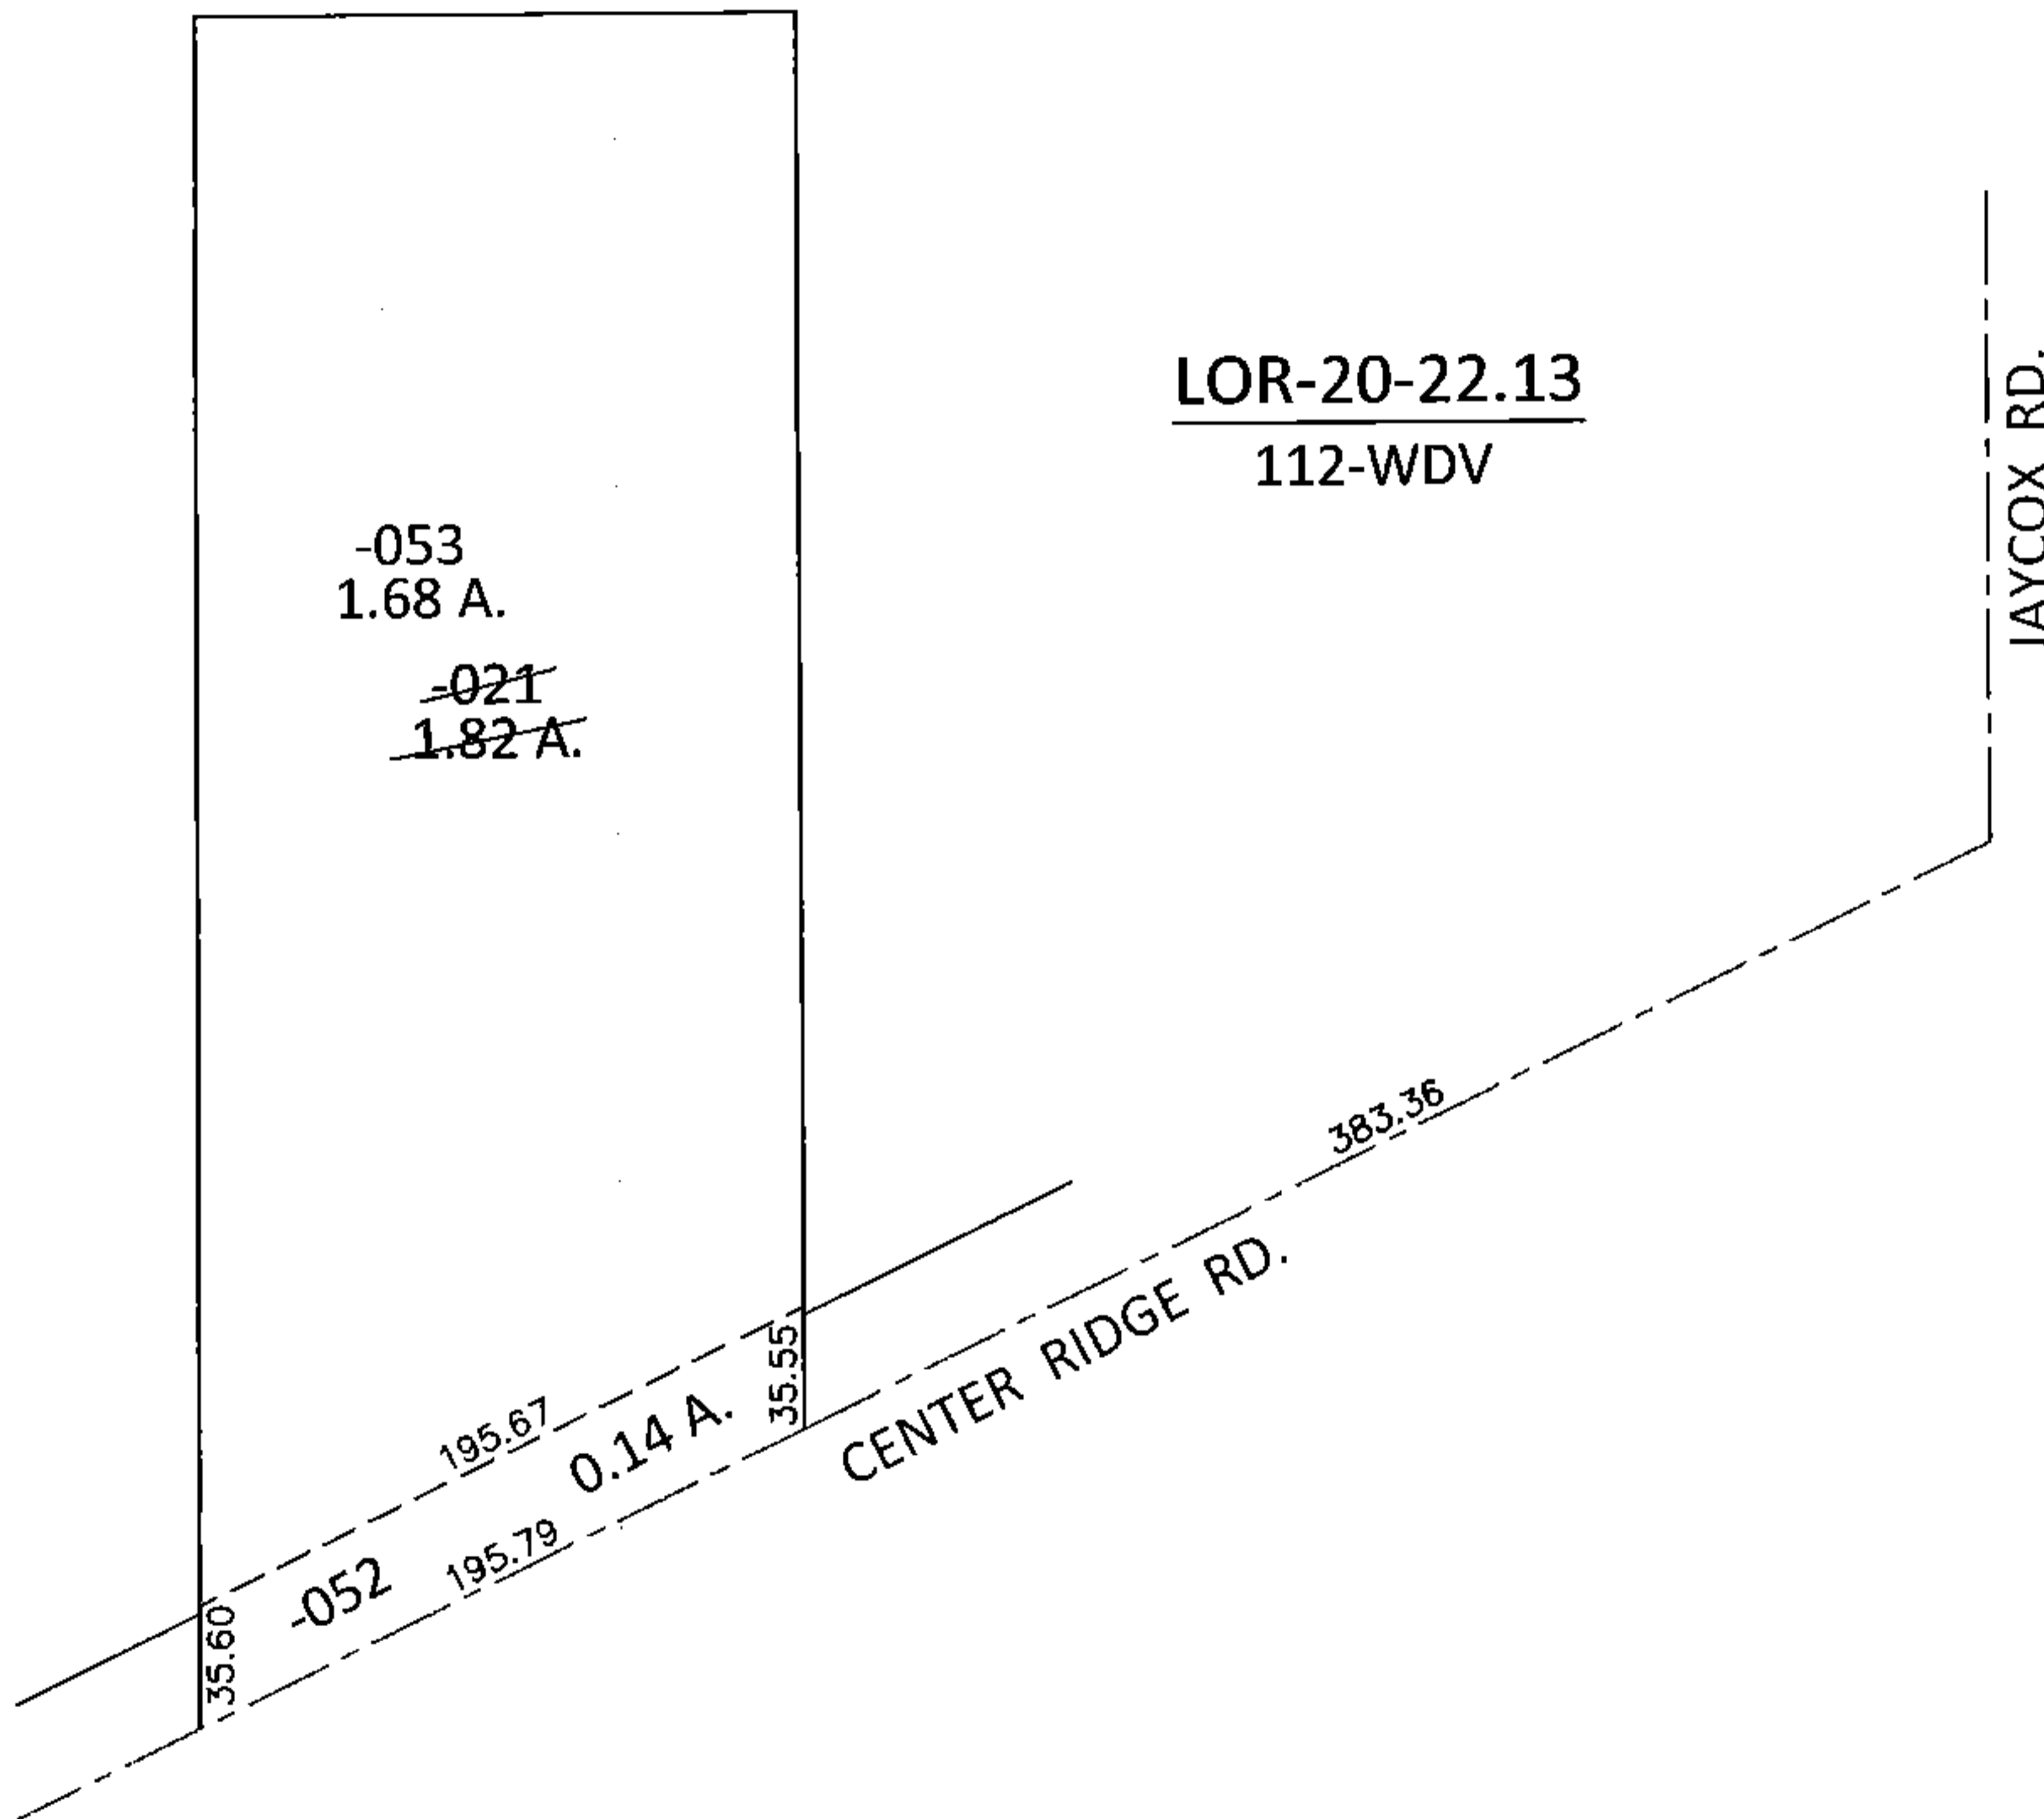


LOR-20-22.13
112-WDV

-053
1.68 A.

~~-021~~
~~1.82 A.~~

JAYCOX RD.

CENTER RIDGE RD.

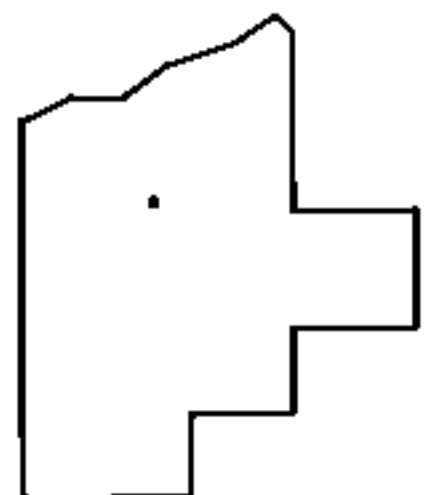

SPLITS/DEEDS PROCESSED

LORAIN COUNTY TAX MAP DEPARTMENT
226 MIDDLE AVE. ELYRIA, OHIO

SURVEYED BY: WILLIAM D. THOMAS

CLOSURE: .00:10,000

MAP PAGE(S): 7-00-021-B

APPROVED BY: RRM DATE: 11-4-14

SCALE: 1" = 100 PRIOR INST.: DV 1274/204