
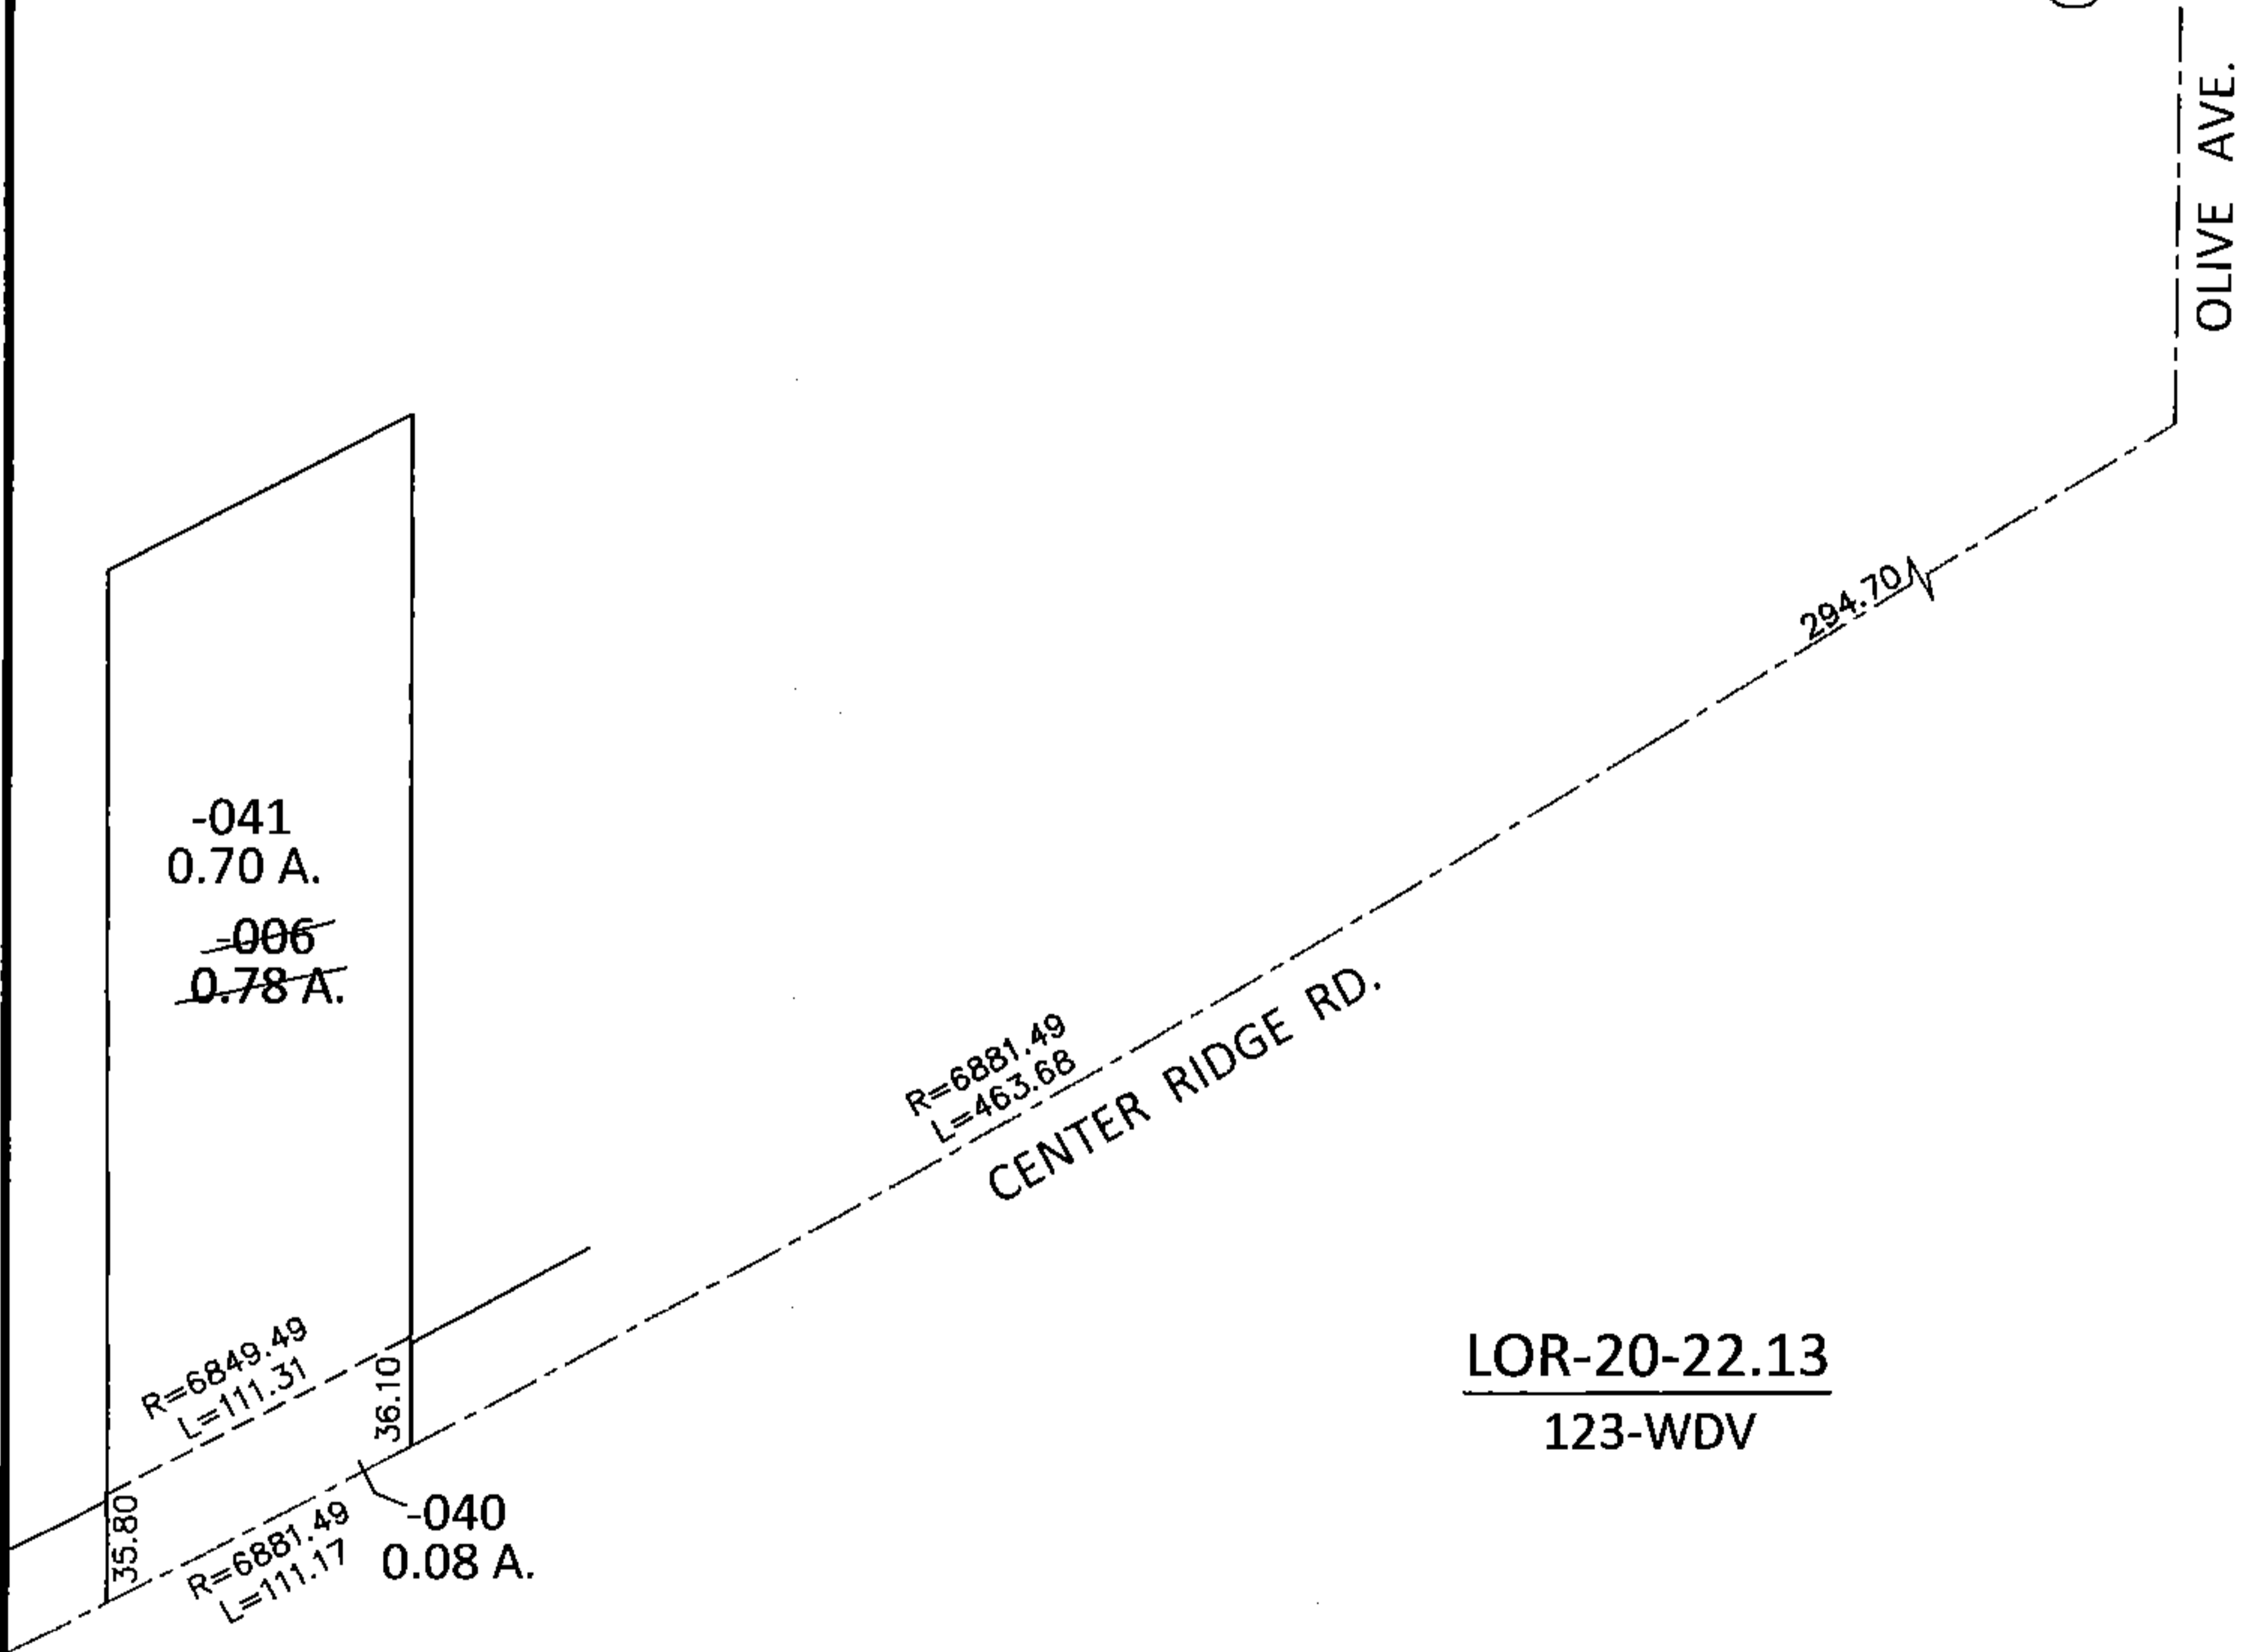


PARENT PARCEL: 07-00-016-101-006


CHILD PARCEL: 07-00-016-101-040, -041

STARTING POINT: INTERSECTION OF C/L OF CENTER RIDGE RD. AND C/L OF OLIVE AVE.

14-00590

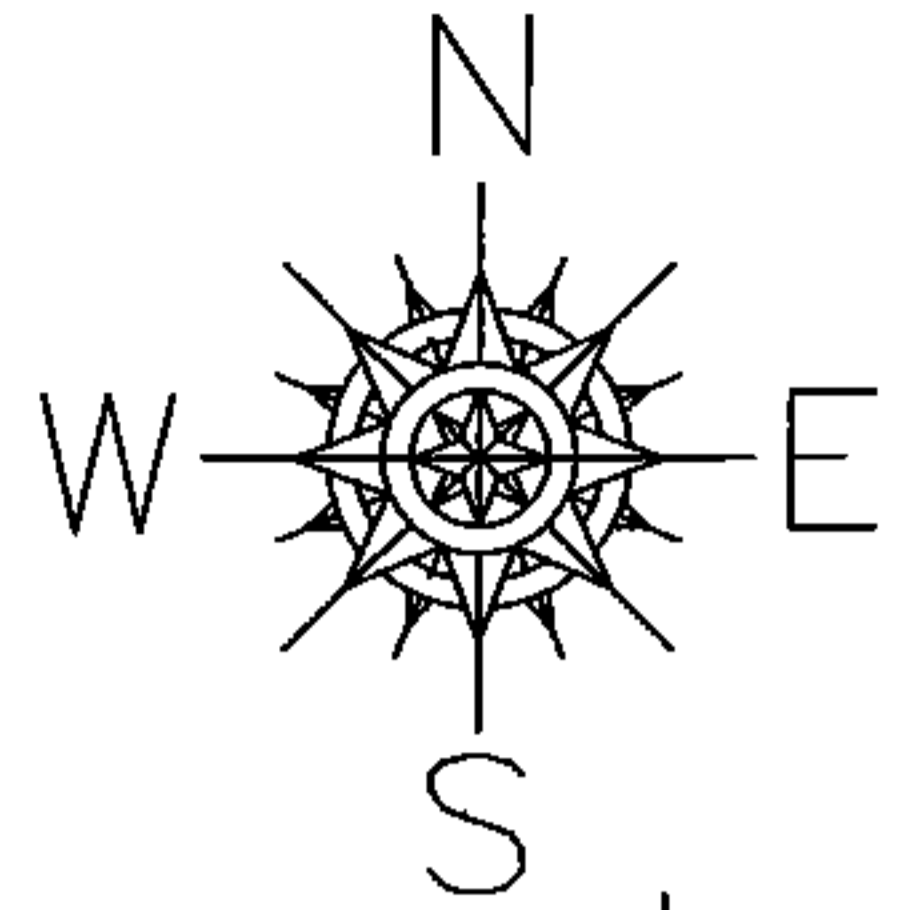

LOR-20-22.13  
123-WDV

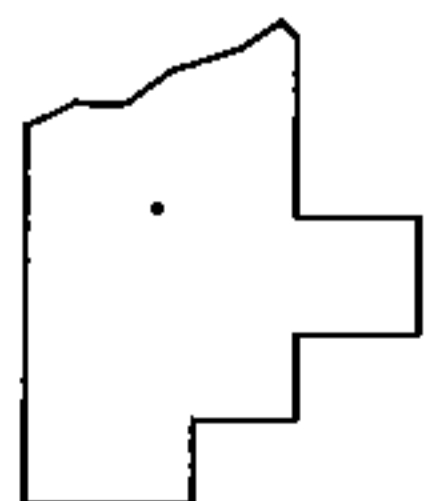

**SPLITS/DEEDS PROCESSED**

LORAIN COUNTY TAX MAP DEPARTMENT  
226 MIDDLE AVE. ELYRIA, OHIO

SURVEYED BY: WILLIAM D. THOMAS  
 CLOSURE: .01:10,000  
 MAP PAGE(S): 7-00-016-A  
 APPROVED BY: RRM DATE: 11-21-14  
 SCALE: 1"=100 PRIOR INST.: OR 989/472